


7131

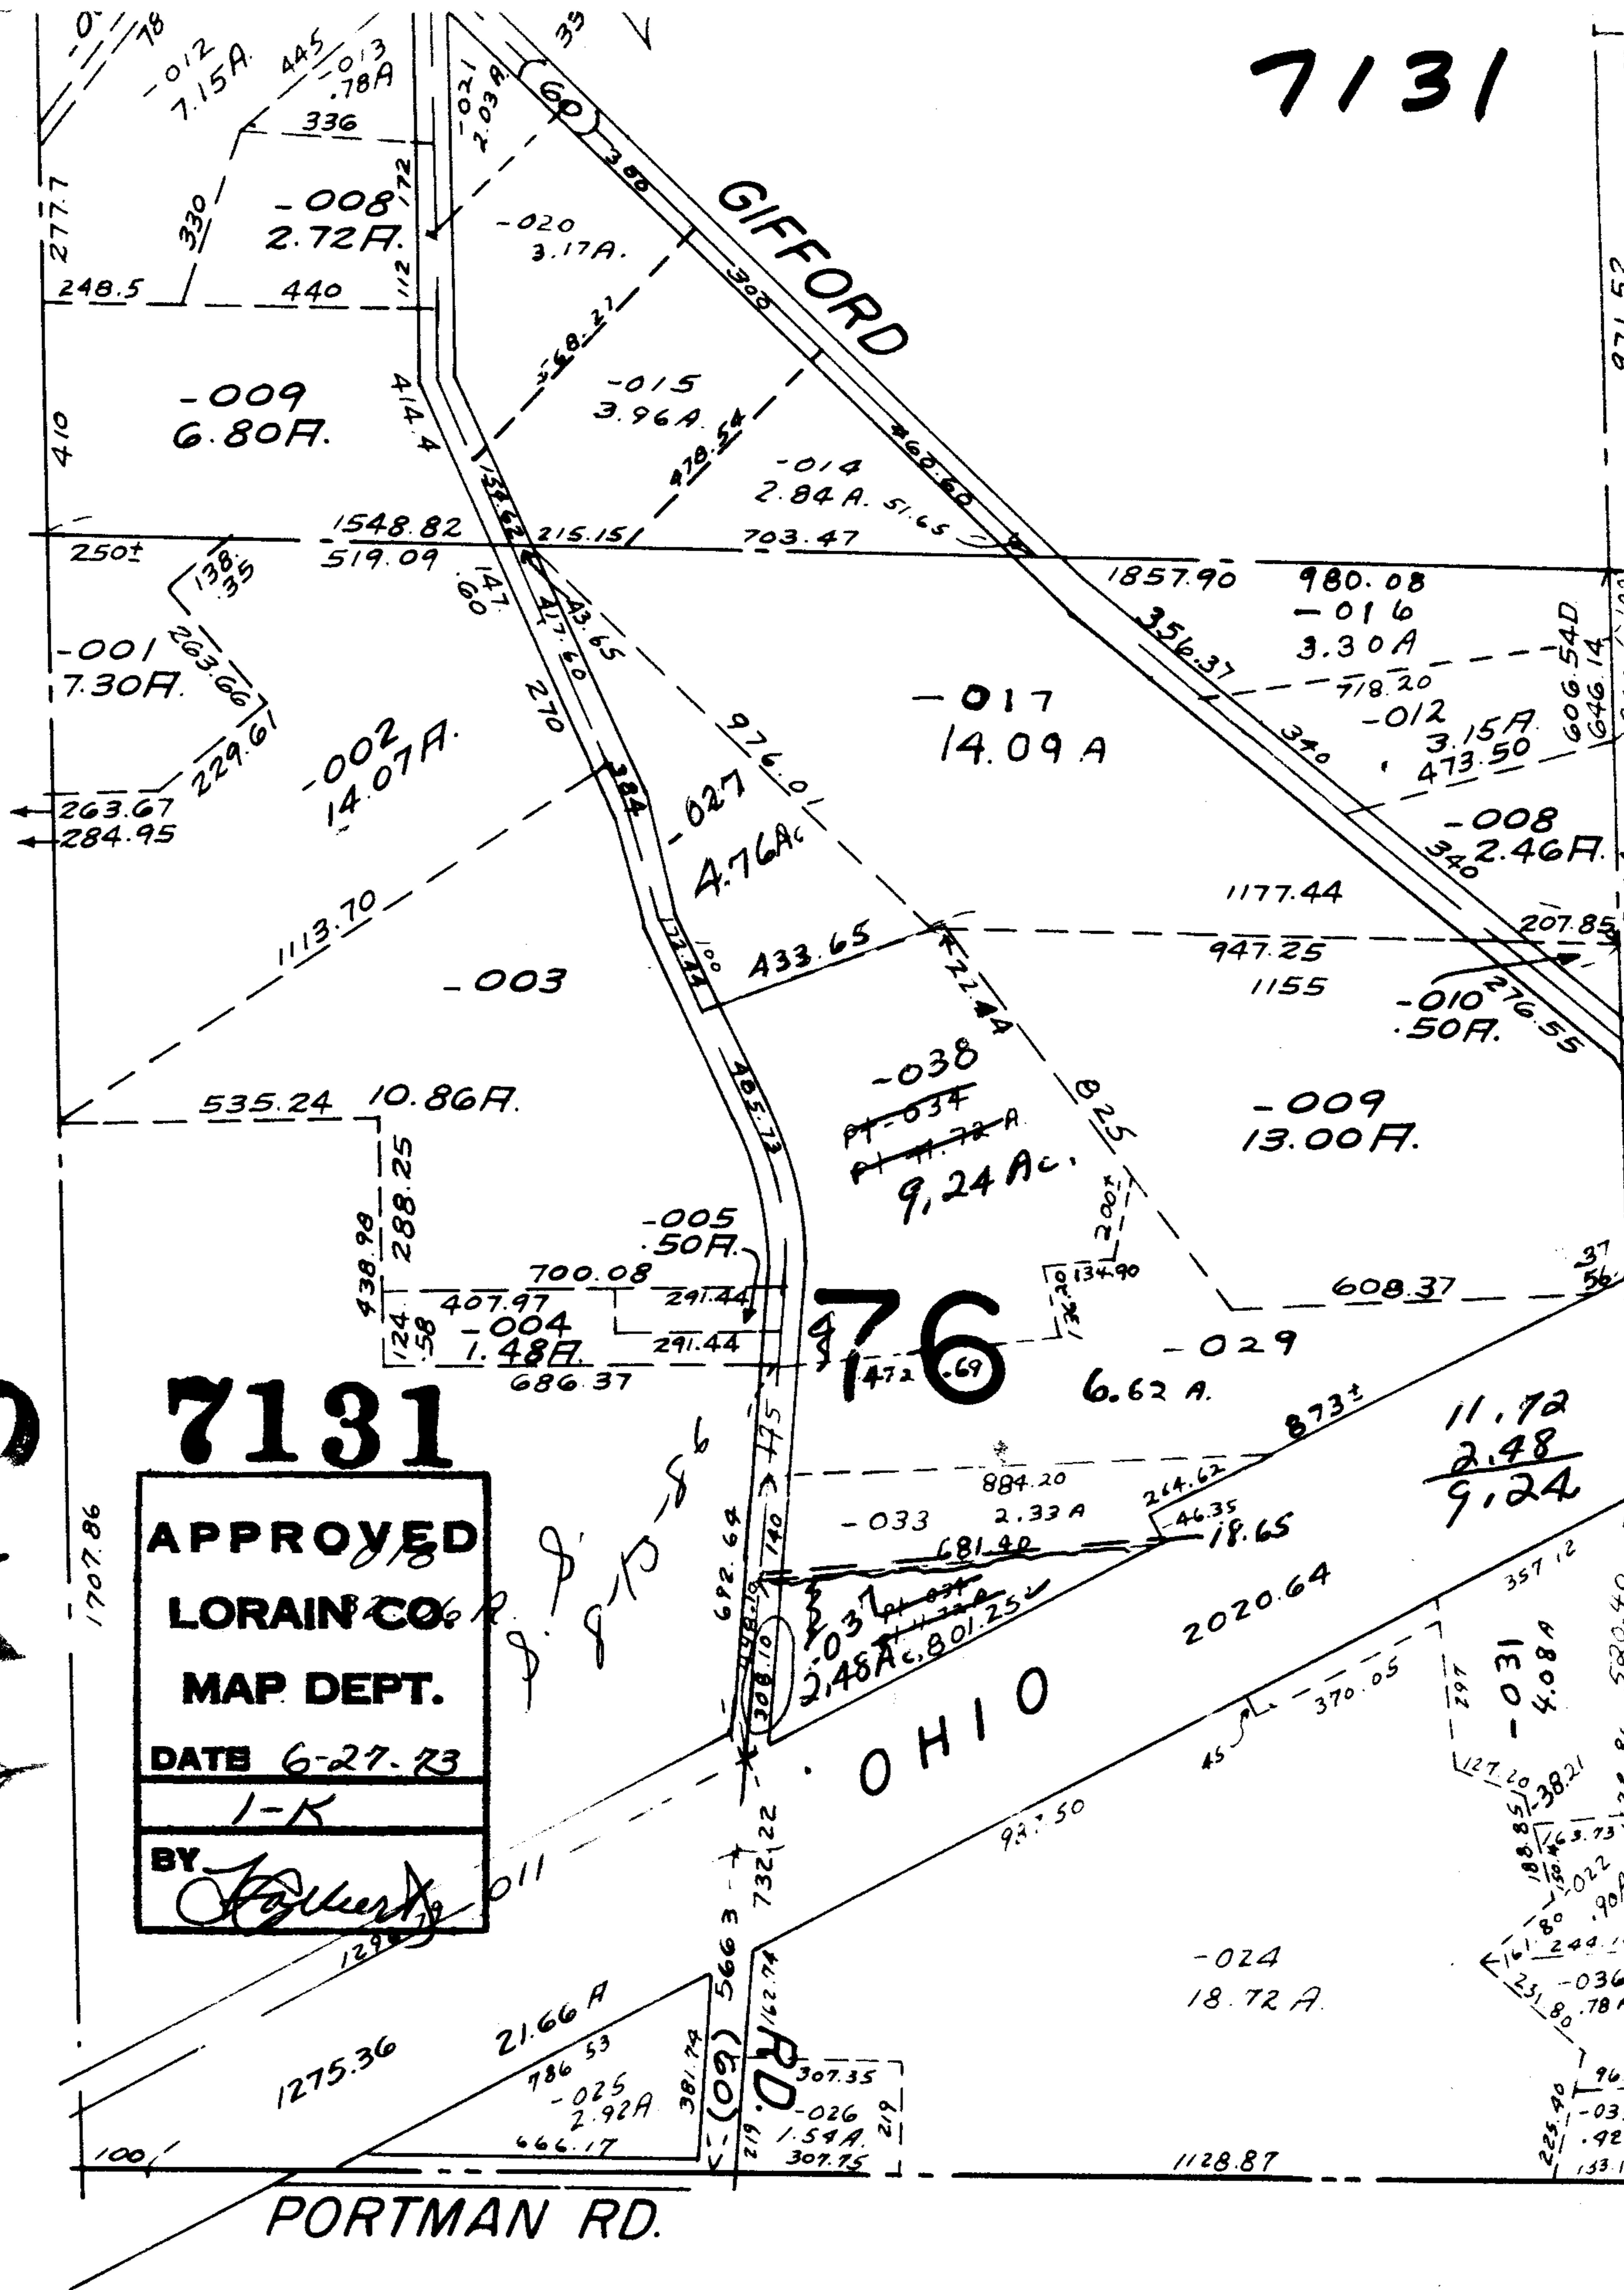

OK
PR2

7131
APPROVED
LORAIN CO.
MAP DEPT.
DATE 6-27-23
 1-K
 BY *[Signature]*

S.P. 8-15-56

76

PORTMAN RD.

RD. (60)

OHIO

971.52

606.54D
646.14

207.85
276.55

37
36

520.40

96
-031
4.08A

133.11