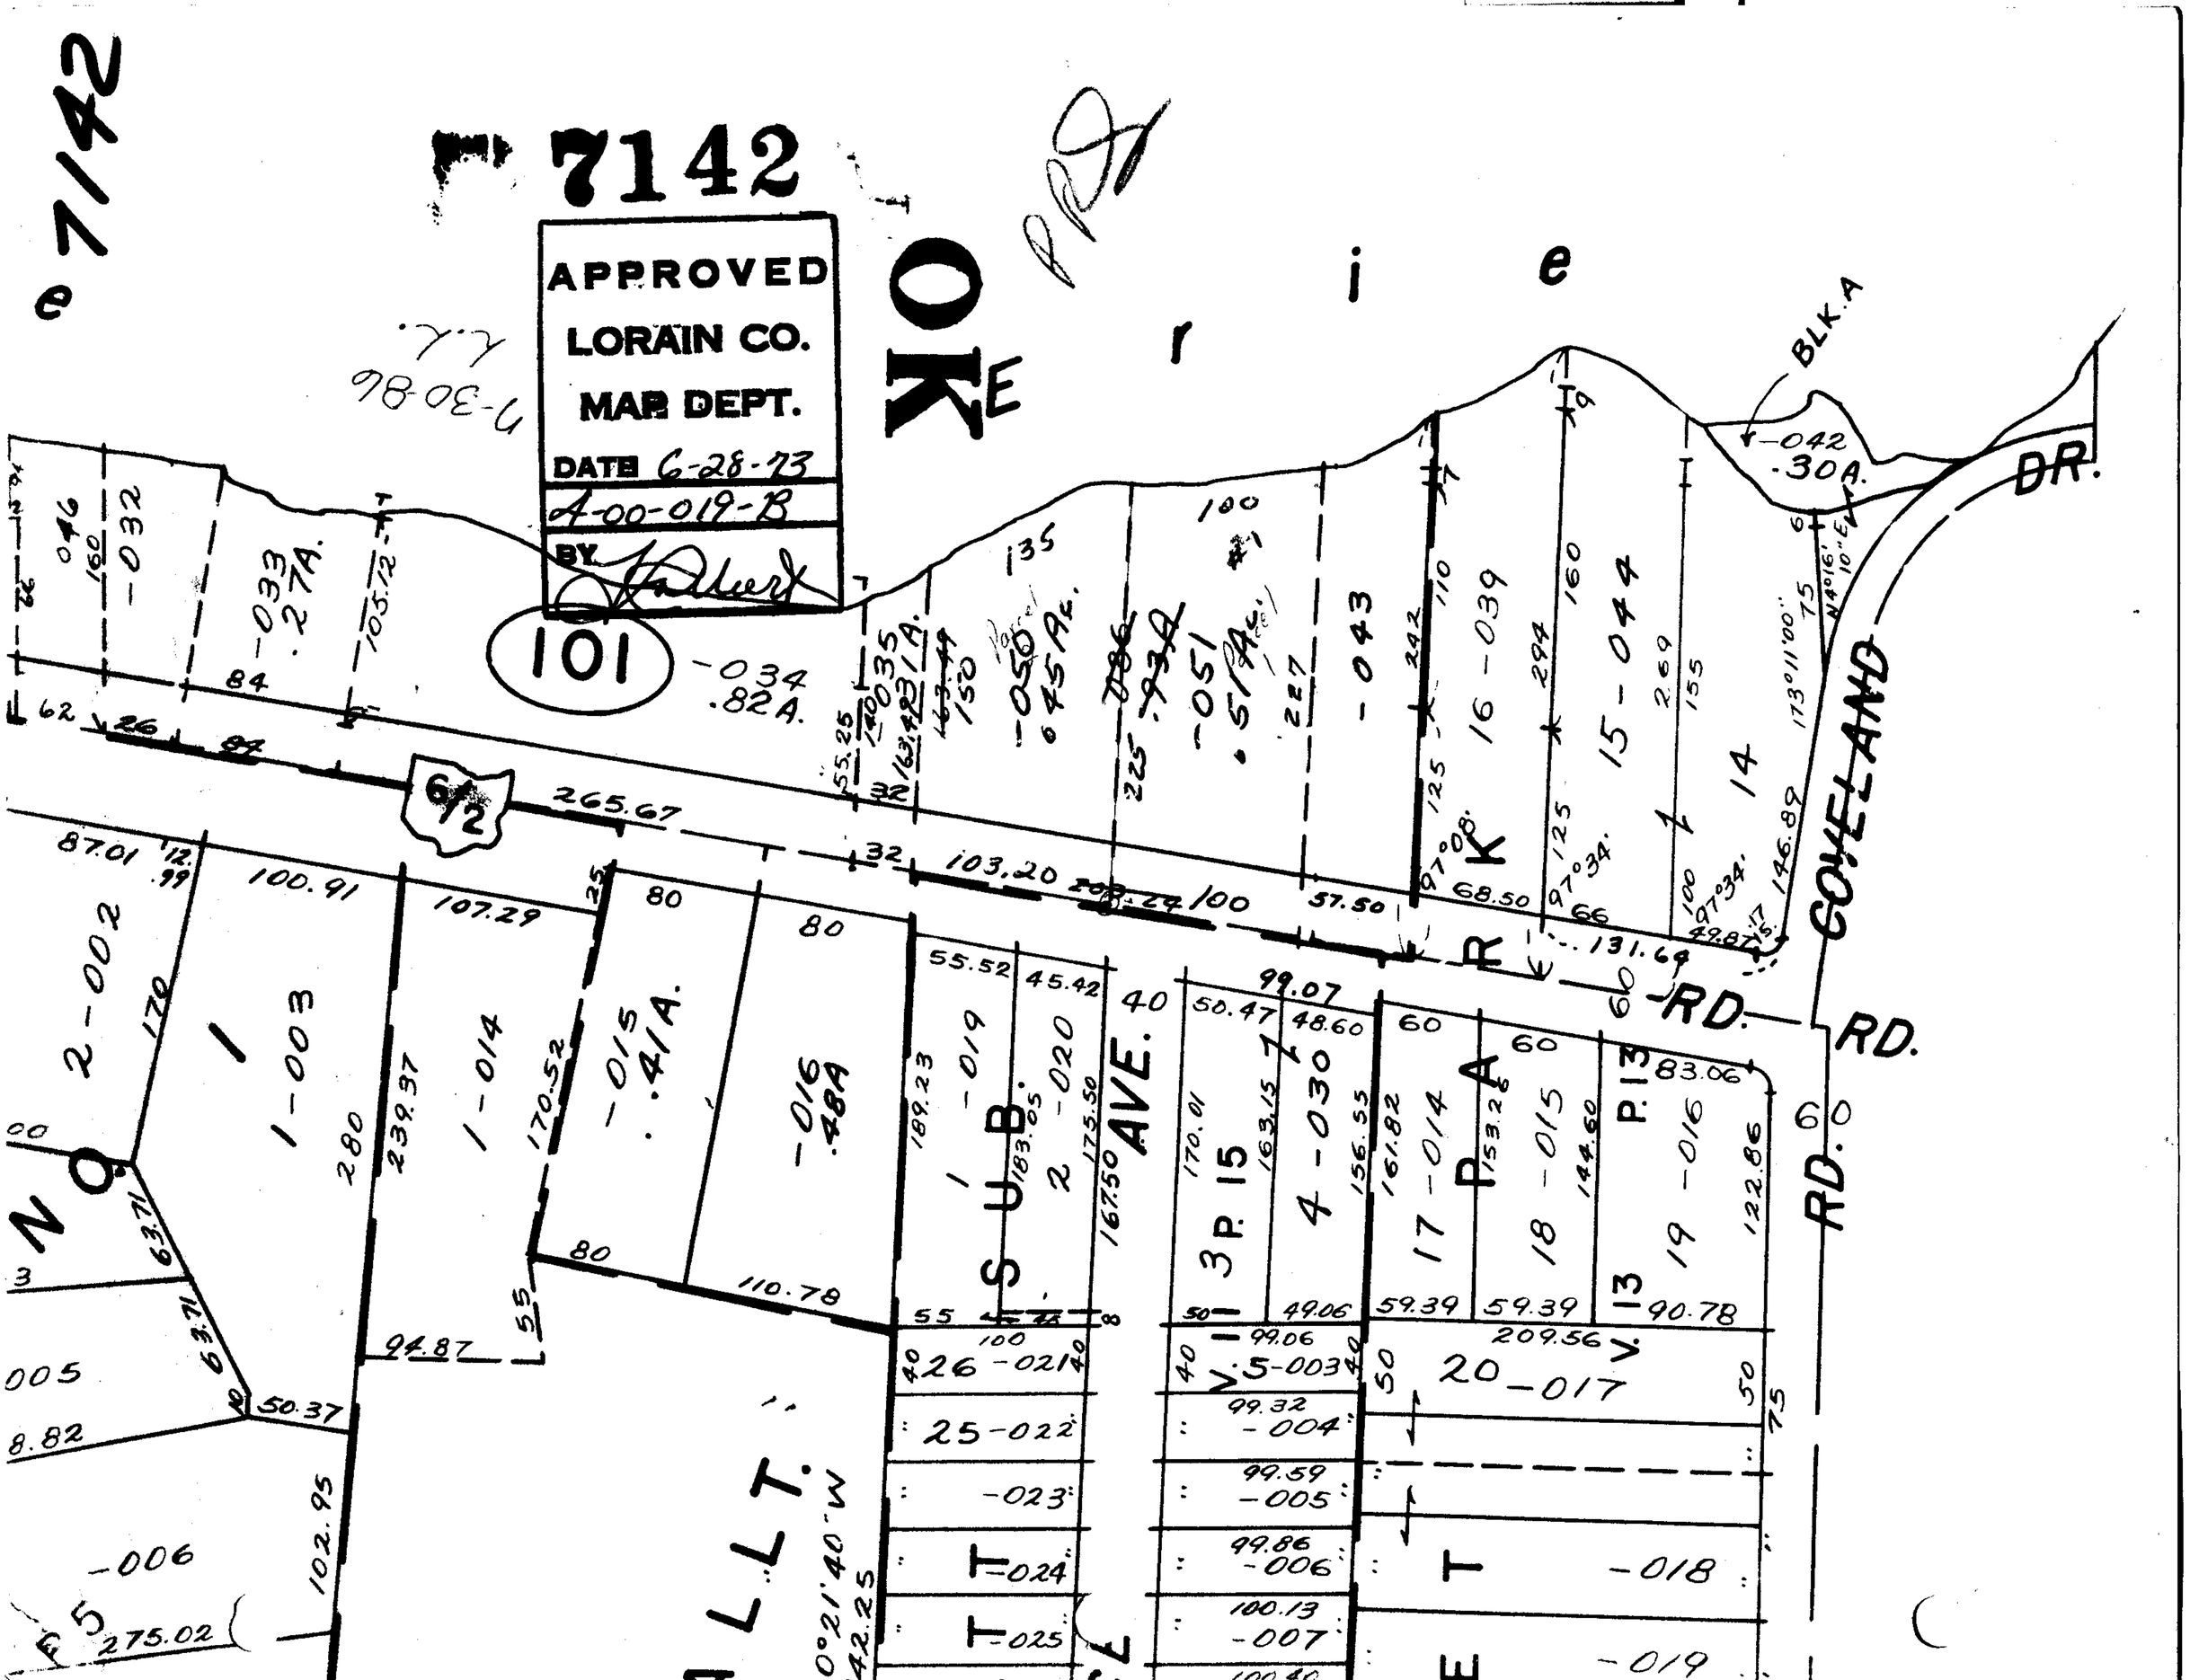
7142
APPROVED
LORAIN CO.
MAP DEPT.
DATE 6-28-73
4-00-019-B
BY
101
6/2
COVELAND
RD.
DR.
AVE.
SUB.
BLK. A
-042
.30A.
-034
.82A.
-033
.27A.
-032
-043
16-039
15-044
14
-050
.45A.
-051
.51A.
-015
.41A.
-016
.48A
1-003
1-014
2-002
-019
2-020
3 P. 15
4-030
17-014
18-015
19-016
P. 13
20-017
-018
-019
-004
-005
-006
-007
-021
-022
-023
-024
-025
-006
275.02
102.95
94.87
110.78
103.20
265.67
131.64
146.89
87.01
100.91
107.29
239.37
170.52
50.37
8.82
99.07
50.47
48.60
49.06
59.39
90.78
209.56
99.32
99.59
99.86
100.13
83.06
122.86
144.60
153.26
161.82
156.55
163.15
170.01
183.05
175.50
167.50
189.23
55.52
45.42
57.50
68.50
97°08'
97°34'
173°11'00"
N4°16'10"E
N0°21'40"W
42.25