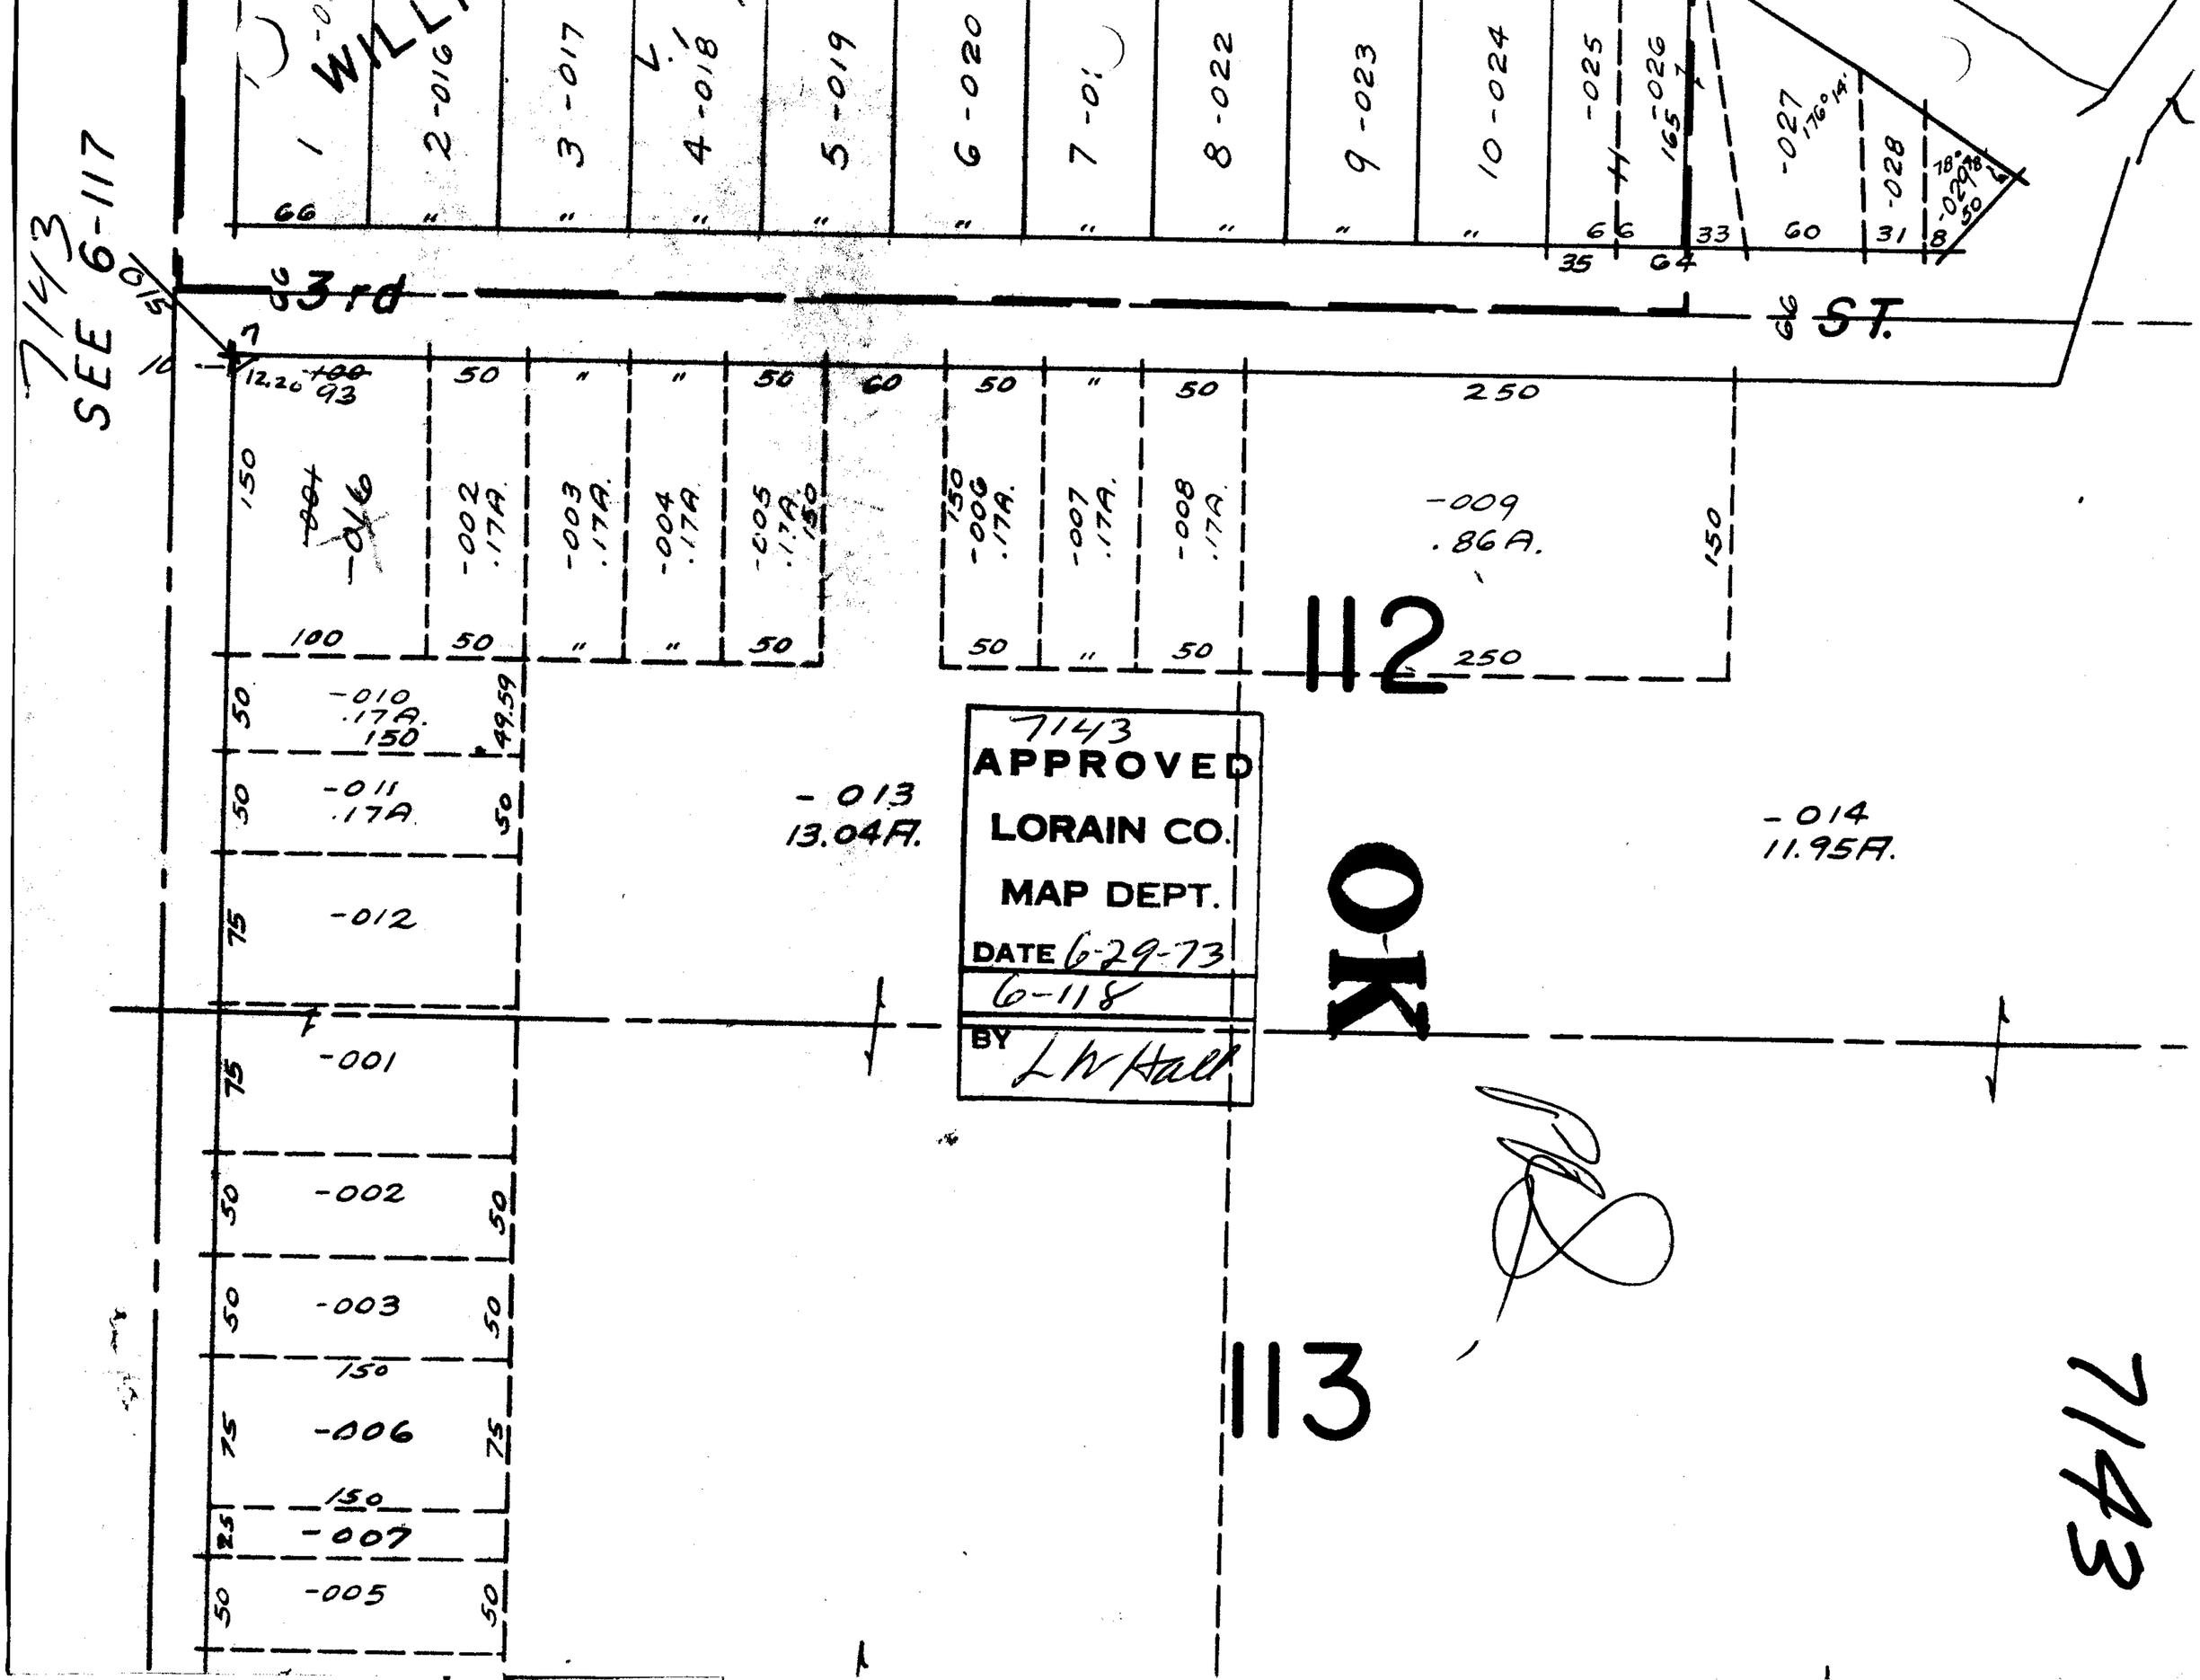

7143
SEE 6-117
WILL
3rd
ST.
112
113
OK
7143
APPROVED
LORAIN CO.
MAP DEPT.
DATE 6-29-73
6-118
BY L W Hall
-013
13.04A.
-014
11.95A.
-009
.86A.
-010
.17A.
-011
.17A.
-012
-001
-002
-003
-006
-007
-005