

VILLAGE
PGS. 16-17-18-19

7/150
OR 1/2
PHAS

(103)

(106)

C-M-OK

PRD

BLOCK S

-127

3.76 A.


Pg. 15-00-099-B

LAKE FT

EAST

STABLE

BLOCK W -168 .76 A.

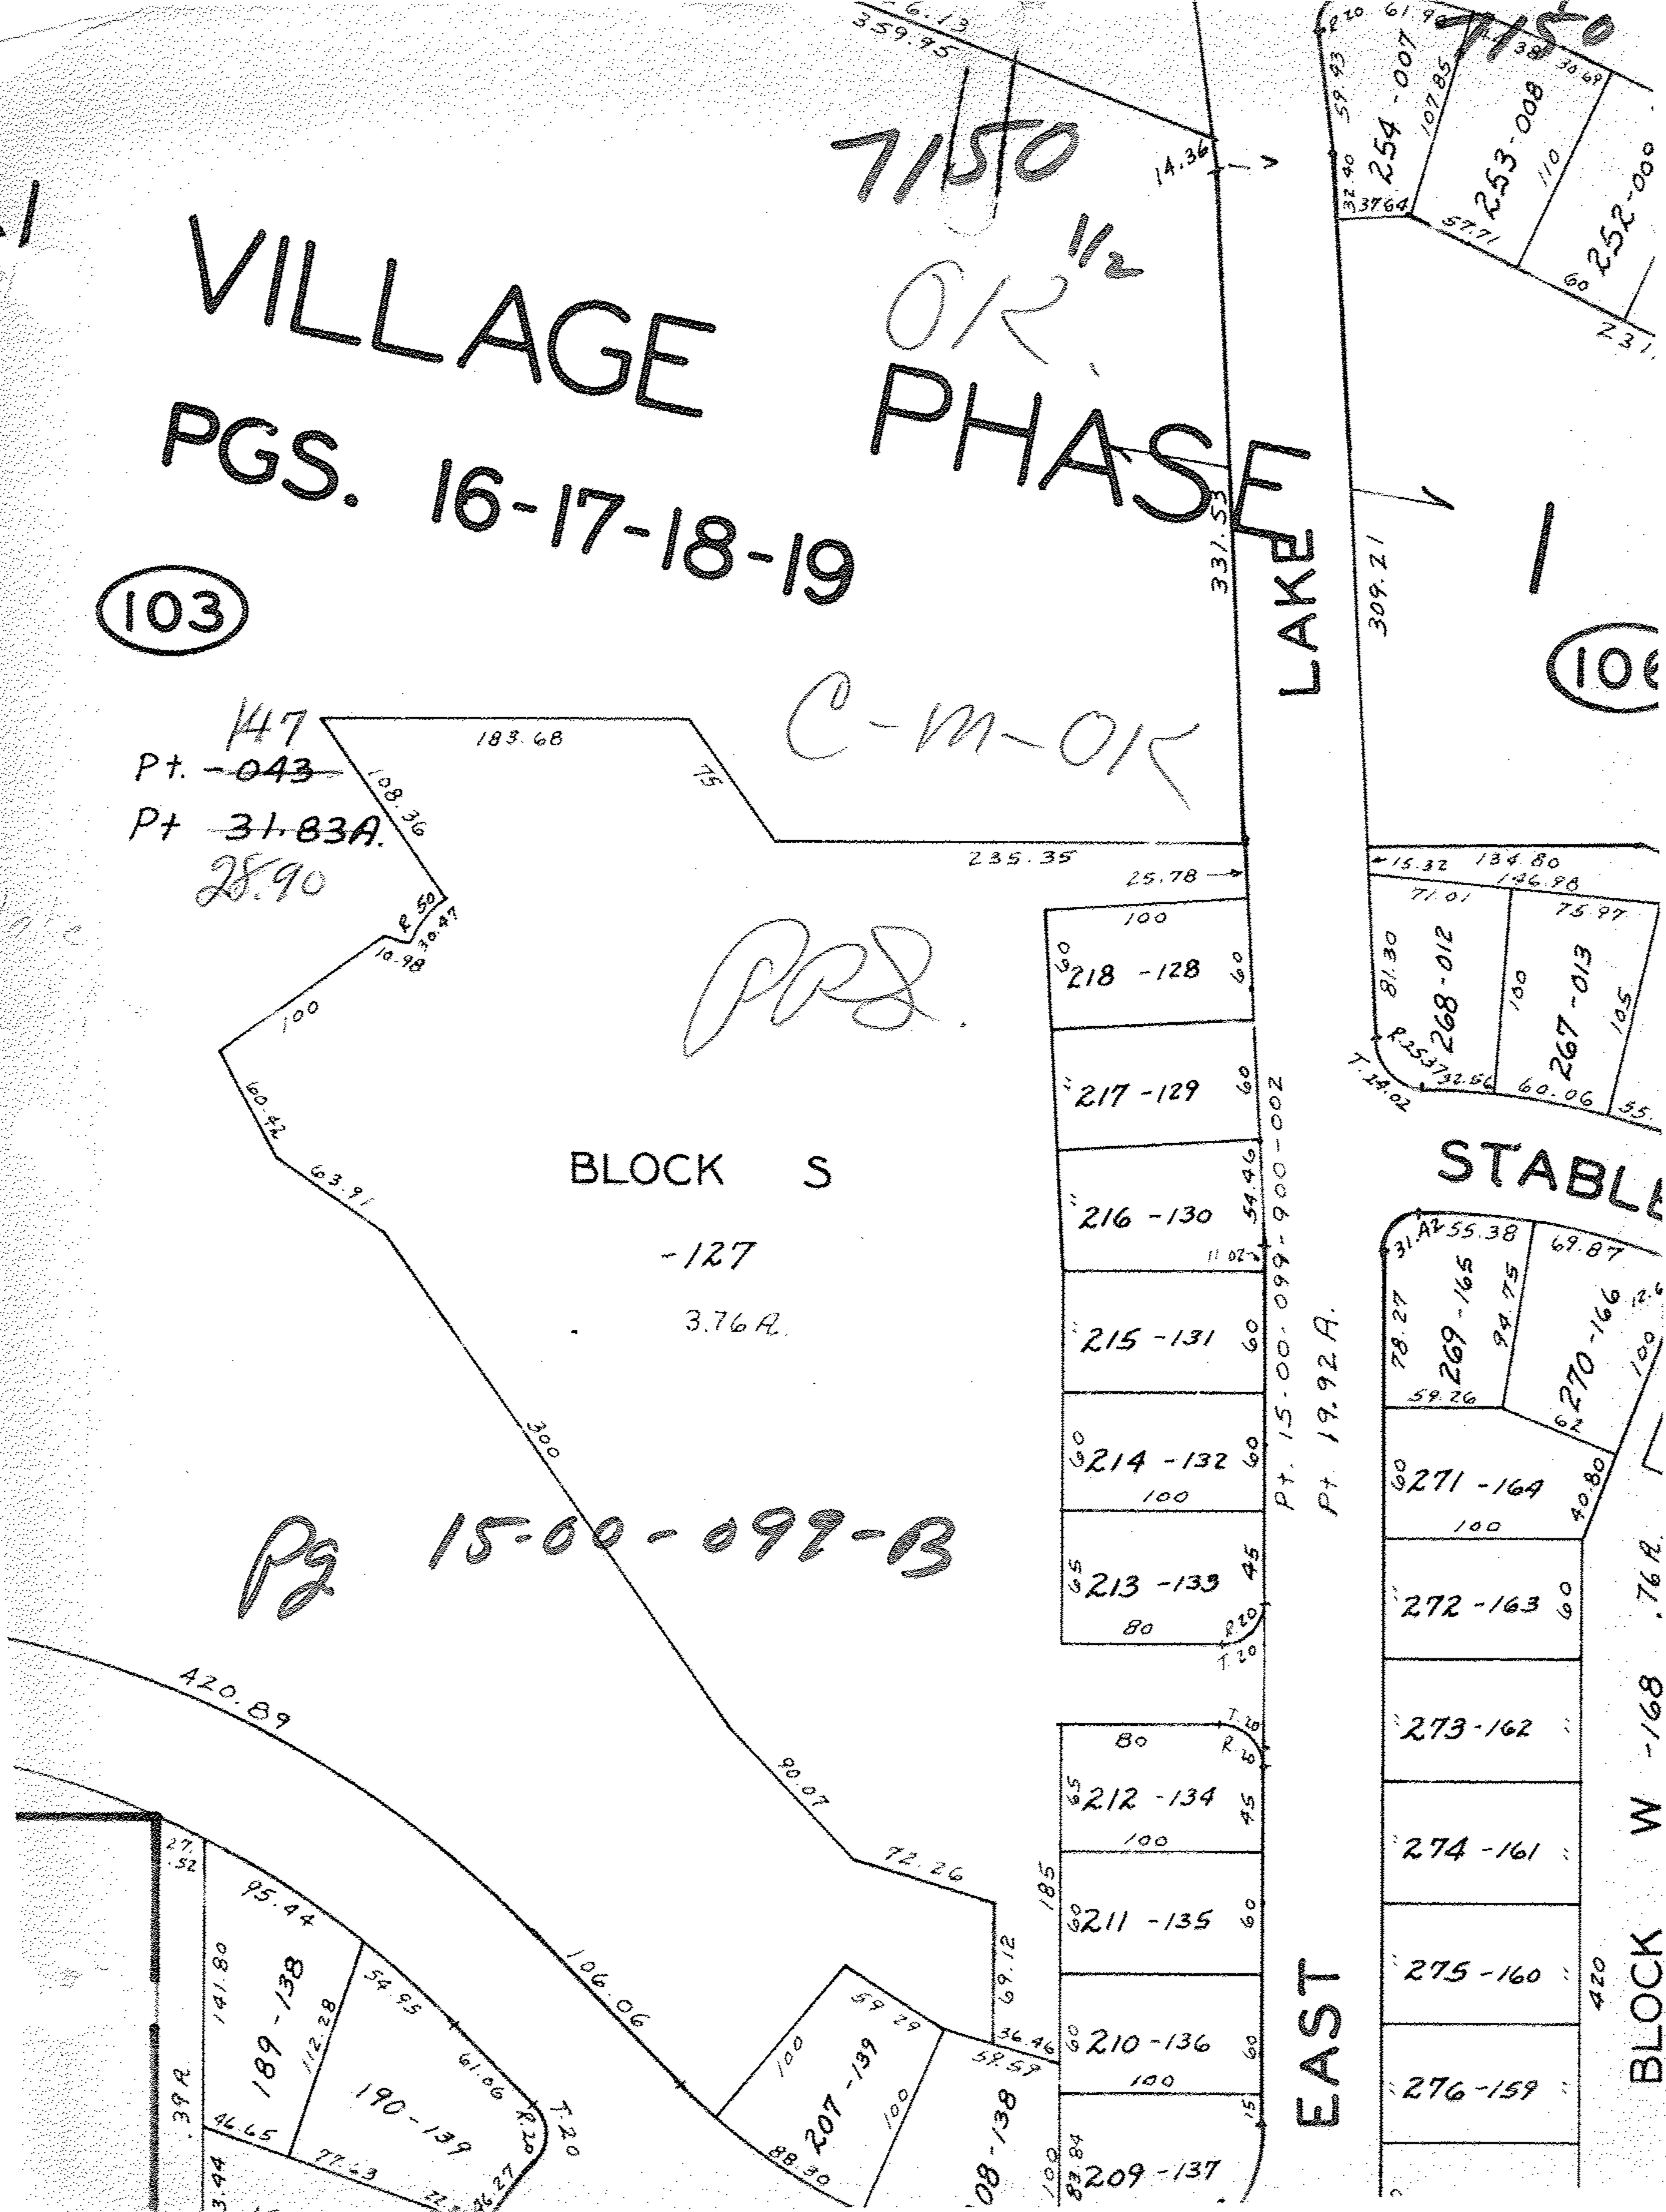

147
Pt. ~~043~~
Pt. 31.83A.
28.90

- 100 218 -128 60
- 100 217 -129 60
- 100 216 -130 54.46
- 100 215 -131 60
- 100 214 -132 60
- 80 213 -133 45
- 80 212 -134 45
- 60 211 -135 60
- 100 210 -136 60
- 100 209 -137

- 100 268 -012 75.97
- 100 267 -013 105

- 100 270 -166 100
- 100 271 -164 40.80
- 60 272 -163 60
- 273 -162
- 274 -161
- 275 -160
- 276 -159