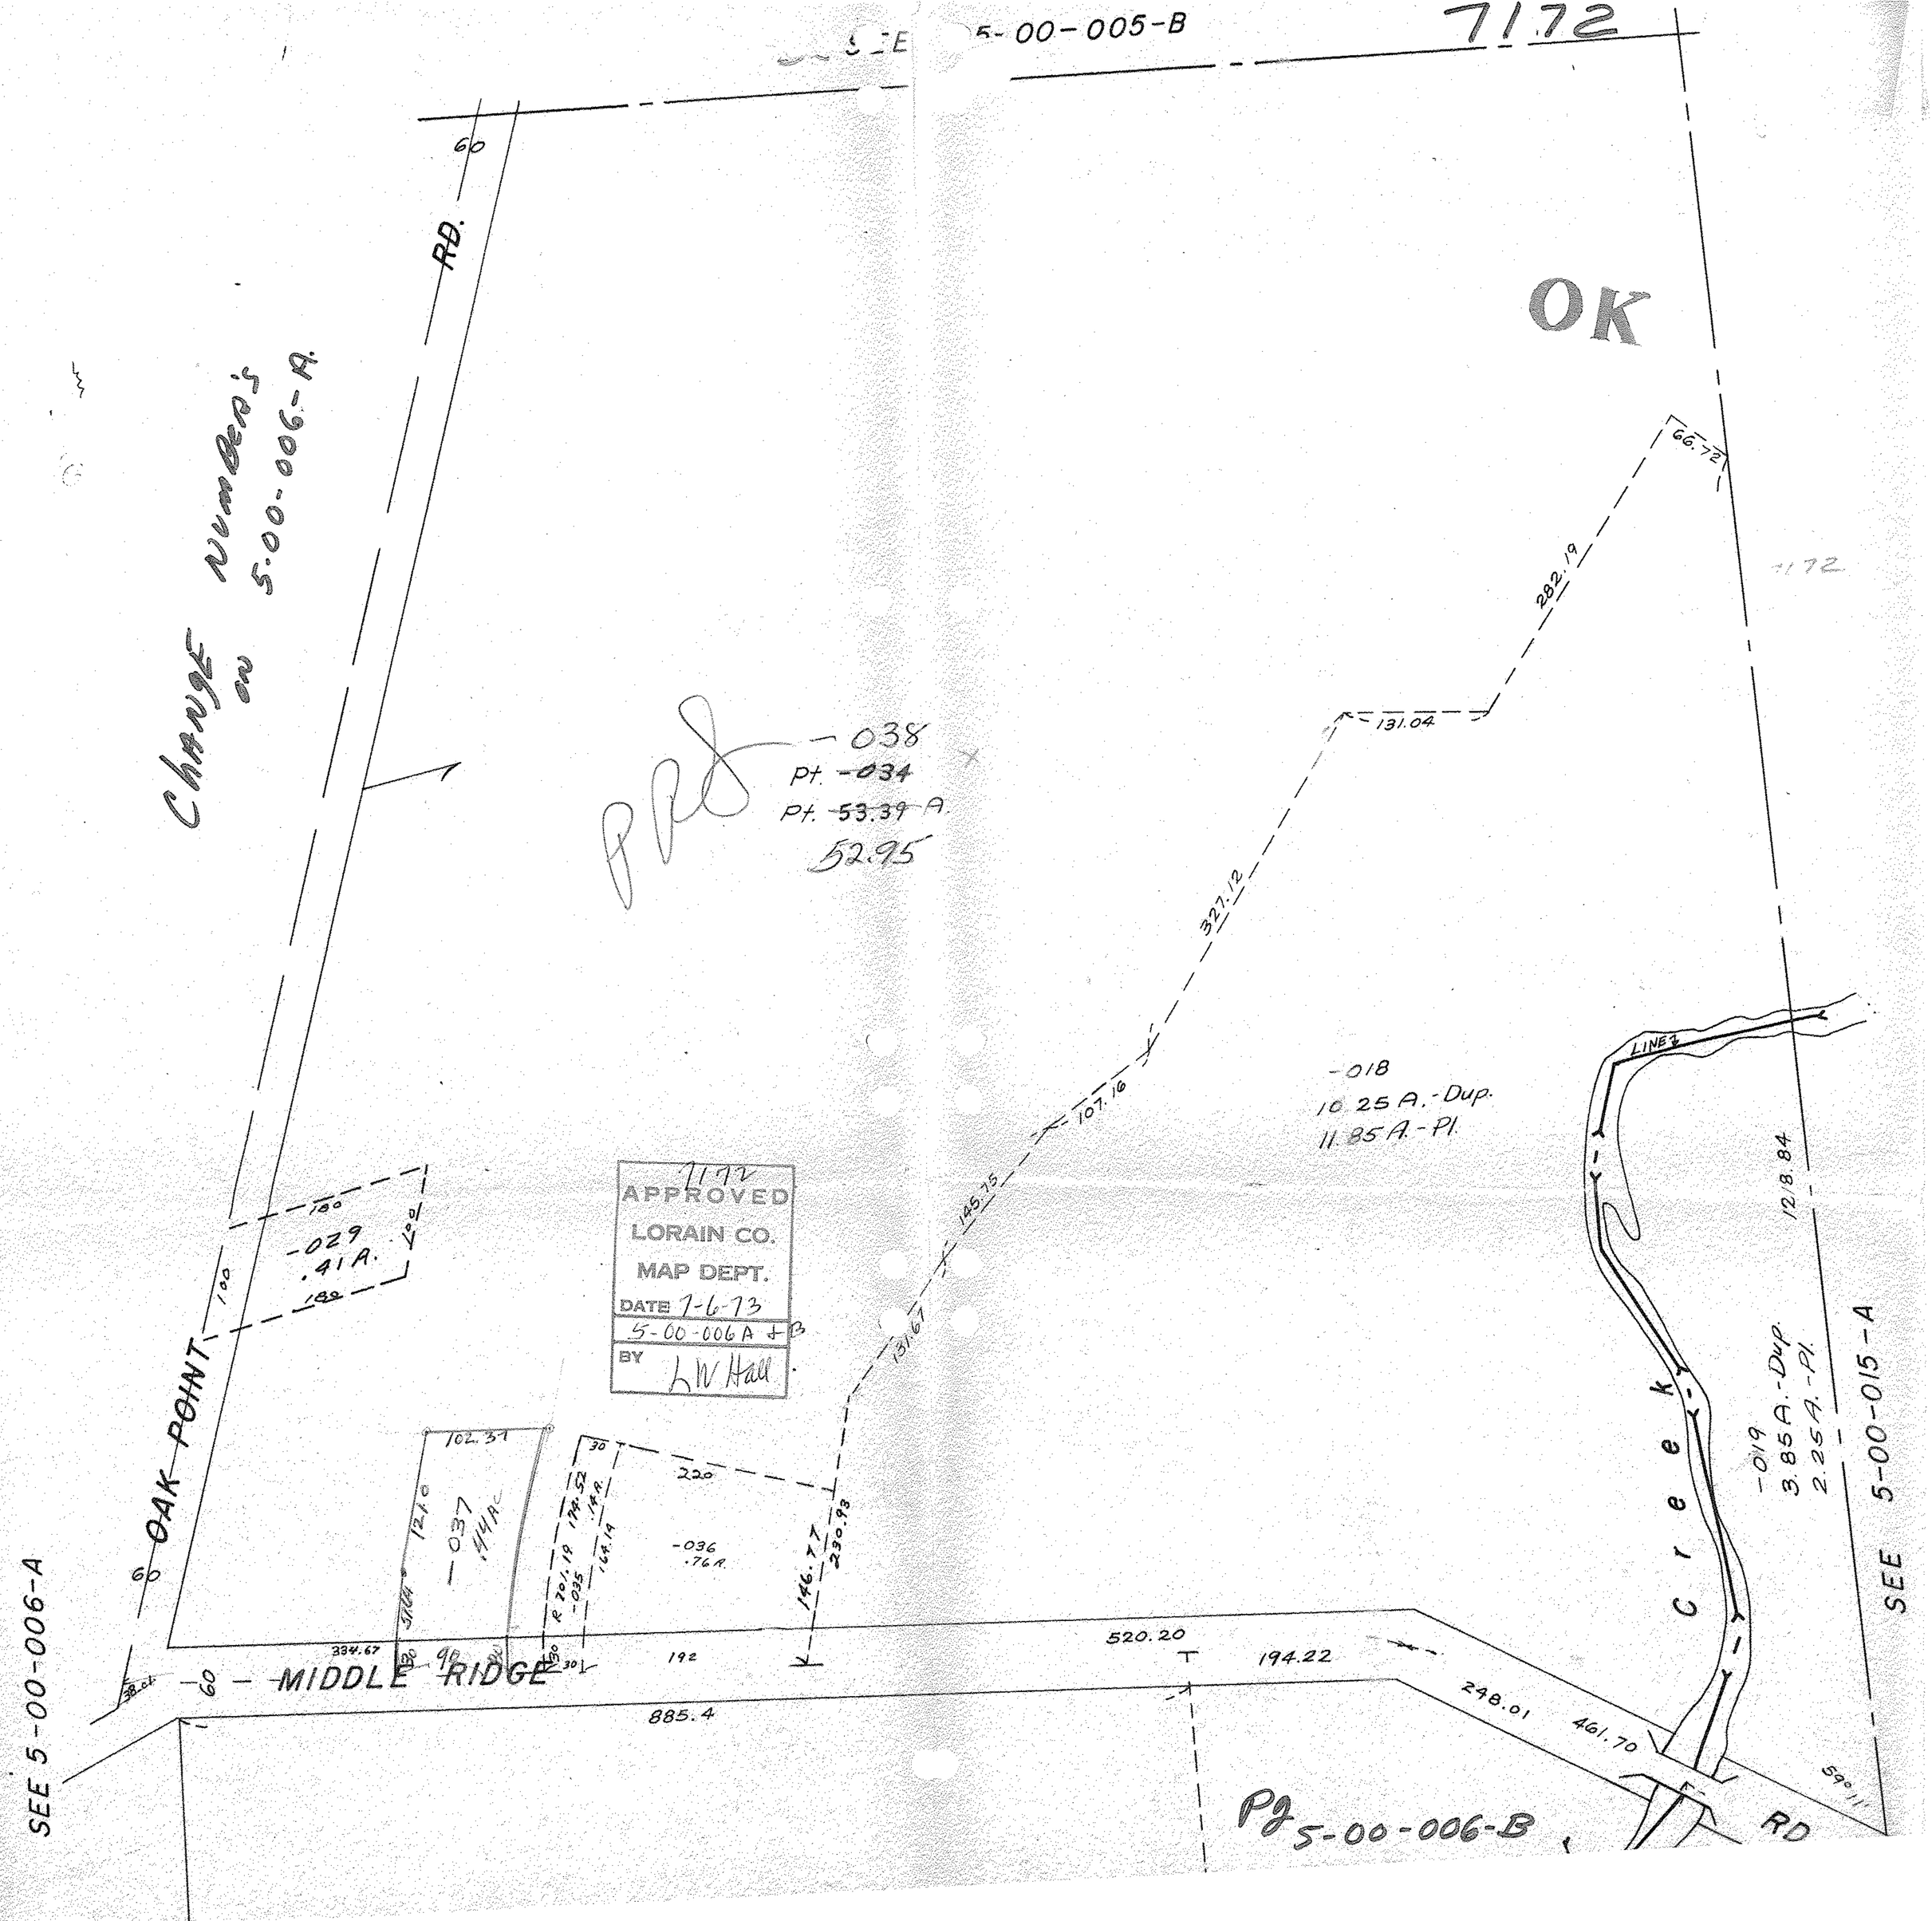

SEE 5-00-005-B
7172
OK
RD.
Change Number's on 5-00-006-A.
-038
Pt. -034
Pt. 53.39 A.
52.95
-018
10.25 A.-Dup.
11.85 A.-Pl.
7172
APPROVED
LORAIN CO.
MAP DEPT.
DATE 7-6-73
5-00-006 A + B
BY LW Hall
-029
.41 A.
OAK POINT
-037
.44 Ac
-036
.76 A.
MIDDLE RIDGE
SEE 5-00-006-A
SEE 5-00-015-A
Creek
-019
3.85 A.-Dup.
2.25 A.-Pl.
LINE
Pg 5-00-006-B
RD