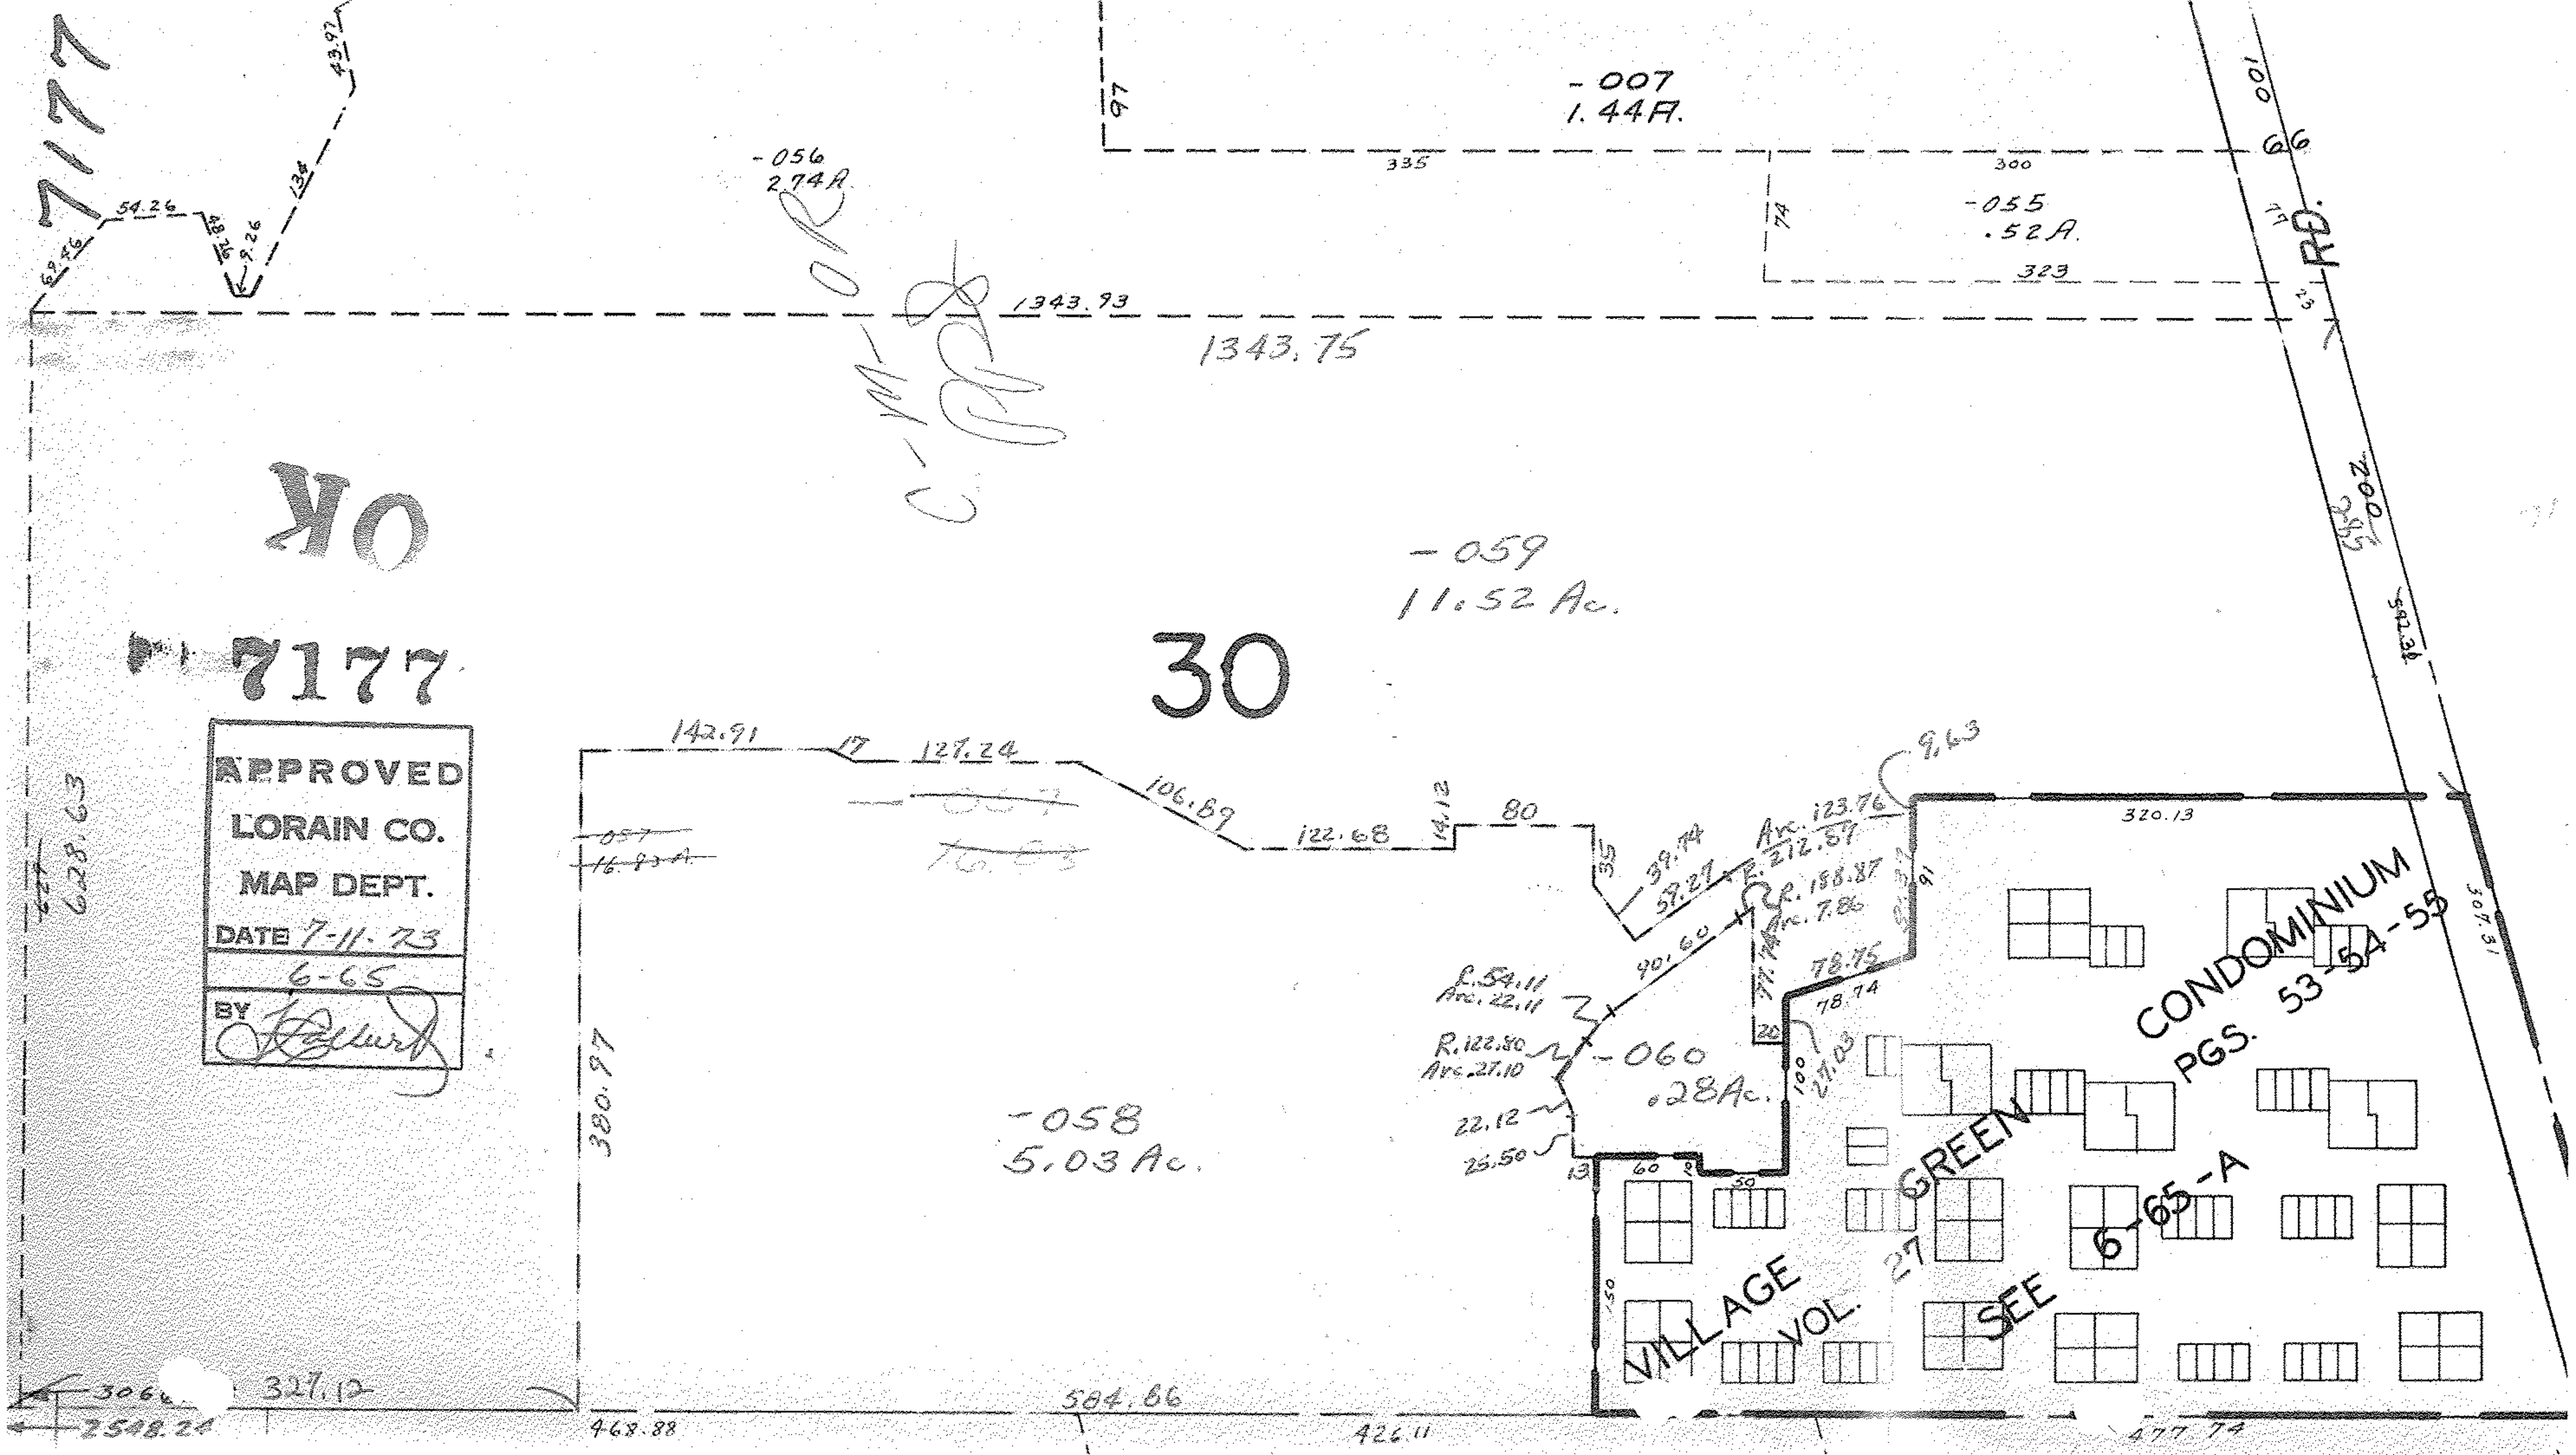
7177
43.92
54.26
48.26
9.26
134
68.46
-056
2.74A.
1343.93
1343.75
-007
1.44A.
335
300
-055
.52A.
323
74
47
100
66
RD.
200
292
592.34
-059
11.52 Ac.
30
OK
7177
APPROVED
LORAIN CO.
MAP DEPT.
DATE 7-11-23
6-65
BY
142.91
17
127.24
106.89
122.68
14.12
80
35
39.14
57.27
Arc. 123.76
R. 212.57
L. 158.87
Arc. 7.86
9.63
320.13
91
40.60
78.75
78.74
L. 54.11
Arc. 22.11
R. 122.50
Arc. 27.10
22.12
26.50
-060
.28Ac.
20
100
27.03
13
60
50
380.97
-058
5.03 Ac.
CONDOMINIUM
PGS. 53-54-55
GREEN
VILLAGE
VOL. 27
SEE
6-65-A
150
628.63
306.31
327.12
2548.24
468.88
584.66
426.11
477.74