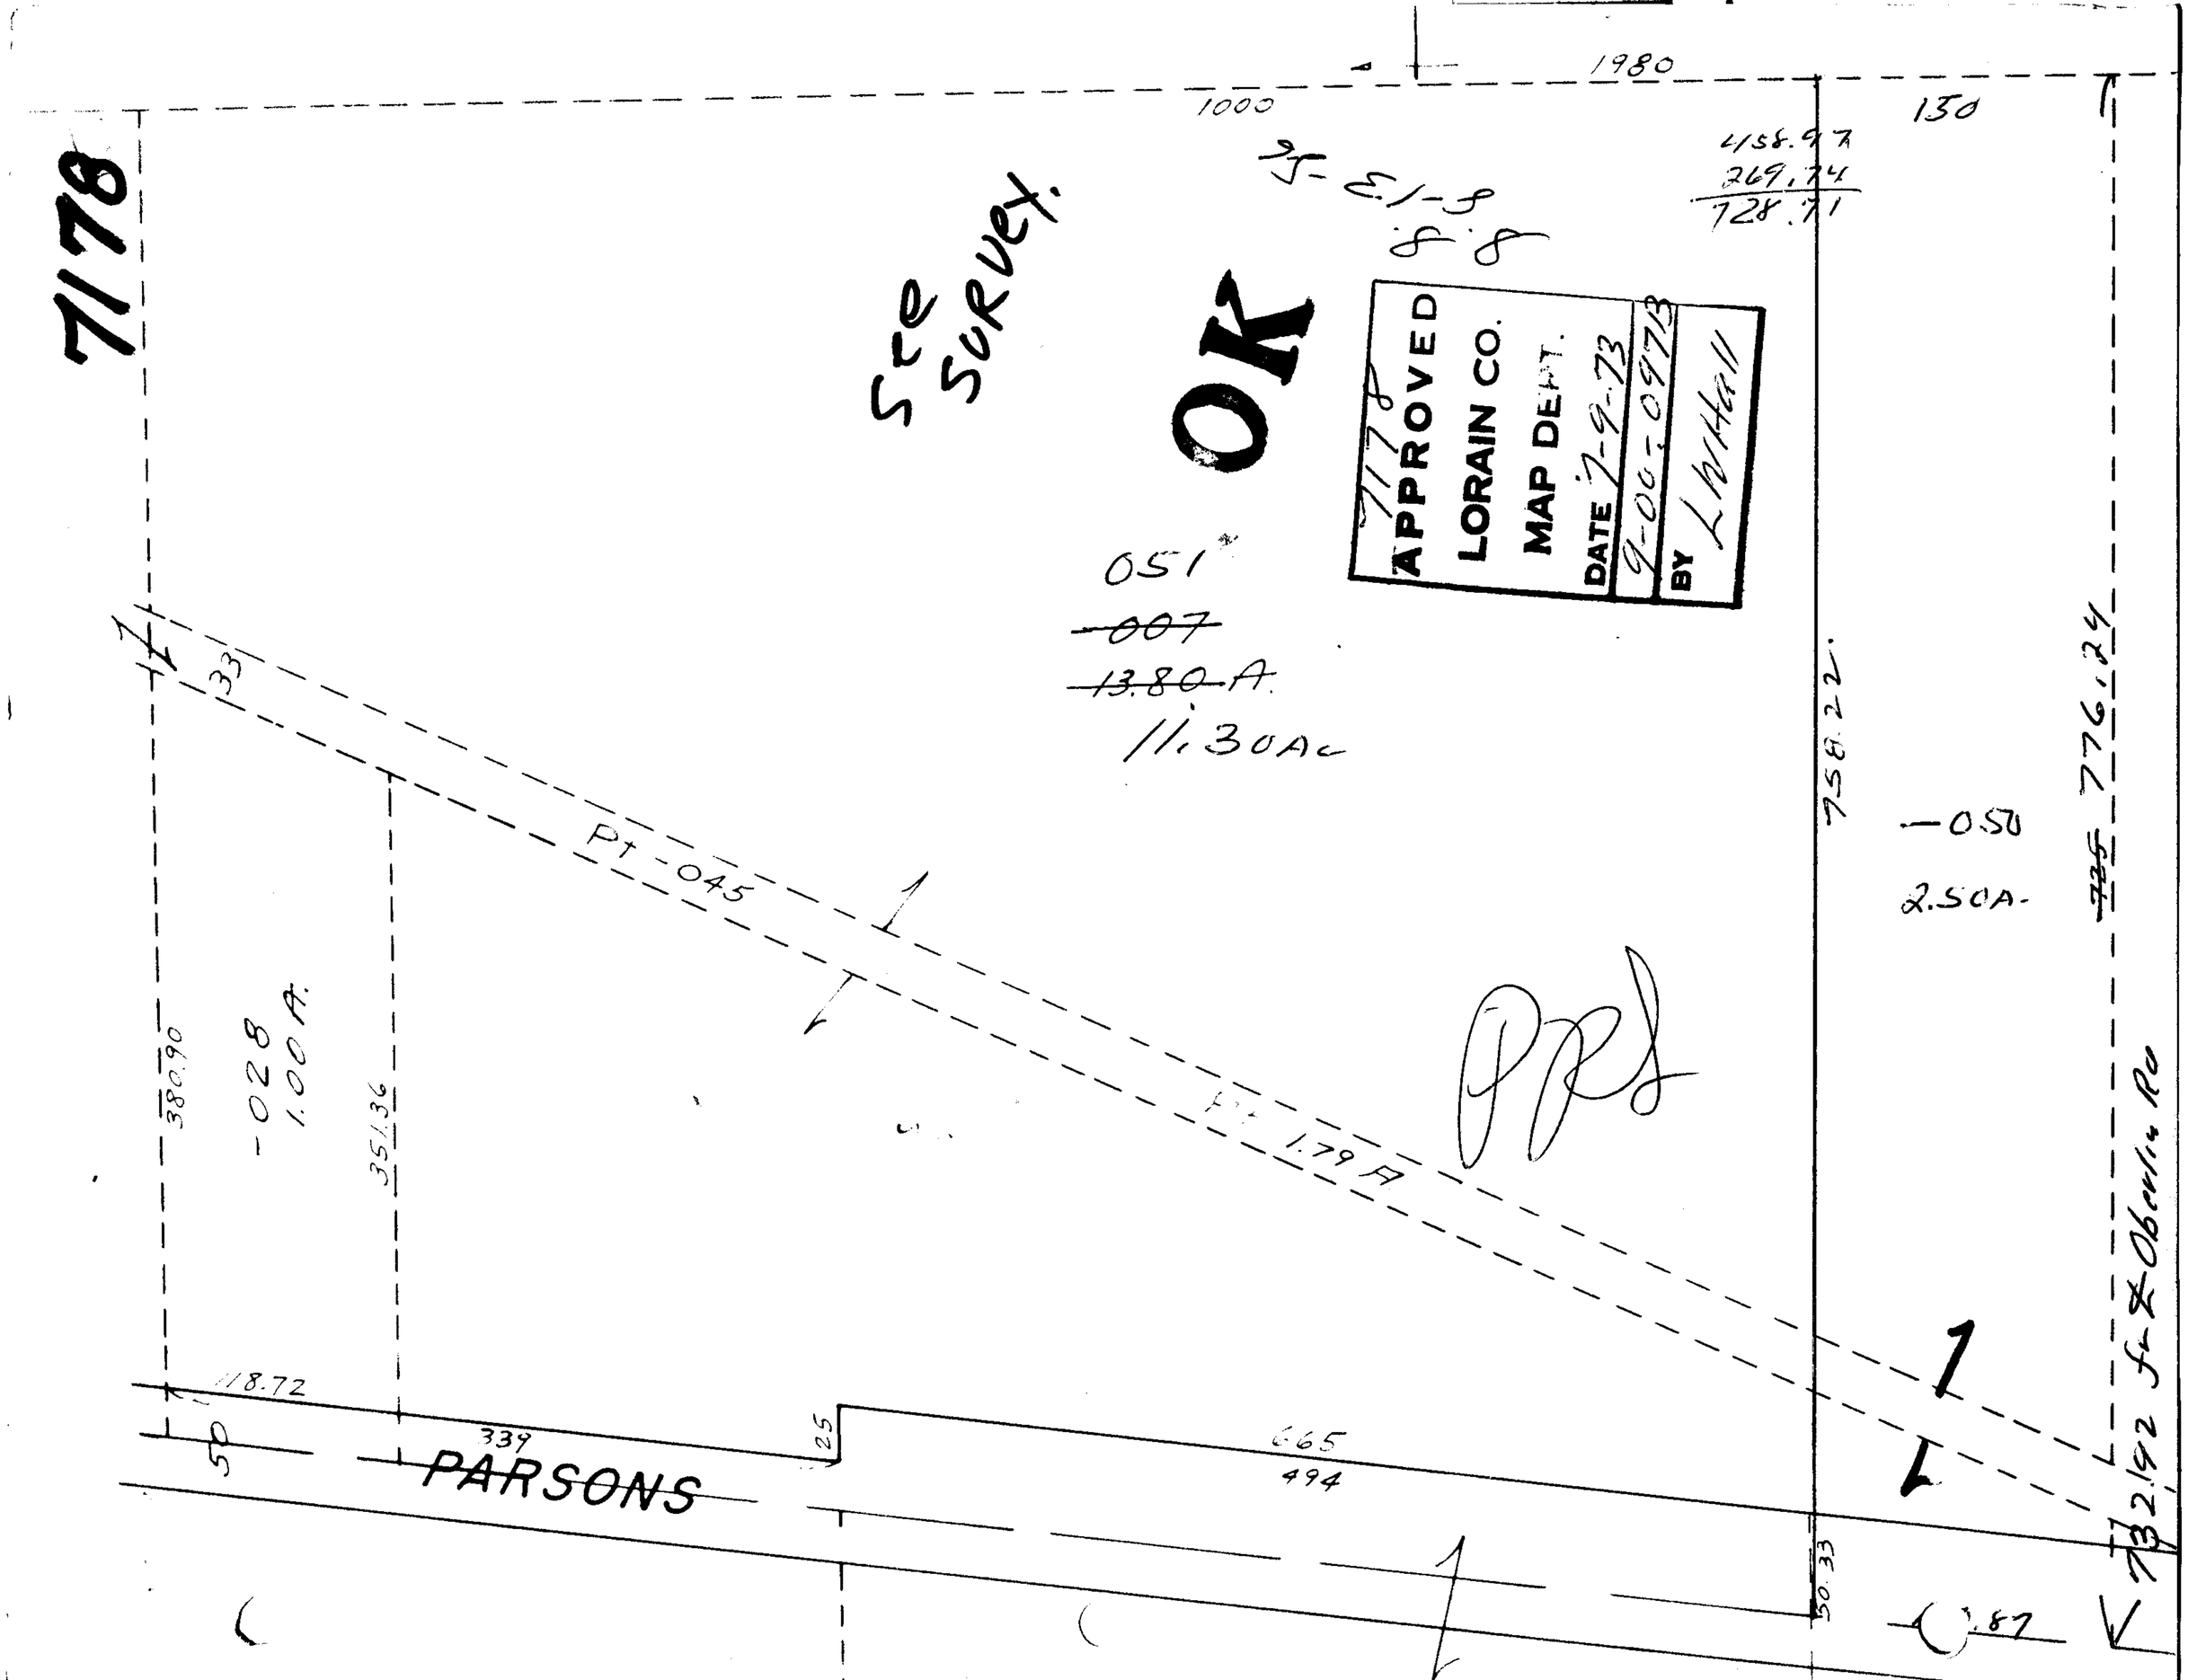
7178
1980
1000
150
458.97
269.74
728.71
See Survey.
OK
7178
APPROVED
LORAIN CO.
MAP DEPT.
DATE 7-9-73
9-00-09713
BY LWHall
051
~~007~~
~~13.80 A.~~
11.30 Ac
33
Pt -045
Pt 1.79 A
758.22
776.24
-050
2.50A.
-028
1.00 A.
380.90
351.36
118.72
339
25
665
494
50
PARSONS
50.33
.87
732.92 ft ± Oberlin Ro