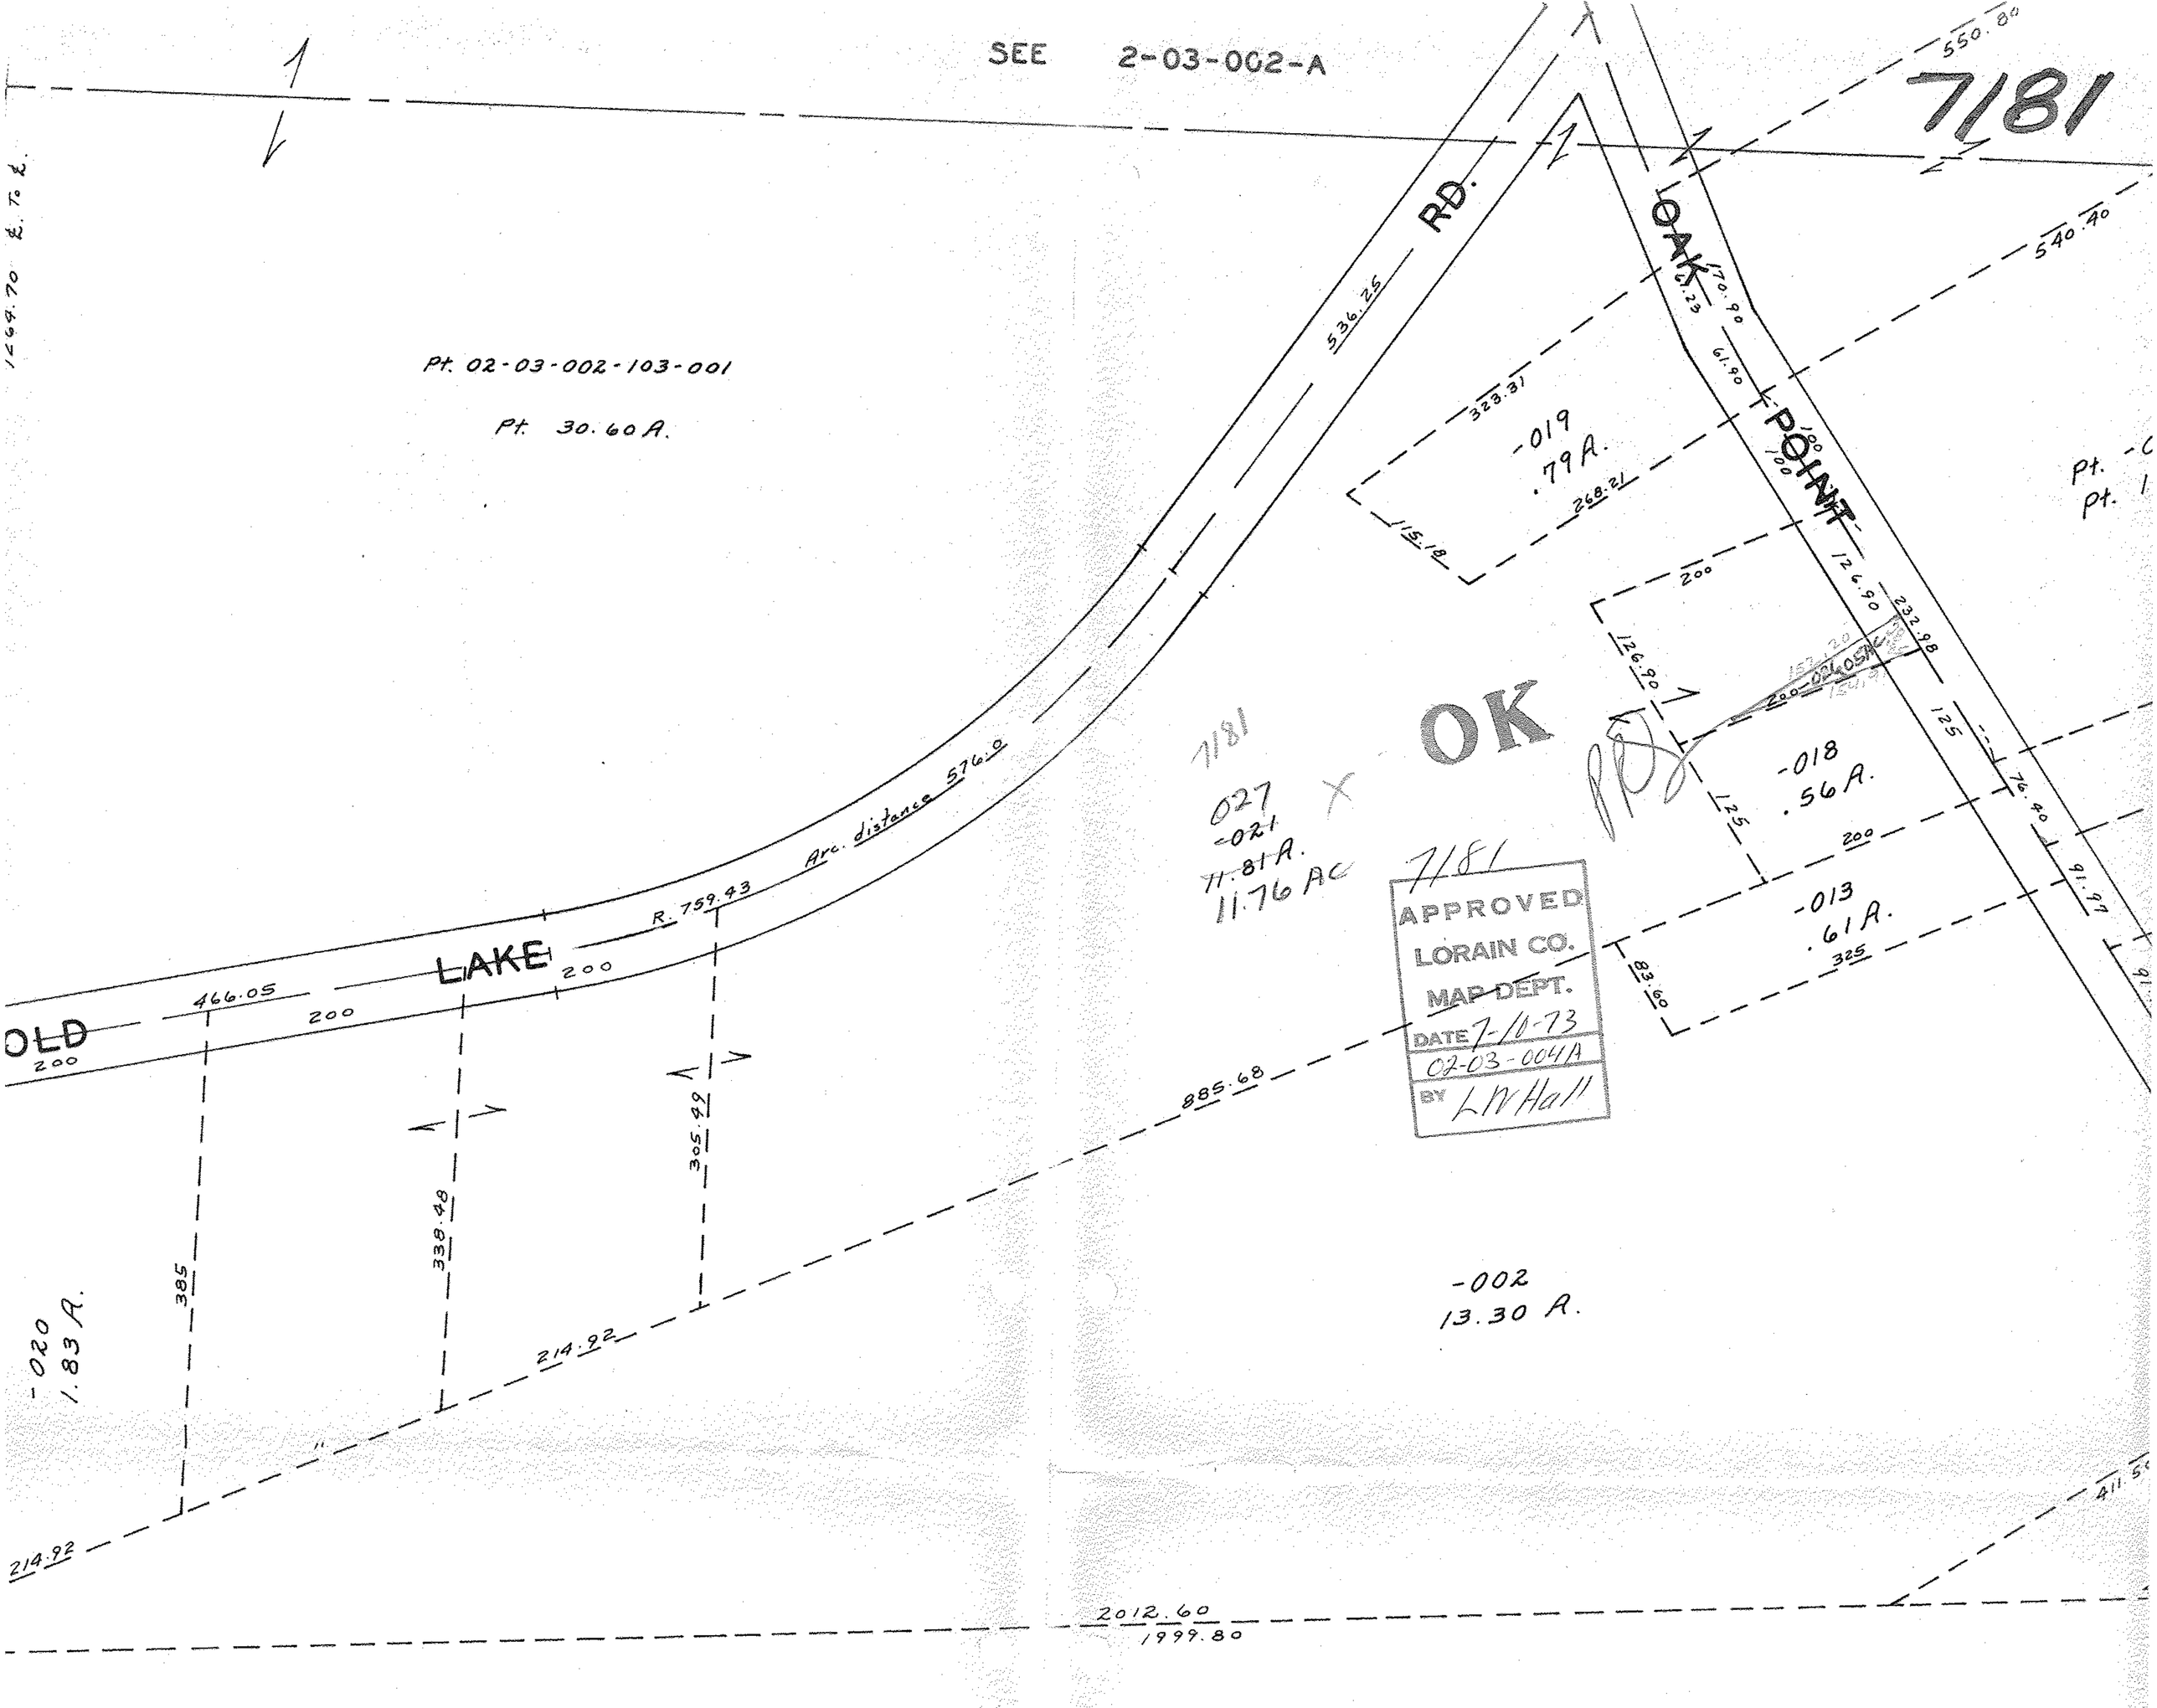

SEE 2-03-002-A
7181
550.80
540.40
RD.
OAK
POINT
536.25
Pt. 02-03-002-103-001
Pt. 30.60 A.
323.31
-019
.79 A.
268.21
115.18
200
126.90
232.98
126.90
OK
7181
027
-021
11.81 A.
11.76 AC
-018
.56 A.
125
200
-013
.61 A.
325
83.60
76.40
91.97
Arc. distance 576.0
R. 759.43
LAKE
OLD
466.05
200
200
200
885.68
305.49
338.48
385
214.92
-020
1.83 A.
-002
13.30 A.
214.92
2012.60
1999.80
411.50
APPROVED
LORAIN CO.
MAP DEPT.
DATE 7-10-73
02-03-004A
BY LW Hall