7224
7225

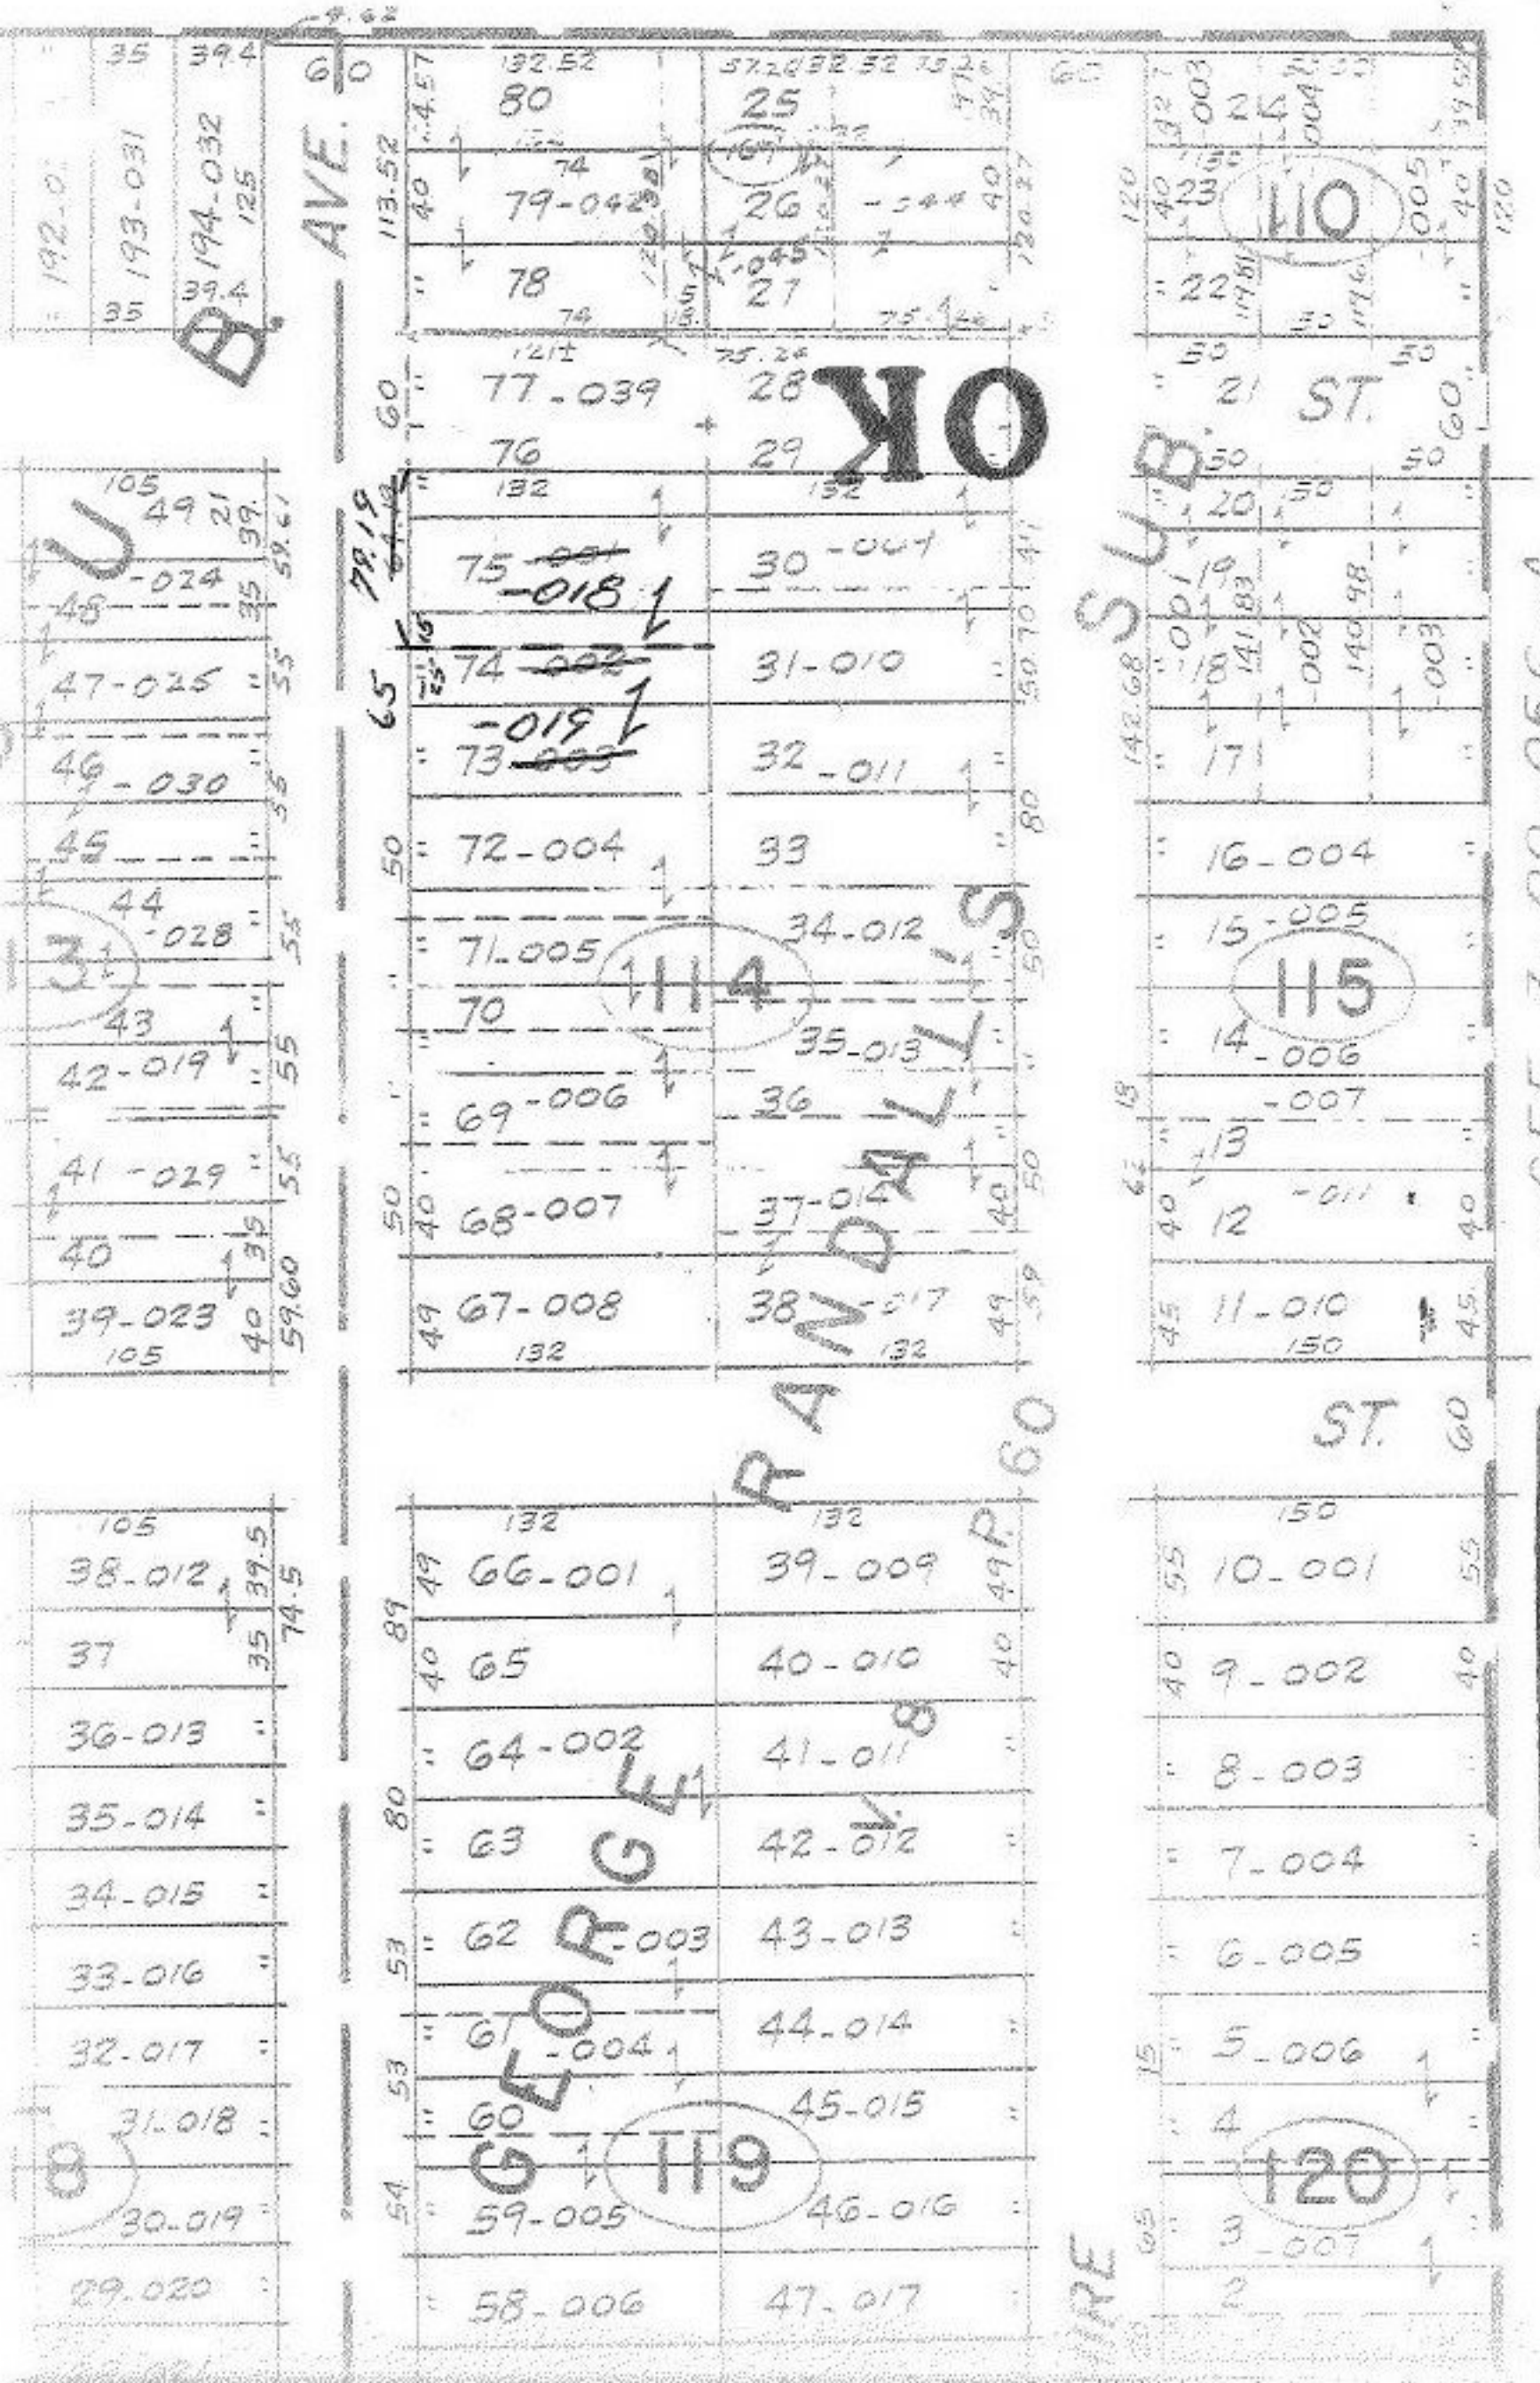

SEE 3-00-056-A

PPS

7224
7225

APPROVED
LORAIN CO.
MAP DEPT.
DATE 7-24-73
3-00-055-A
BY [signature]

S. 8.
8-5-86