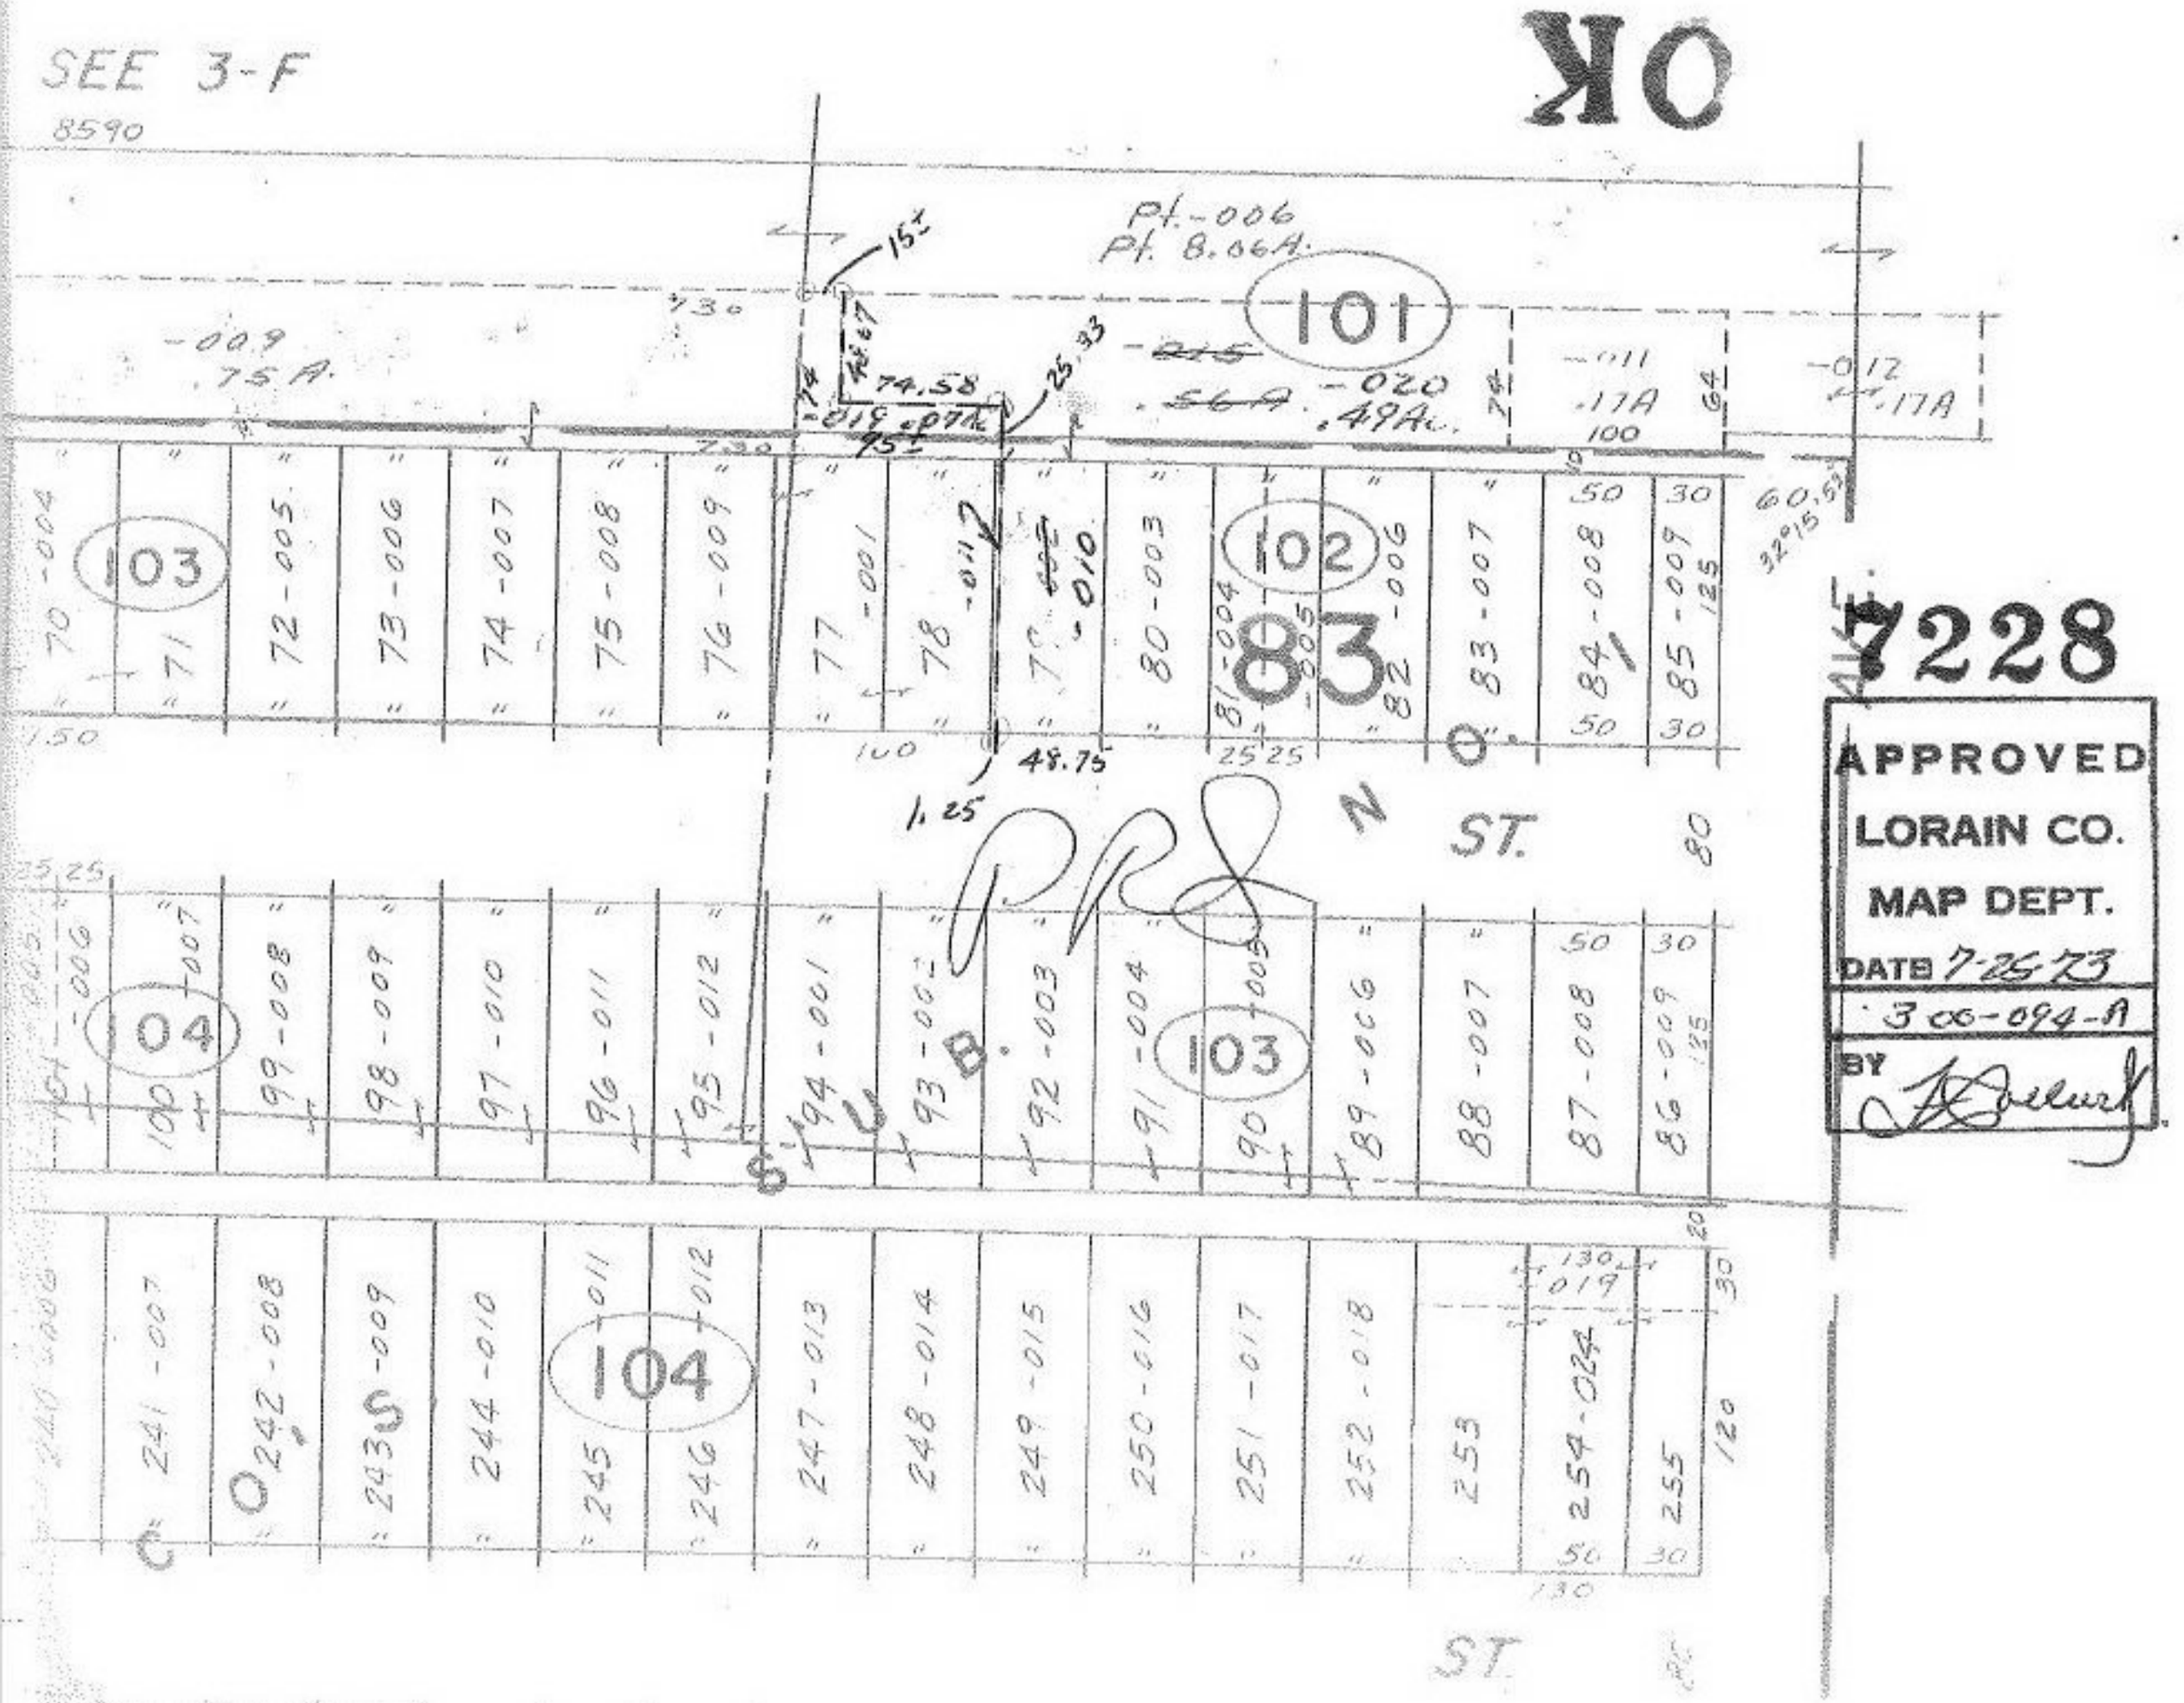
SEE 3-F
8590
OK
Pt.-006
Pt. 8.06A.
101
-009
.75A.
-020
.49A.
-011
.17A
-012
.17A
103
102
83
104
103
104
ST.
ST.
S.U.B.
N.O.
C.O.
7228
APPROVED
LORAIN CO.
MAP DEPT.
DATE 7-25-73
3-00-094-A
BY

7228