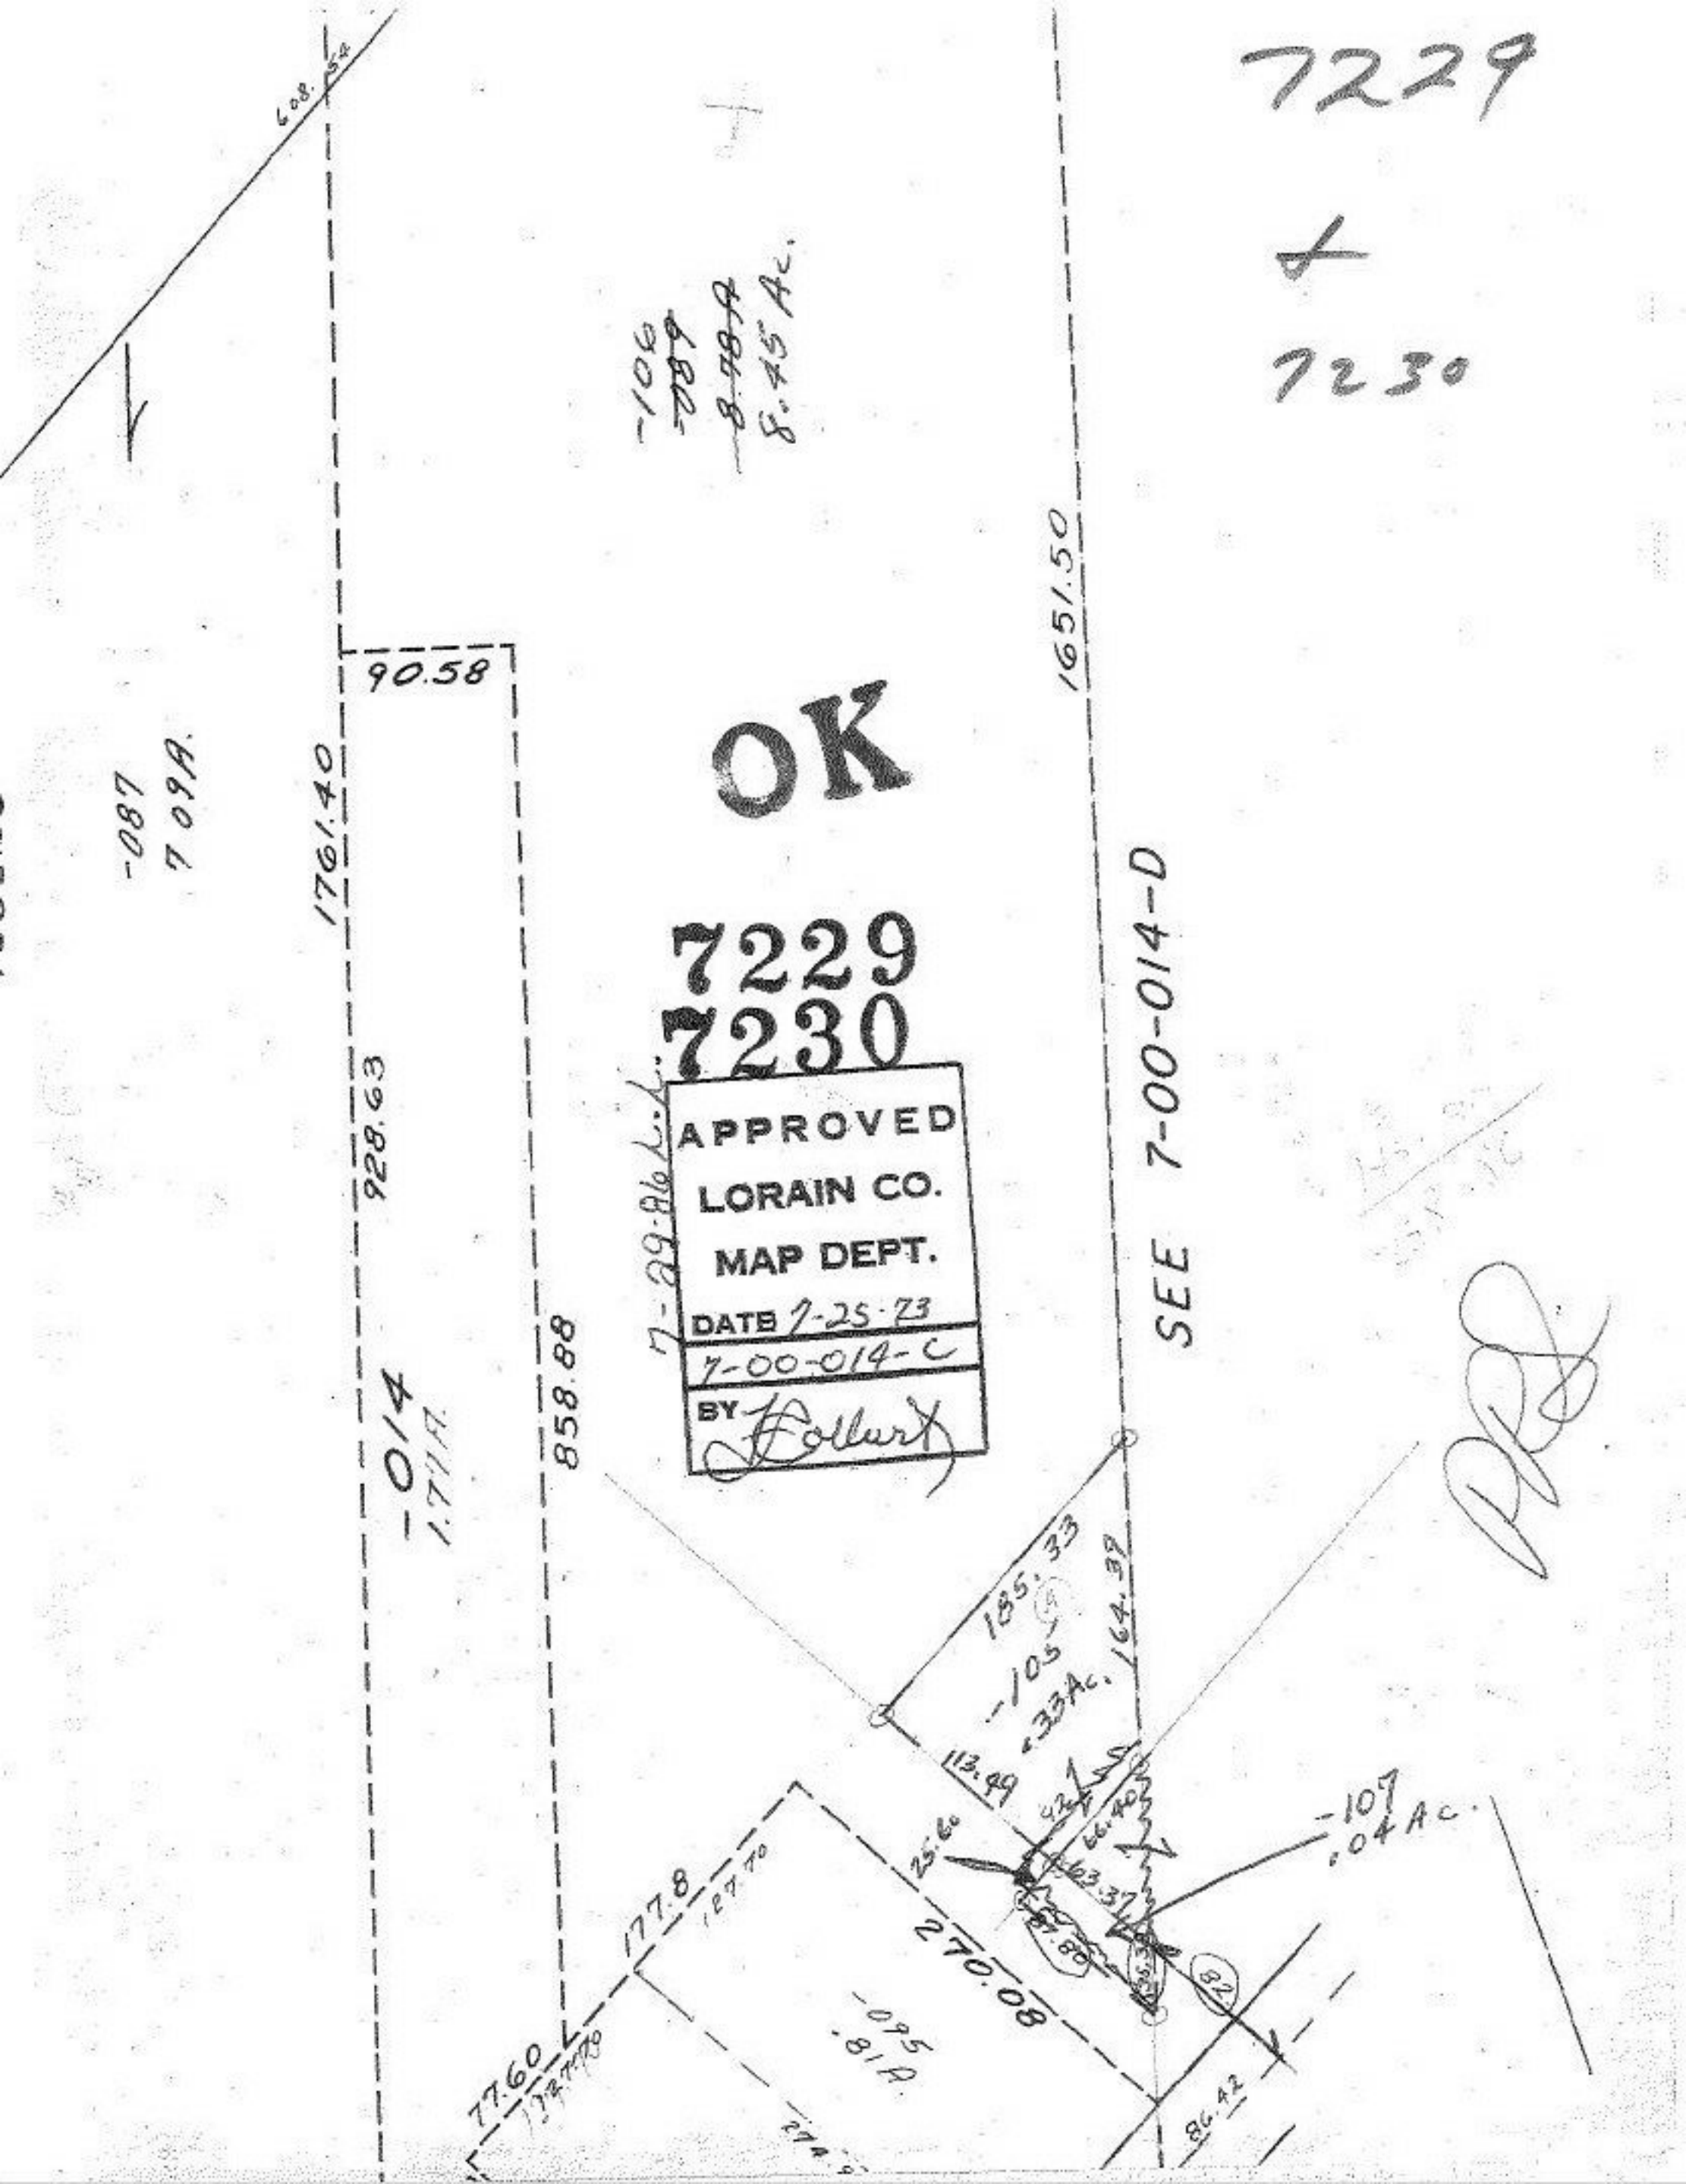
7229
&
7230
608.54
-106
8.45 Ac.
1651.50
90.58
OK
-087
7.09A.
1761.40
7229
7230
APPROVED
LORAIN CO.
MAP DEPT.
DATE 7-25-73
7-00-014-C
BY
7-29-86
928.63
858.88
-014
1.77A.
SEE 7-00-014-D
185.33
164.39
-105
.33Ac.
113.49
-107
.04 Ac.
25.60
177.8
127.70
270.08
-095
.81A.
77.60
86.42