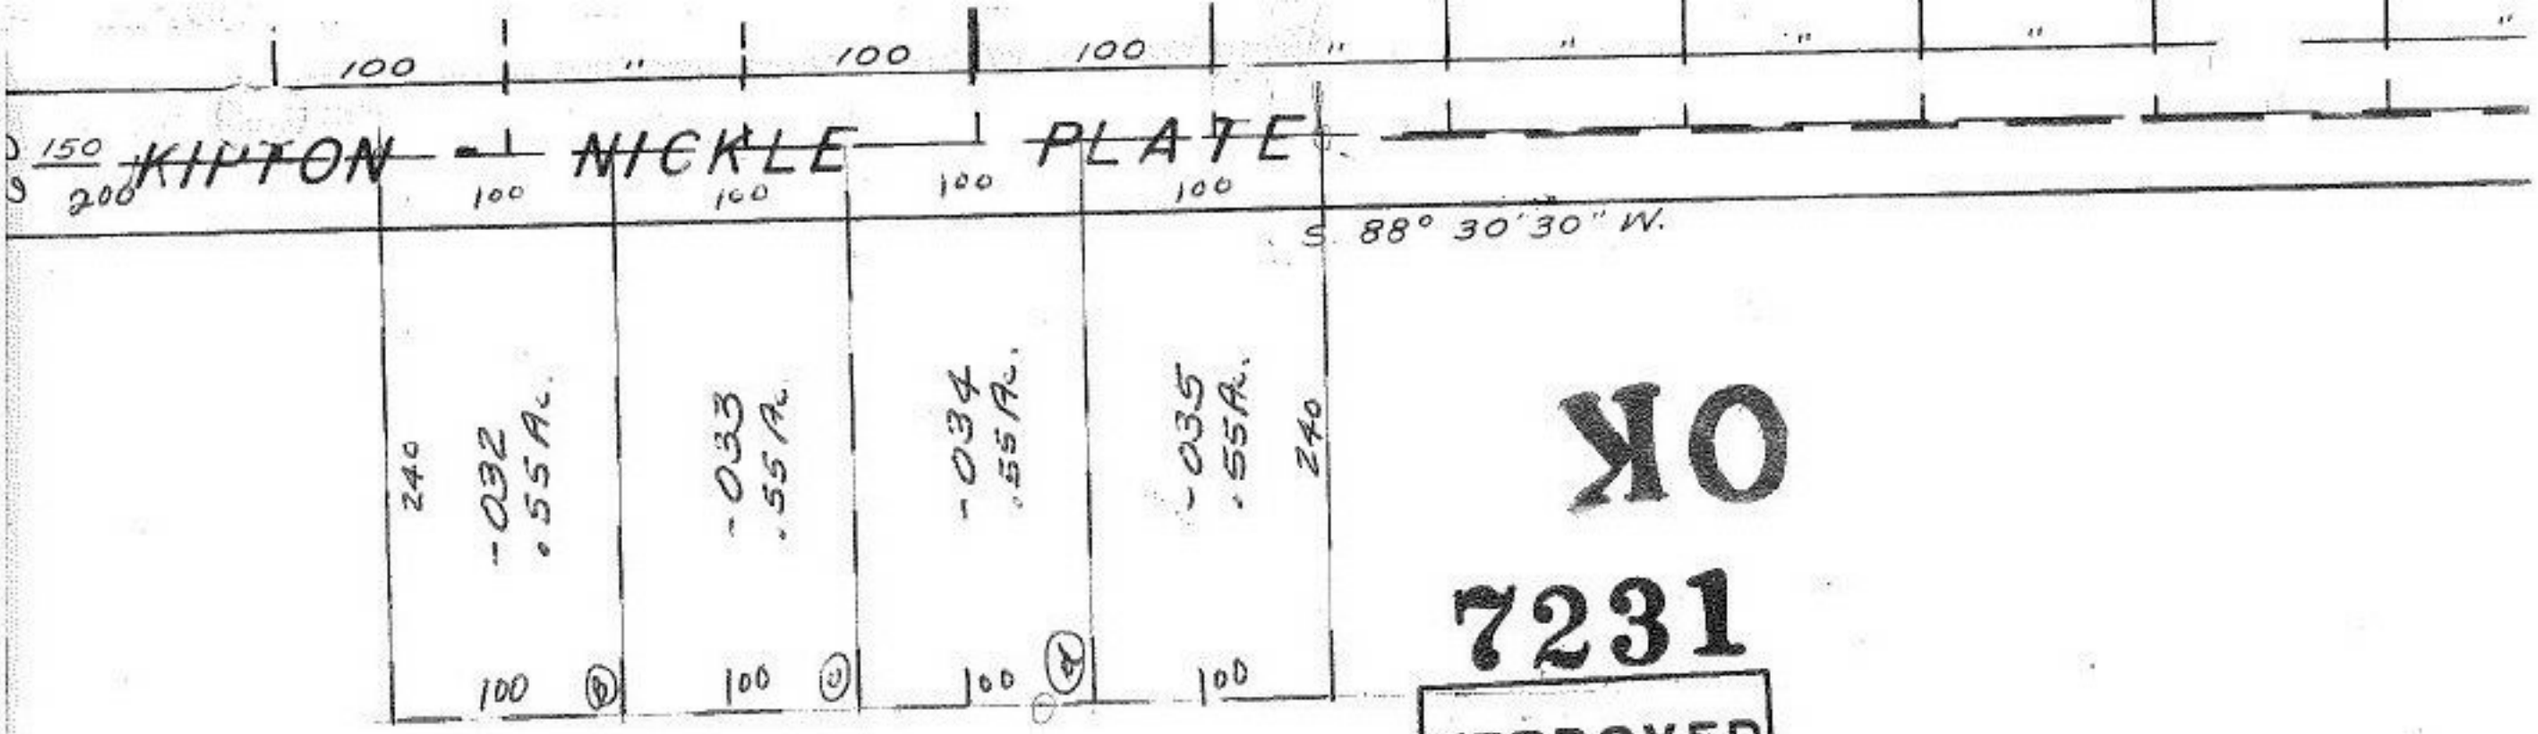

OK

7231

APPROVED
LORAIN CO.
MAP DEPT.
DATE 7-25-73
15-00-020-A
BY [signature]

7-26-73

Pt. - ~~021~~ 031
Pt. ~~75.22A~~ 73.02 Ac.

7231