OK

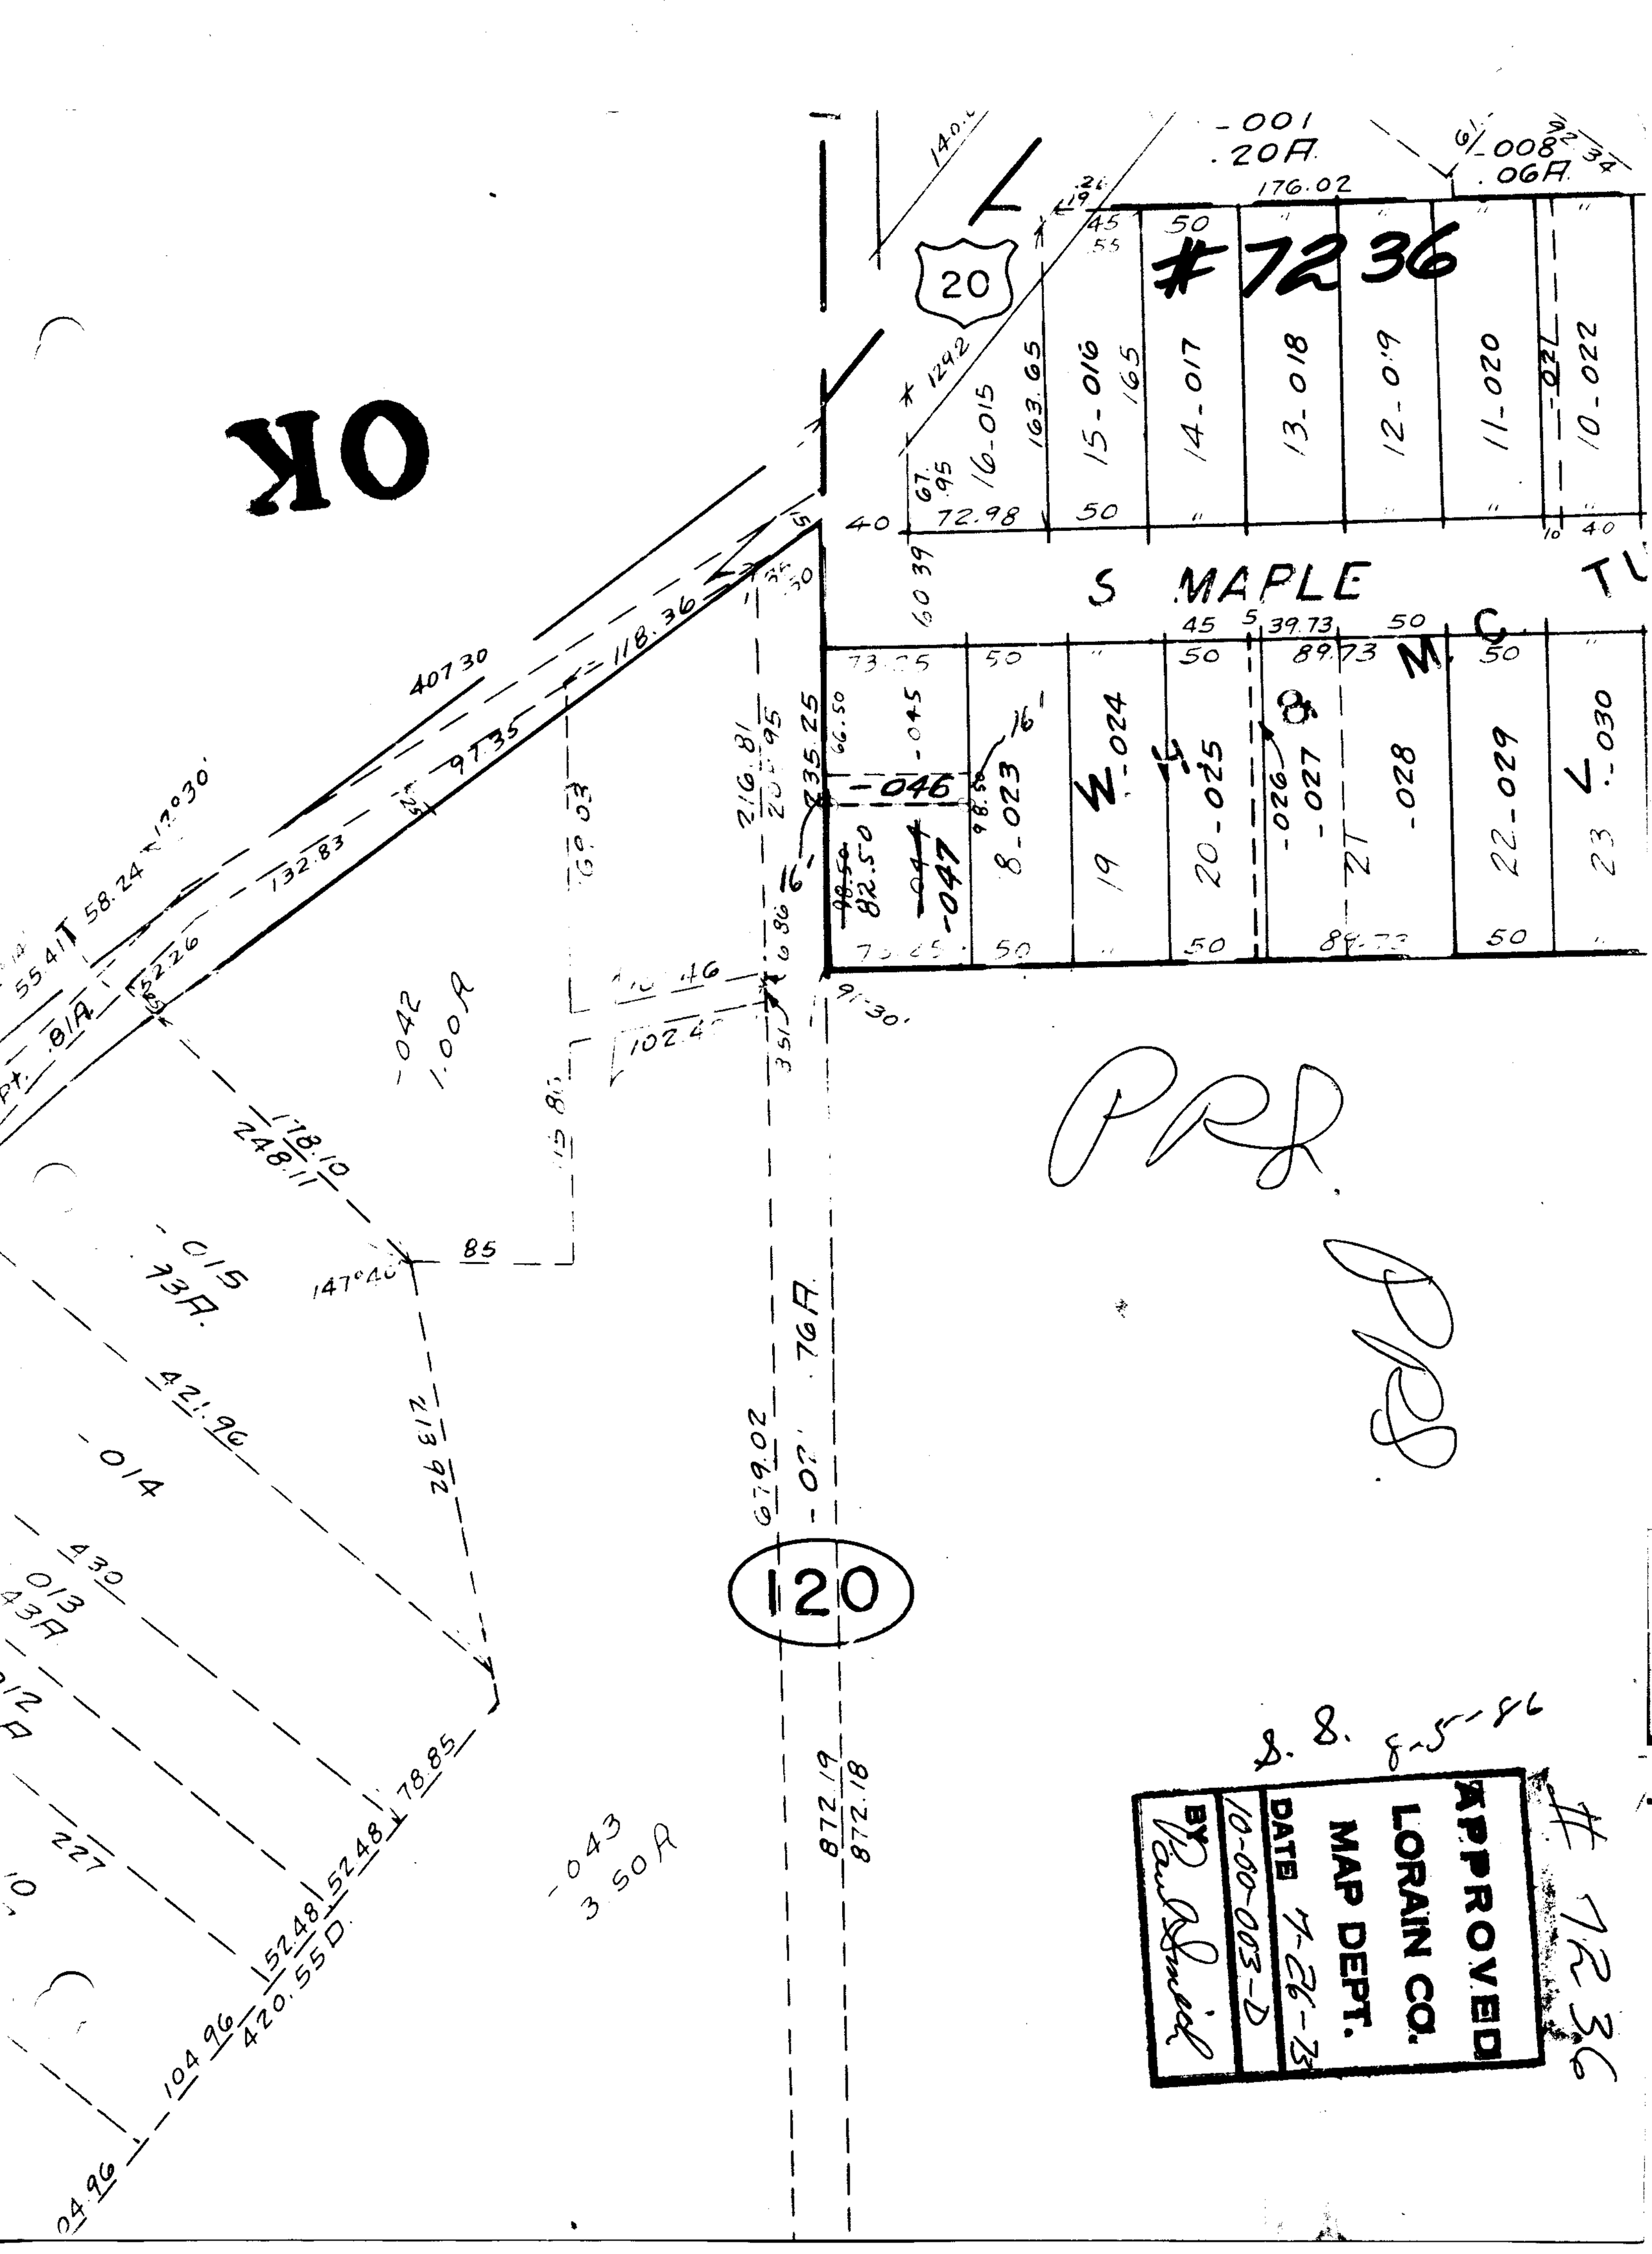
20
S MAPLE
#7236
-001
.20A.
-008
.06A.
176.02
140.2
1242
67.95
72.98
16-015
163.65
15-016
165
14-017
13-018
12-019
11-020
10-021
220
50
45
55
40
60 39
-046
-047
8-023
9-024
19
20-025
-026
-027
21
-028
22-029
23-030
66.50
82.50
216.81
207.95
835.25
98.85
16
73.25
89.73
39.73
5
91.30
-042
1.00A
118.36
97.35
132.83
40730
55.41
T 58.24
17°30'
PT. .81A.
52.26
248.11
18.10
147°40'
85
-015
13A.
421.96
-014
213.92
-043
3.50A
420.55D.
104.96
52.48
78.85
679.02
872.19
872.18
-07
.76A.
120
APPROVED
LORAIN CO.
MAP DEPT.
DATE 7-26-23
10-00-003-D
BY Paul Schmied
S. S. 8-5-46
#7236