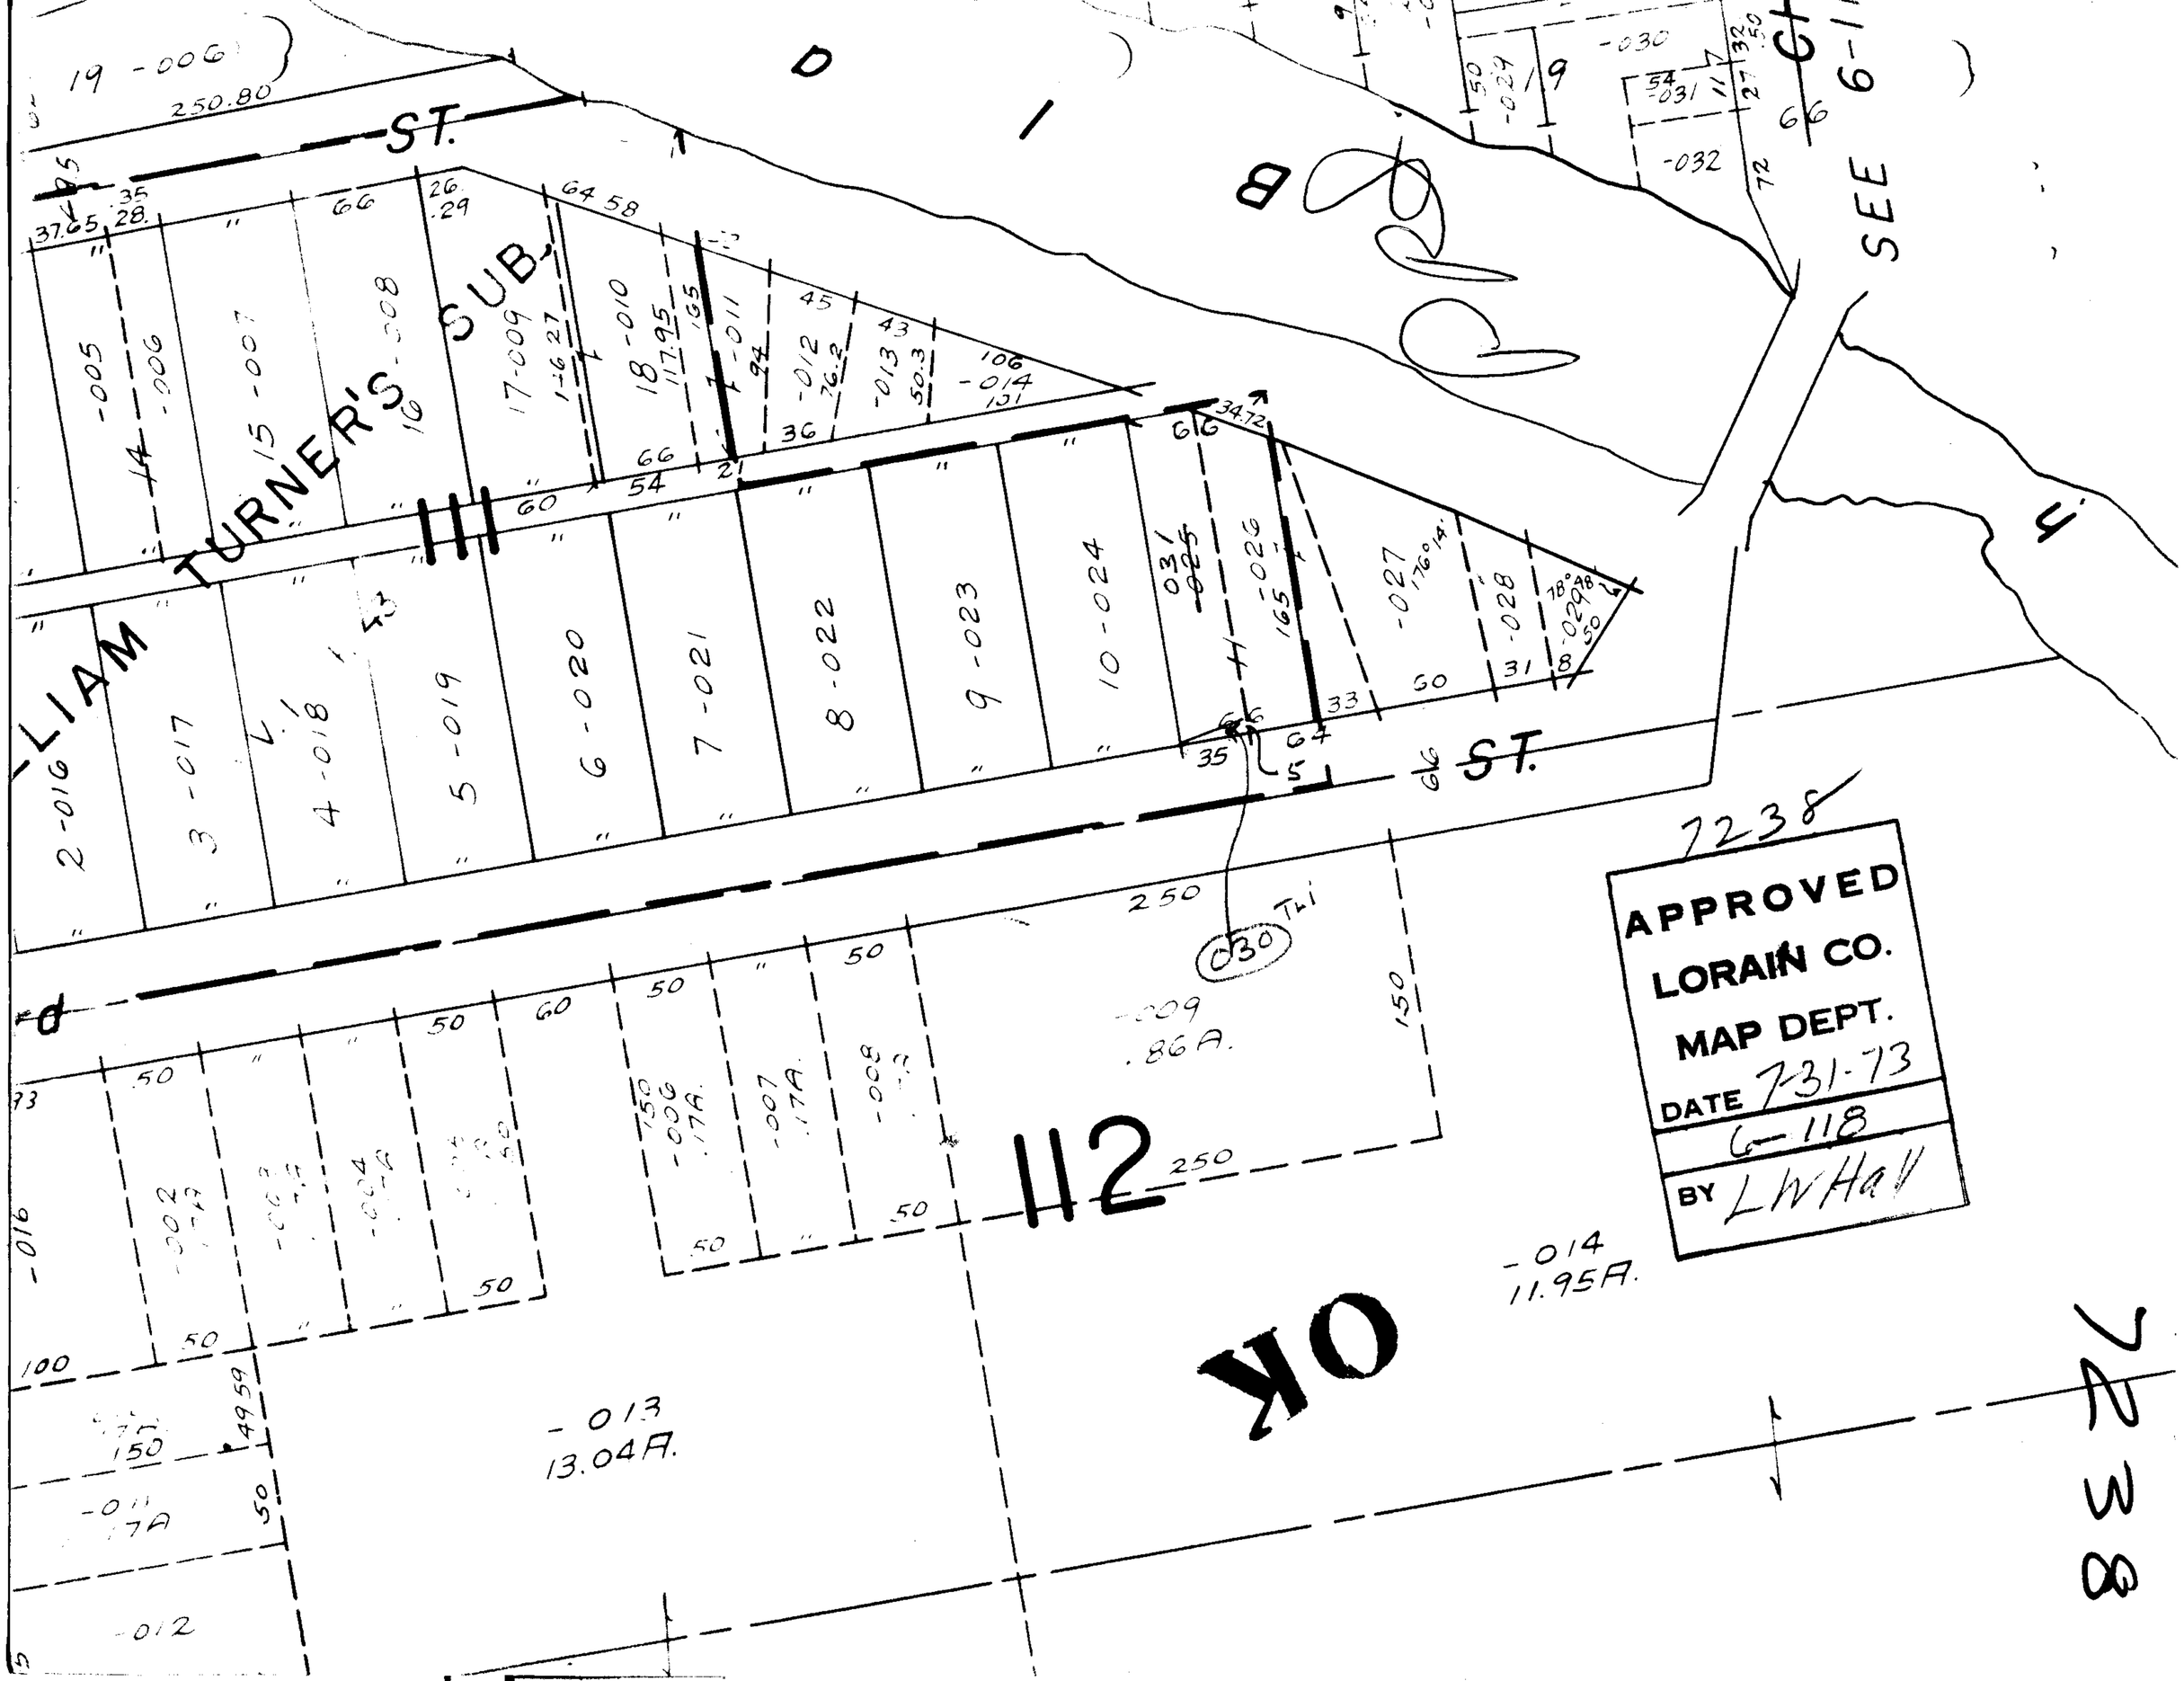

ST.
TURNER'S SUB.
LIAM
ST.
SEE 6-11
7238
APPROVED
LORAIN CO.
MAP DEPT.
DATE 7-31-73
6-118
BY LWHall
112
OK
-014
11.95A.
-013
13.04A.
-009
.86A.
030