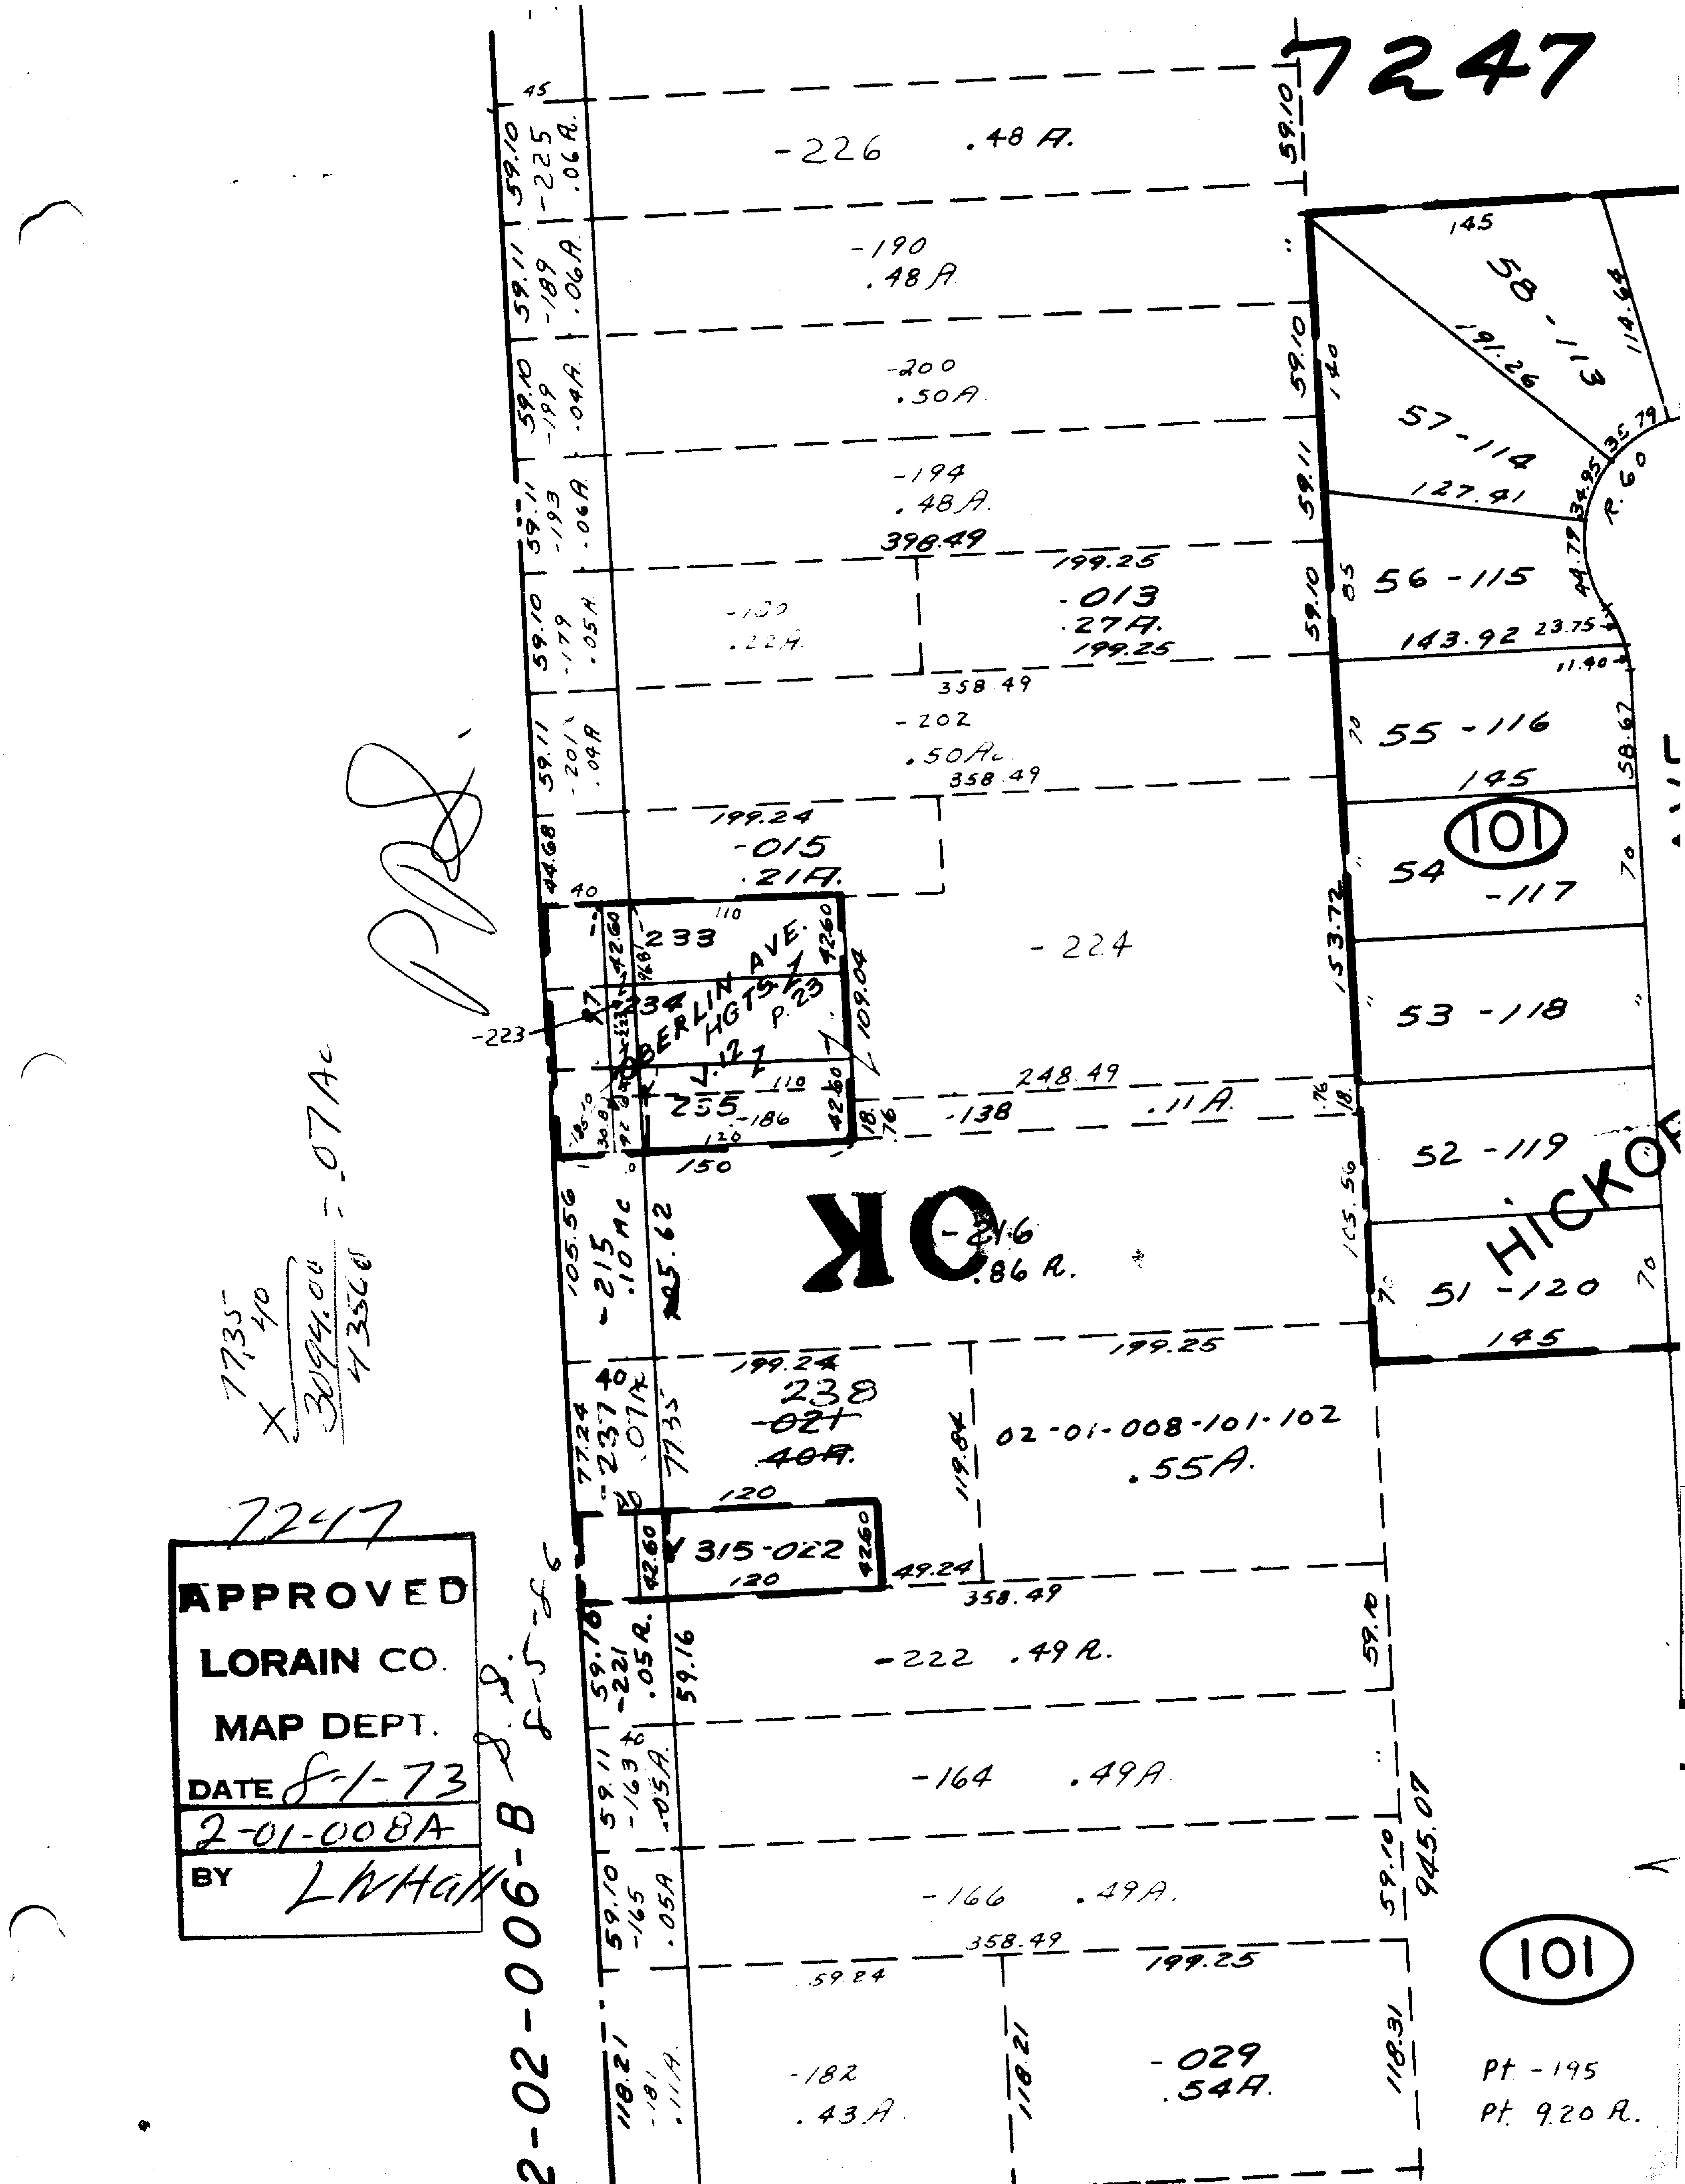
7247
-226 .48 A.
59.10 -225 .06 A.
59.11 -189 .06 A.
-190 .48 A.
59.10 -199 .04 A.
-200 .50 A.
59.11 -193 .06 A.
-194 .48 A.
398.49
199.25
-013
.27 A.
199.25
59.10 -179 .05 A.
358.49
-202
.50 Ac.
358.49
59.11 -201 .04 A.
199.24
-015
.21 A.
44.68
40
233
110
42.60
OBERLIN AVE. HGTS.
V. 12 P. 23
-223
255
-186
110
120
150
109.04
-224
248.49
-138
.11 A.
18.76
105.56
-215
.10 Ac
-216
.86 A.
OK
199.24
238
-021
.40 A.
199.25
77.24
-237
.07 A.
77.35
40
120
119.84
02-01-008-101-102
.55 A.
315-022
120
42.60
49.24
358.49
59.16
59.76 -221 .05 A.
-222 .49 A.
59.10
59.11 -163 .05 A.
-164 .49 A.
59.10 -165 .05 A.
-166 .49 A.
59.10
945.07
358.49
59.24
199.25
118.21 -181 .11 A.
-182
.43 A.
118.21
-029
.54 A.
118.31
2-02-006-B
145
58-113
191.26
114.68
57-114
127.41
35.79
34.95
R. 60
44.79
56-115
143.92
23.75
11.40
55-116
145
58.62
101
54 -117
153.72
53-118
52-119
105.56
51-120
HICKORY
145
70
101
Pt -195
Pt. 9.20 A.
77.35
x 40
3094.00
43560
= .07 Ac
7247
APPROVED
LORAIN CO.
MAP DEPT.
DATE 8-1-73
2-01-008A
BY LWHall
8-5-86