7251

APPROVED
LORAIN CO.
MAP DEPT.
DATE 8-2-73
02-01-008B
BY Lw Hall

7251

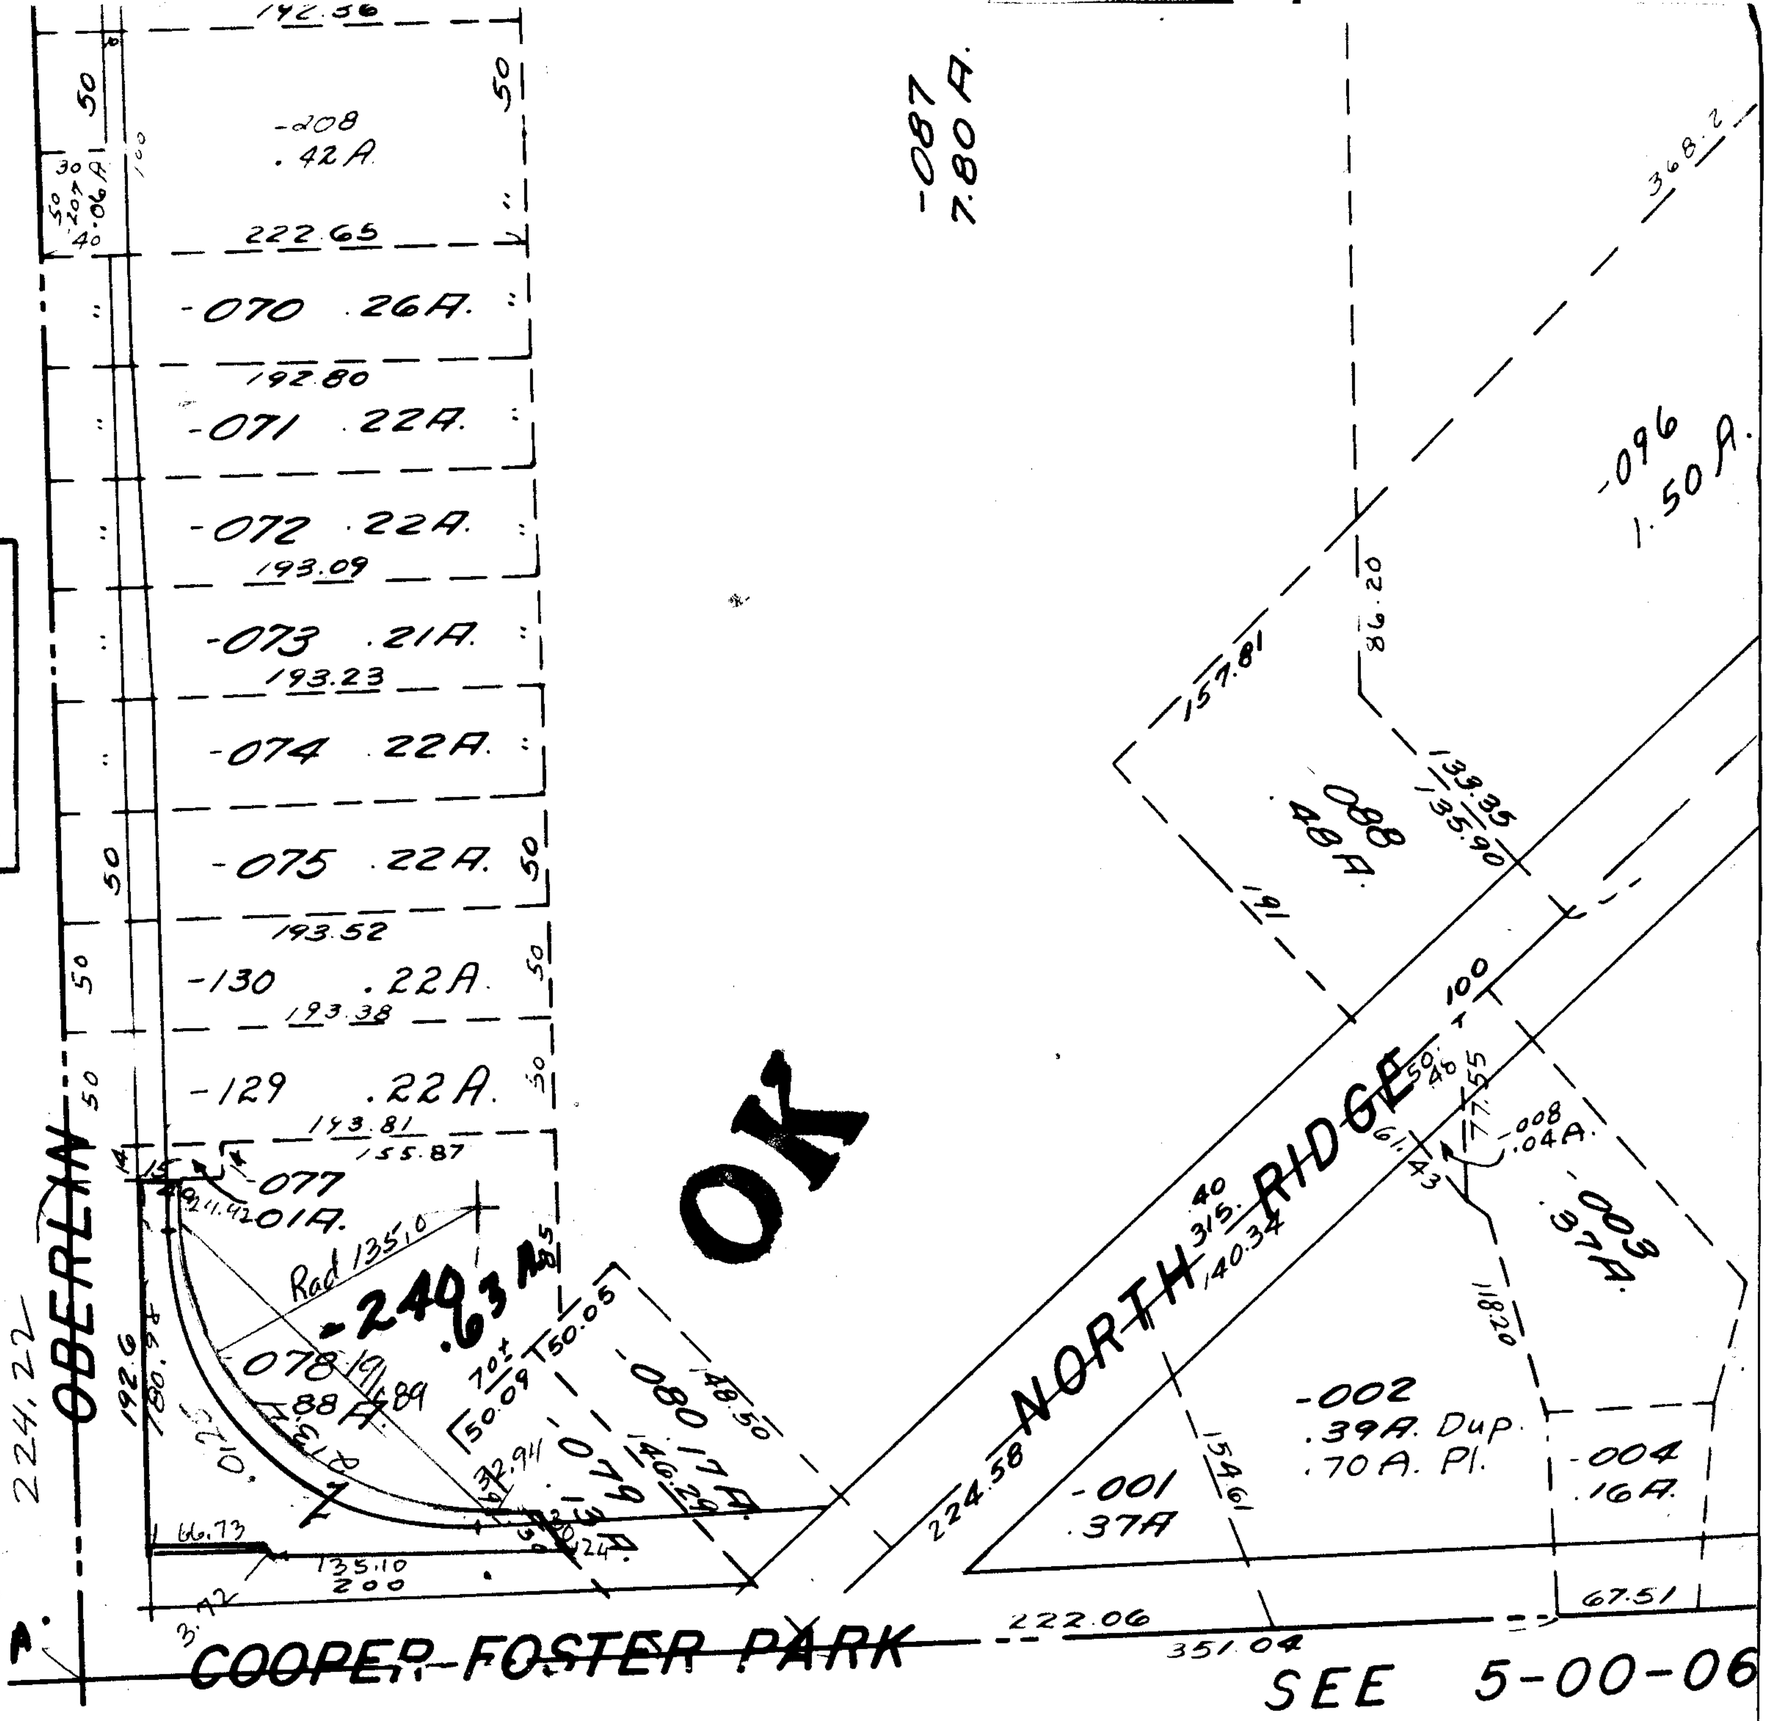

SEE 5-00-06

Use Trench Curve