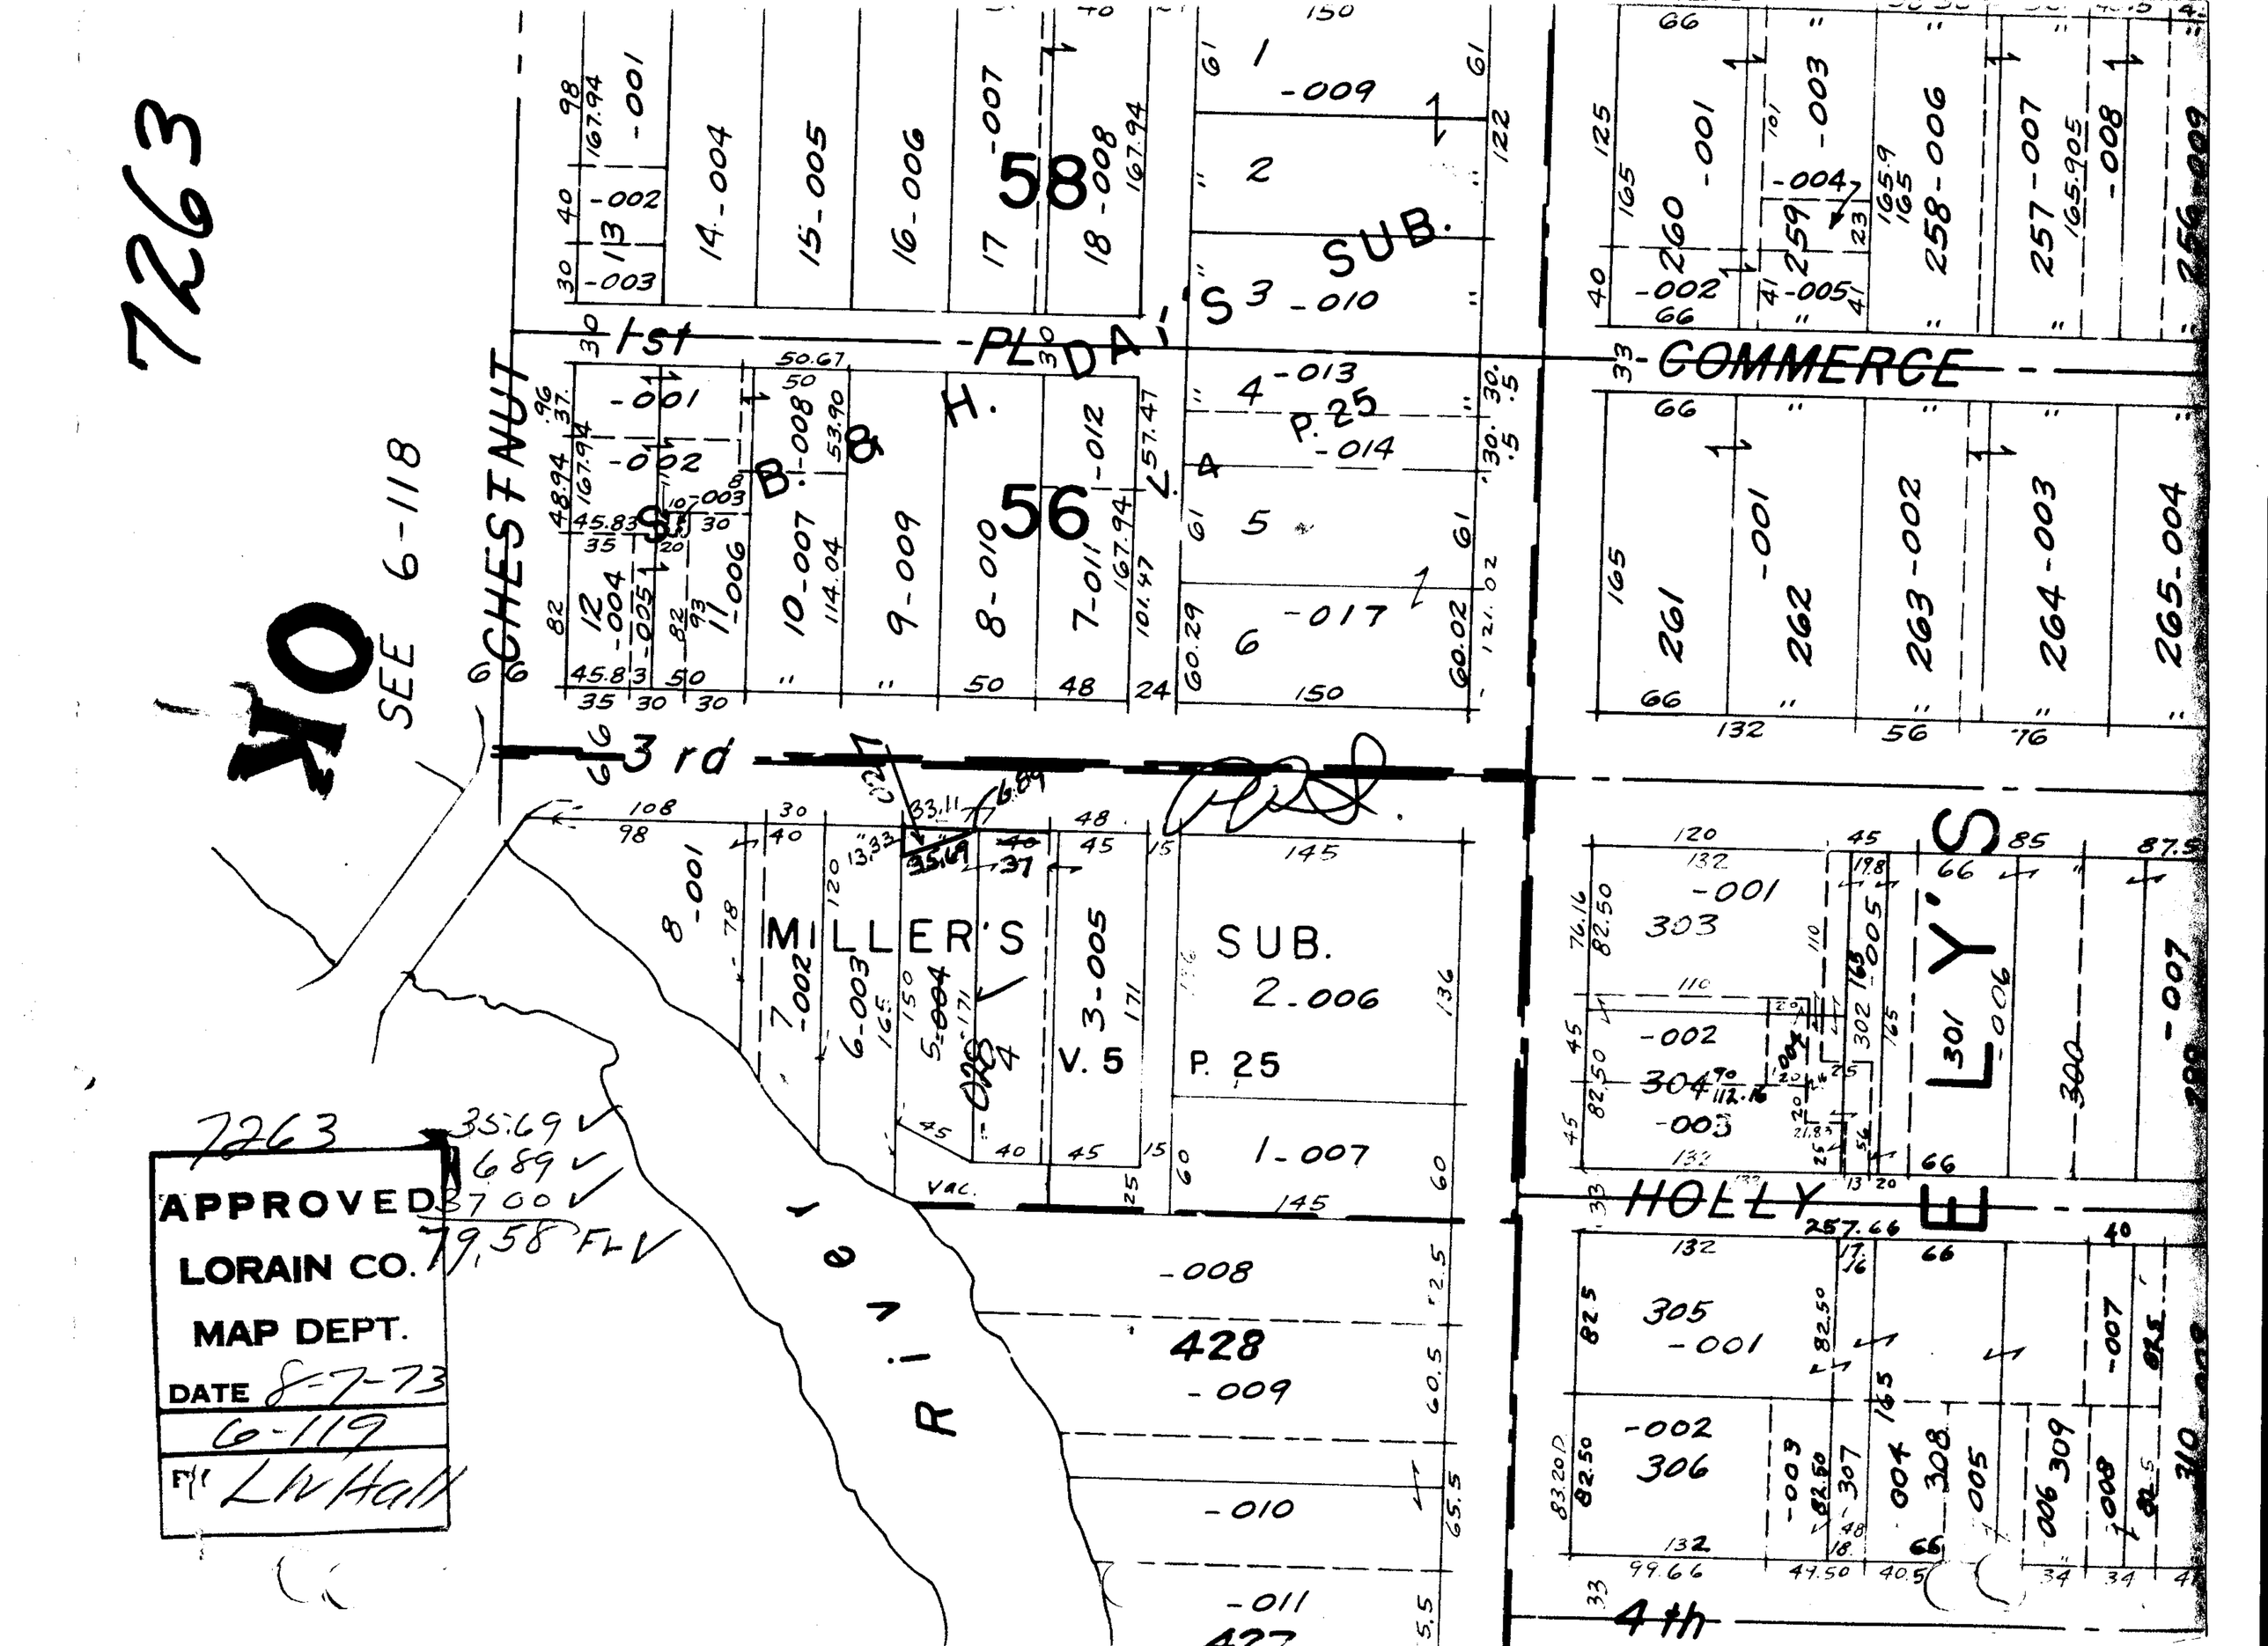
7263
OK
SEE 6-118
CHESTNUT
1st
PL
DAI'S SUB.
COMMERCE
S. B. & H.
V. 4
P. 25
3rd
MILLER'S SUB.
V. 5
P. 25
River
HOLLY
LY'S
4th
58
56
428
7263
35.69
6.89
37.00
79.58 FL
APPROVED
LORAIN CO.
MAP DEPT.
DATE 8-7-73
6-119
LW Hall