


7277
7279

7277
7279
APPROVED
LORAIN CO.
MAP DEPT.
DATE 8/16/73
02-01-008B
BY L W Hall

OK

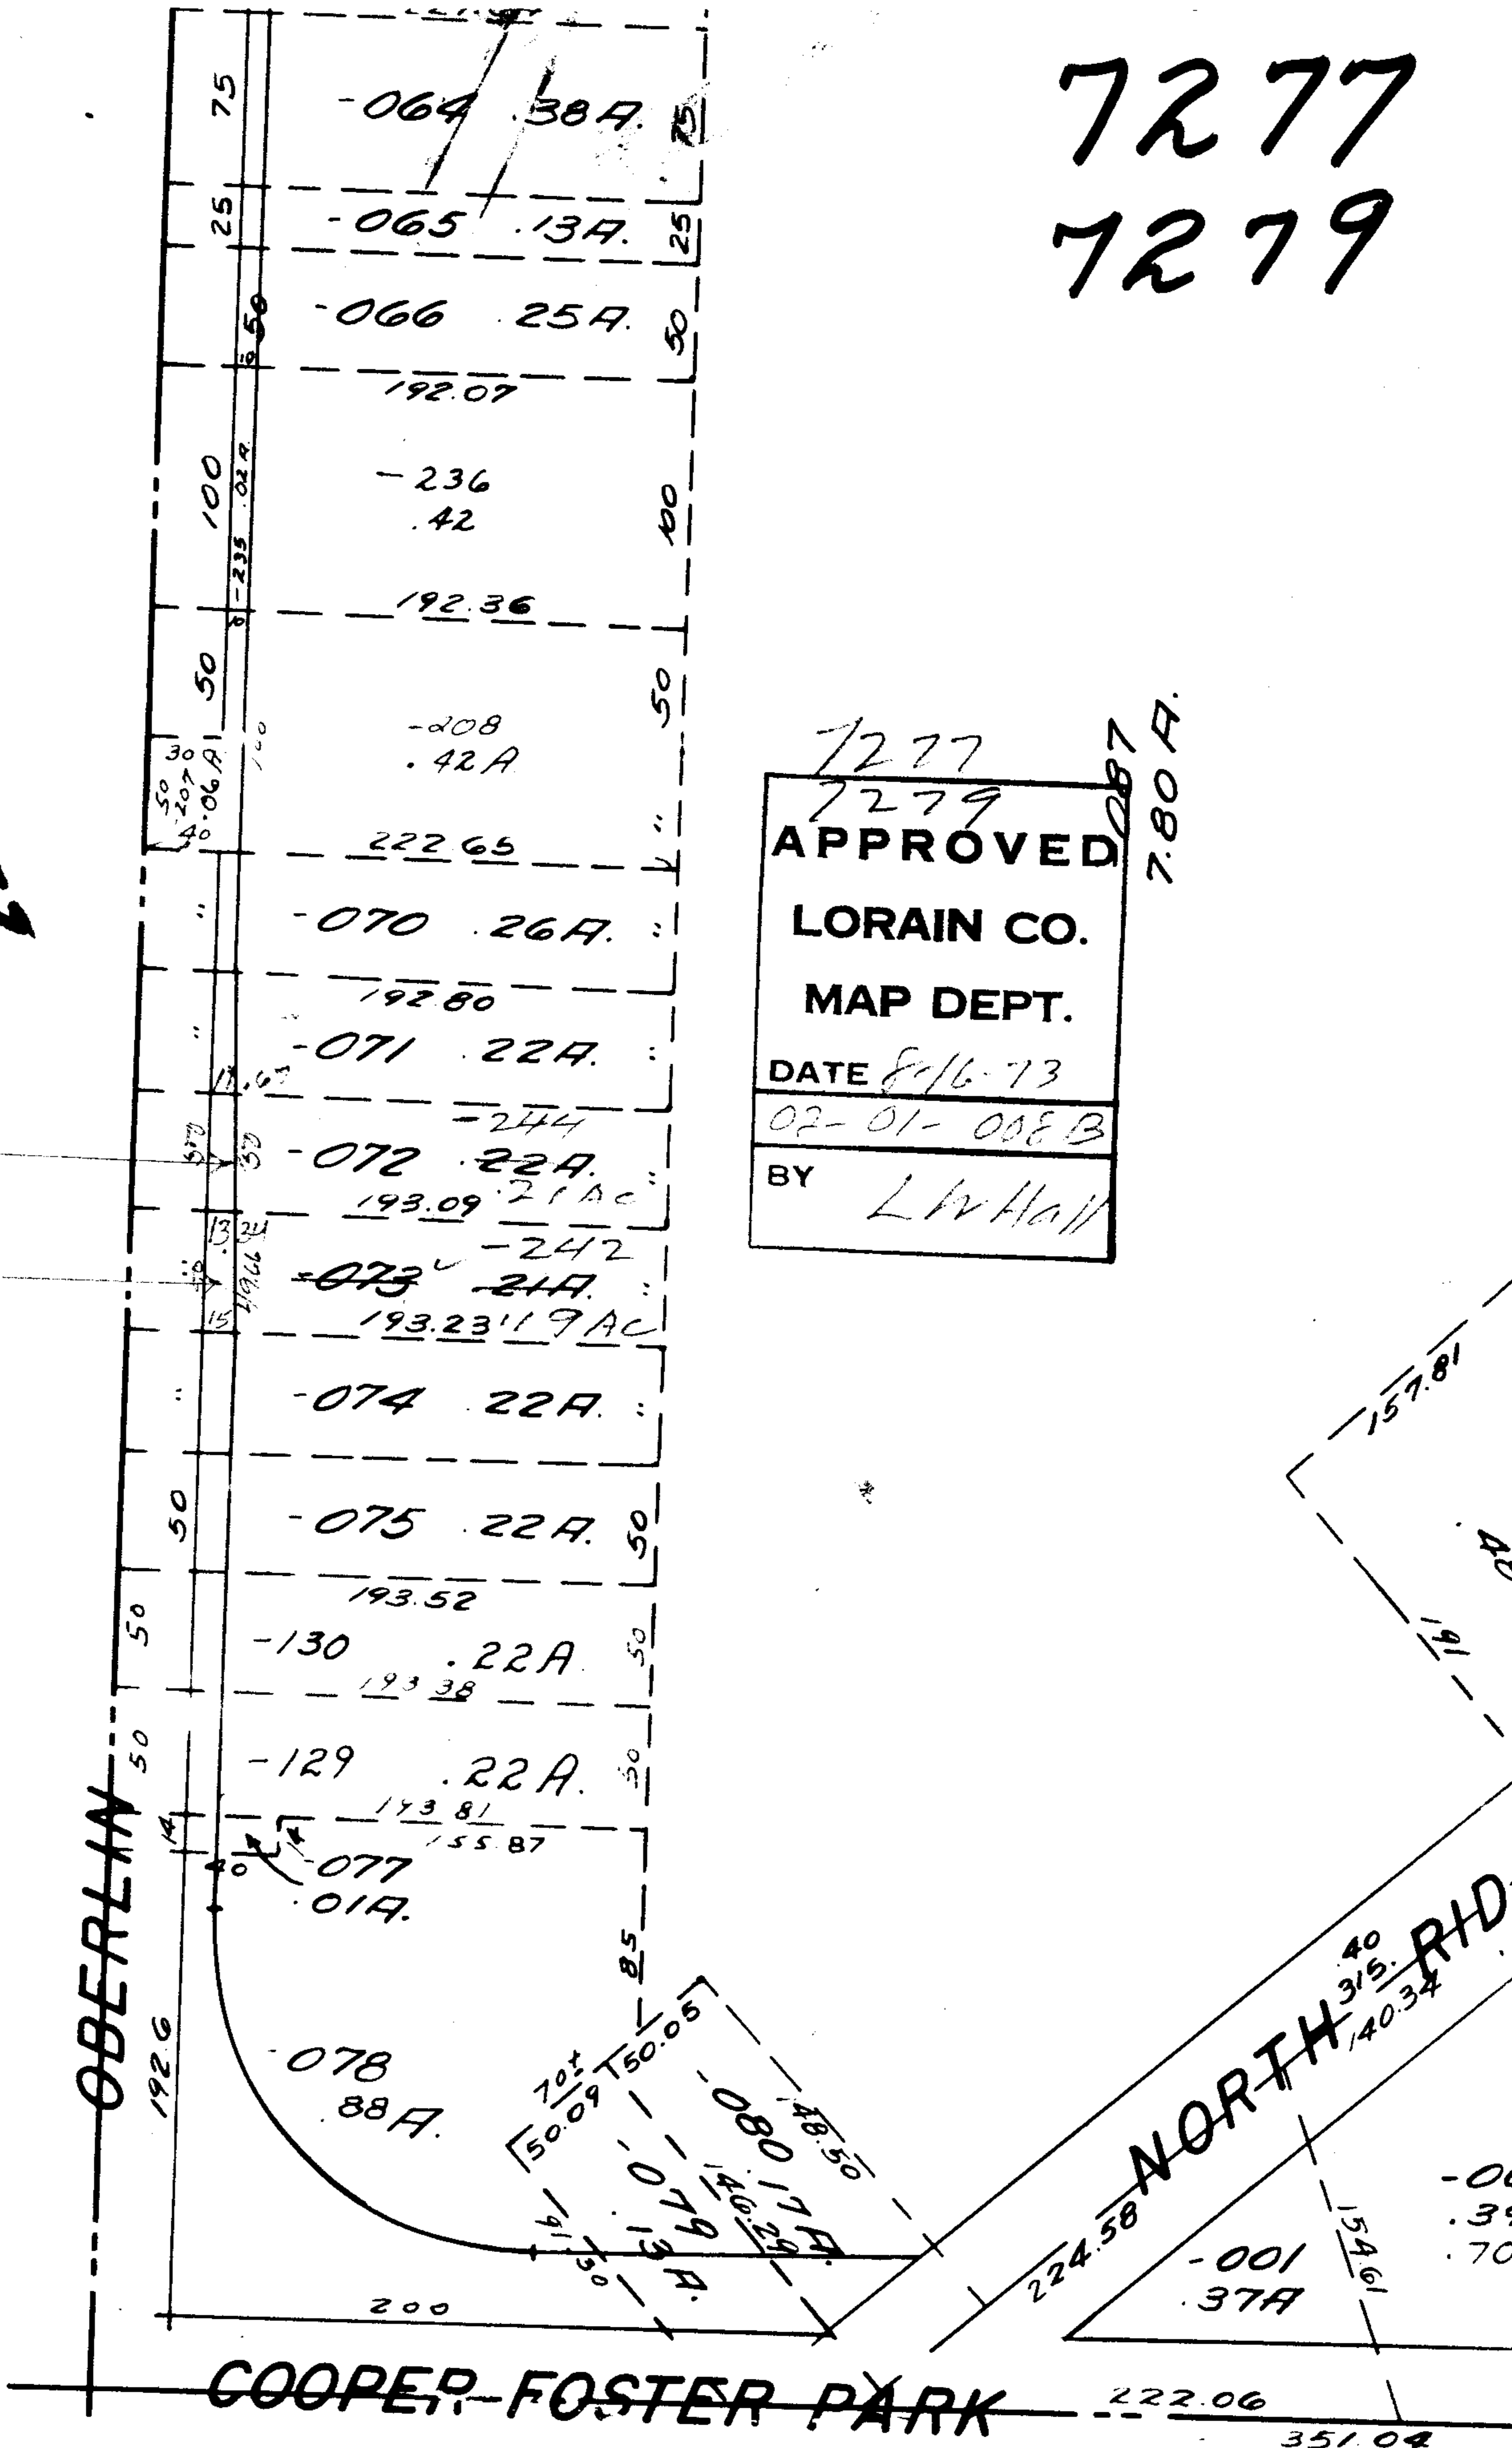

SEE