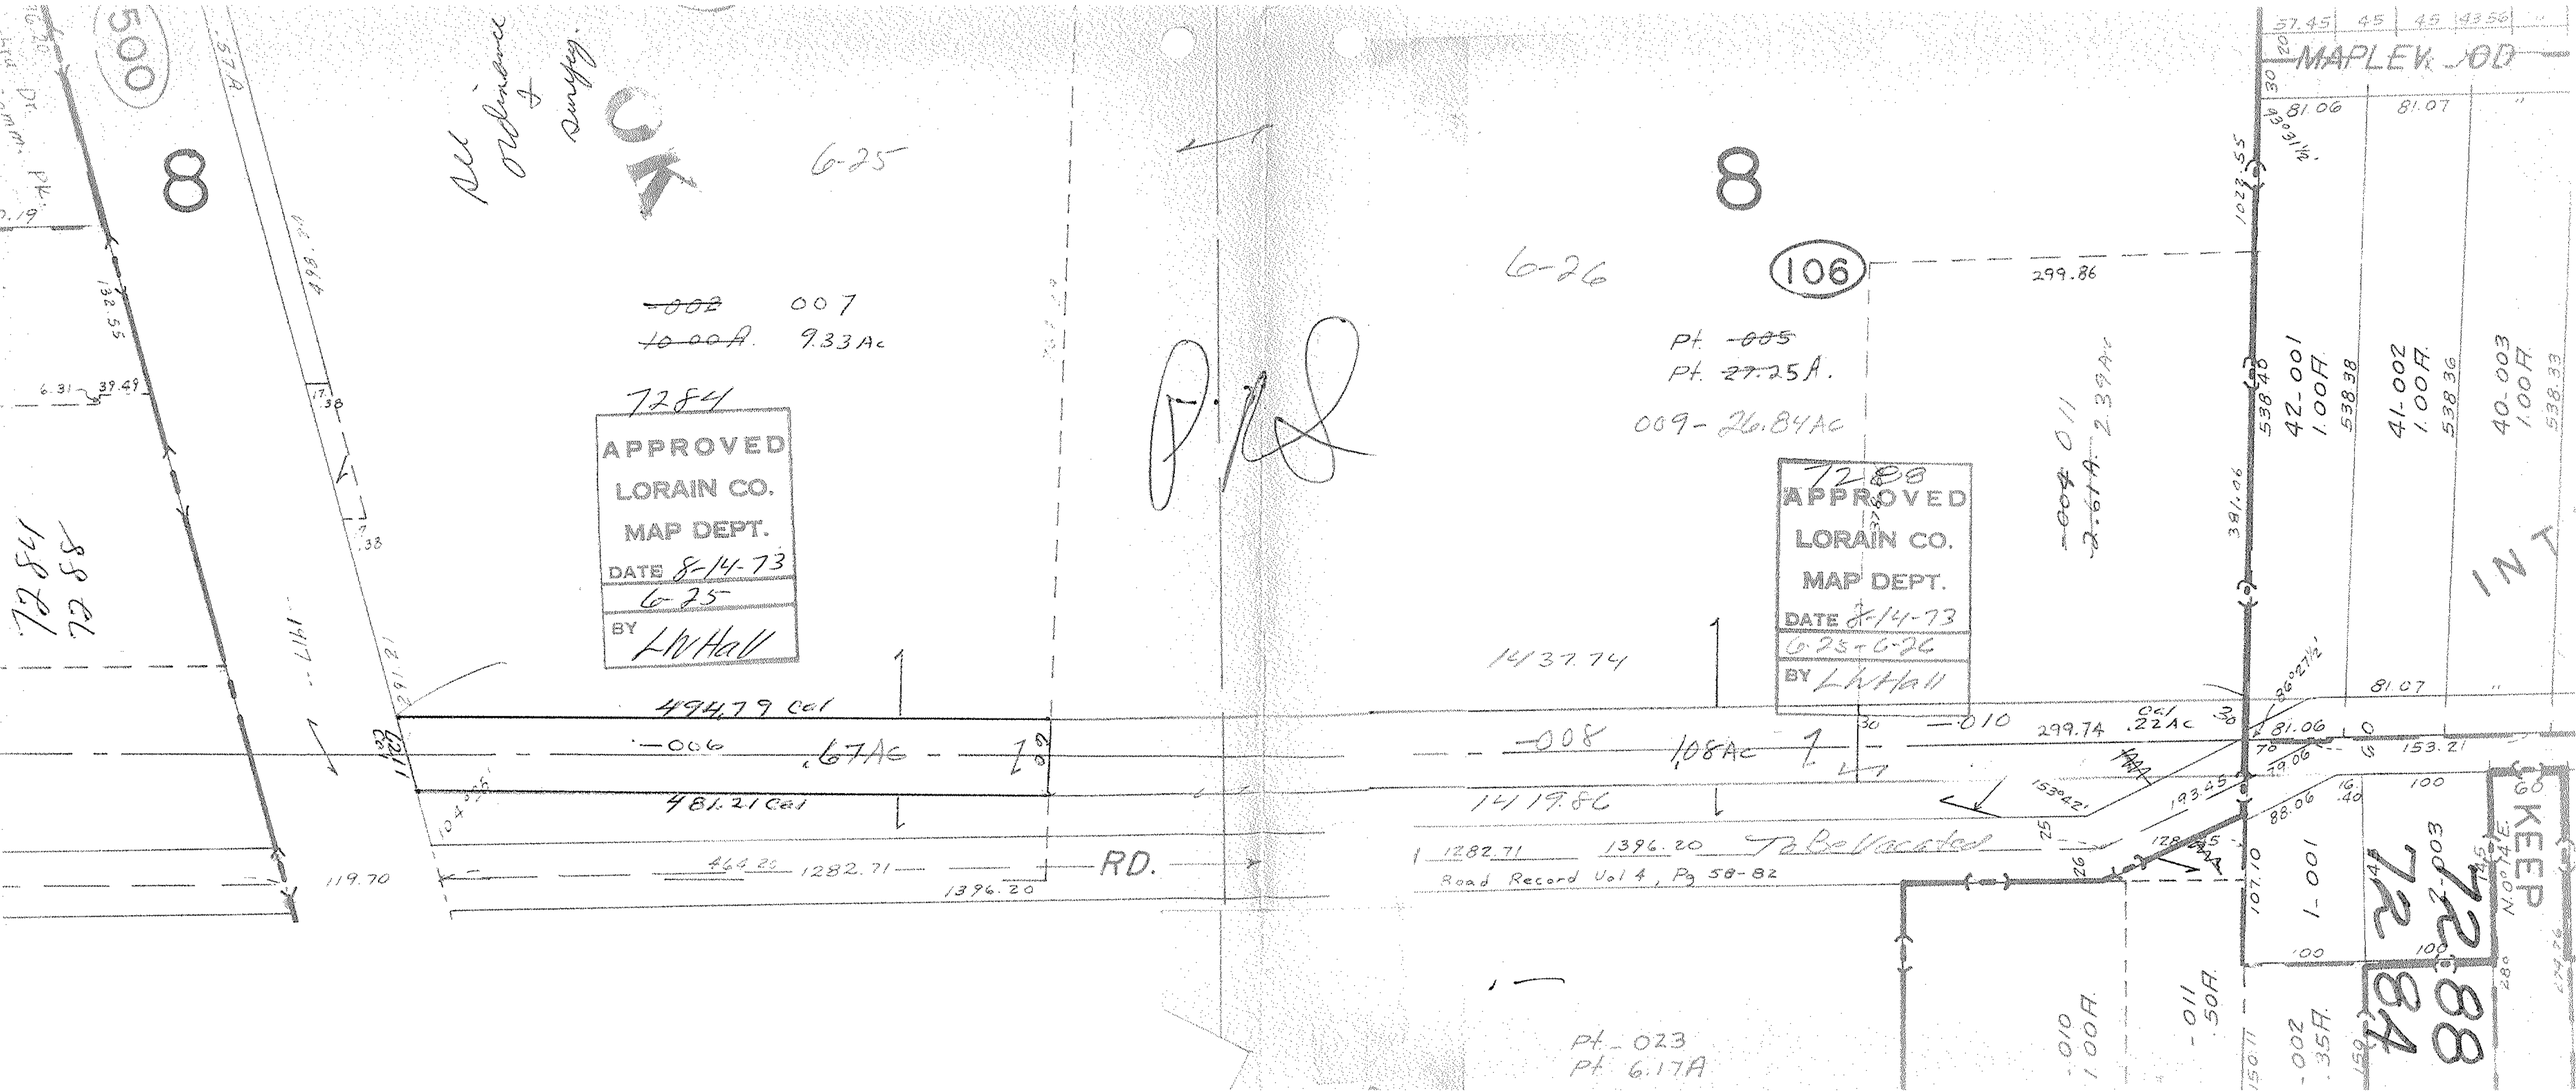

8
500
8
106
6-25
6-26
~~.002~~ 007
~~10.00A.~~ 9.33Ac
7284
APPROVED
LORAIN CO.
MAP DEPT.
DATE 8-14-73
6-25
BY LWHall
Pt. ~~.005~~
Pt. ~~27.25A.~~
009-26.84Ac
7288
APPROVED
LORAIN CO.
MAP DEPT.
DATE 8-14-73
6-25-6-26
BY LWHall
MAPLEWOOD
494.79 Cal
-006
.67Ac
481.21 Cal
1437.74
-008
1.08Ac
1419.86
-010
299.74
Cal .22Ac
1282.71
1396.20
RD.
To Be Vacated
Road Record Vol 4, Pg 58-82
Pt. 023
Pt. 6.17A
42-001
1.00A.
41-002
1.00A.
40-003
1.00A.
1-001
2-003
7288
7284
KEEP