

Handwritten scribbles in the top left corner.

7285
7305

7-29-86 L.H.

7305
7285


APPROVED
LORAIN CO.
MAP DEPT.

DATE 8-15-73

4-00-001-A

BY *J. G. Miller*

2.98
62
 2.36
59
 1.82
46
 1.36

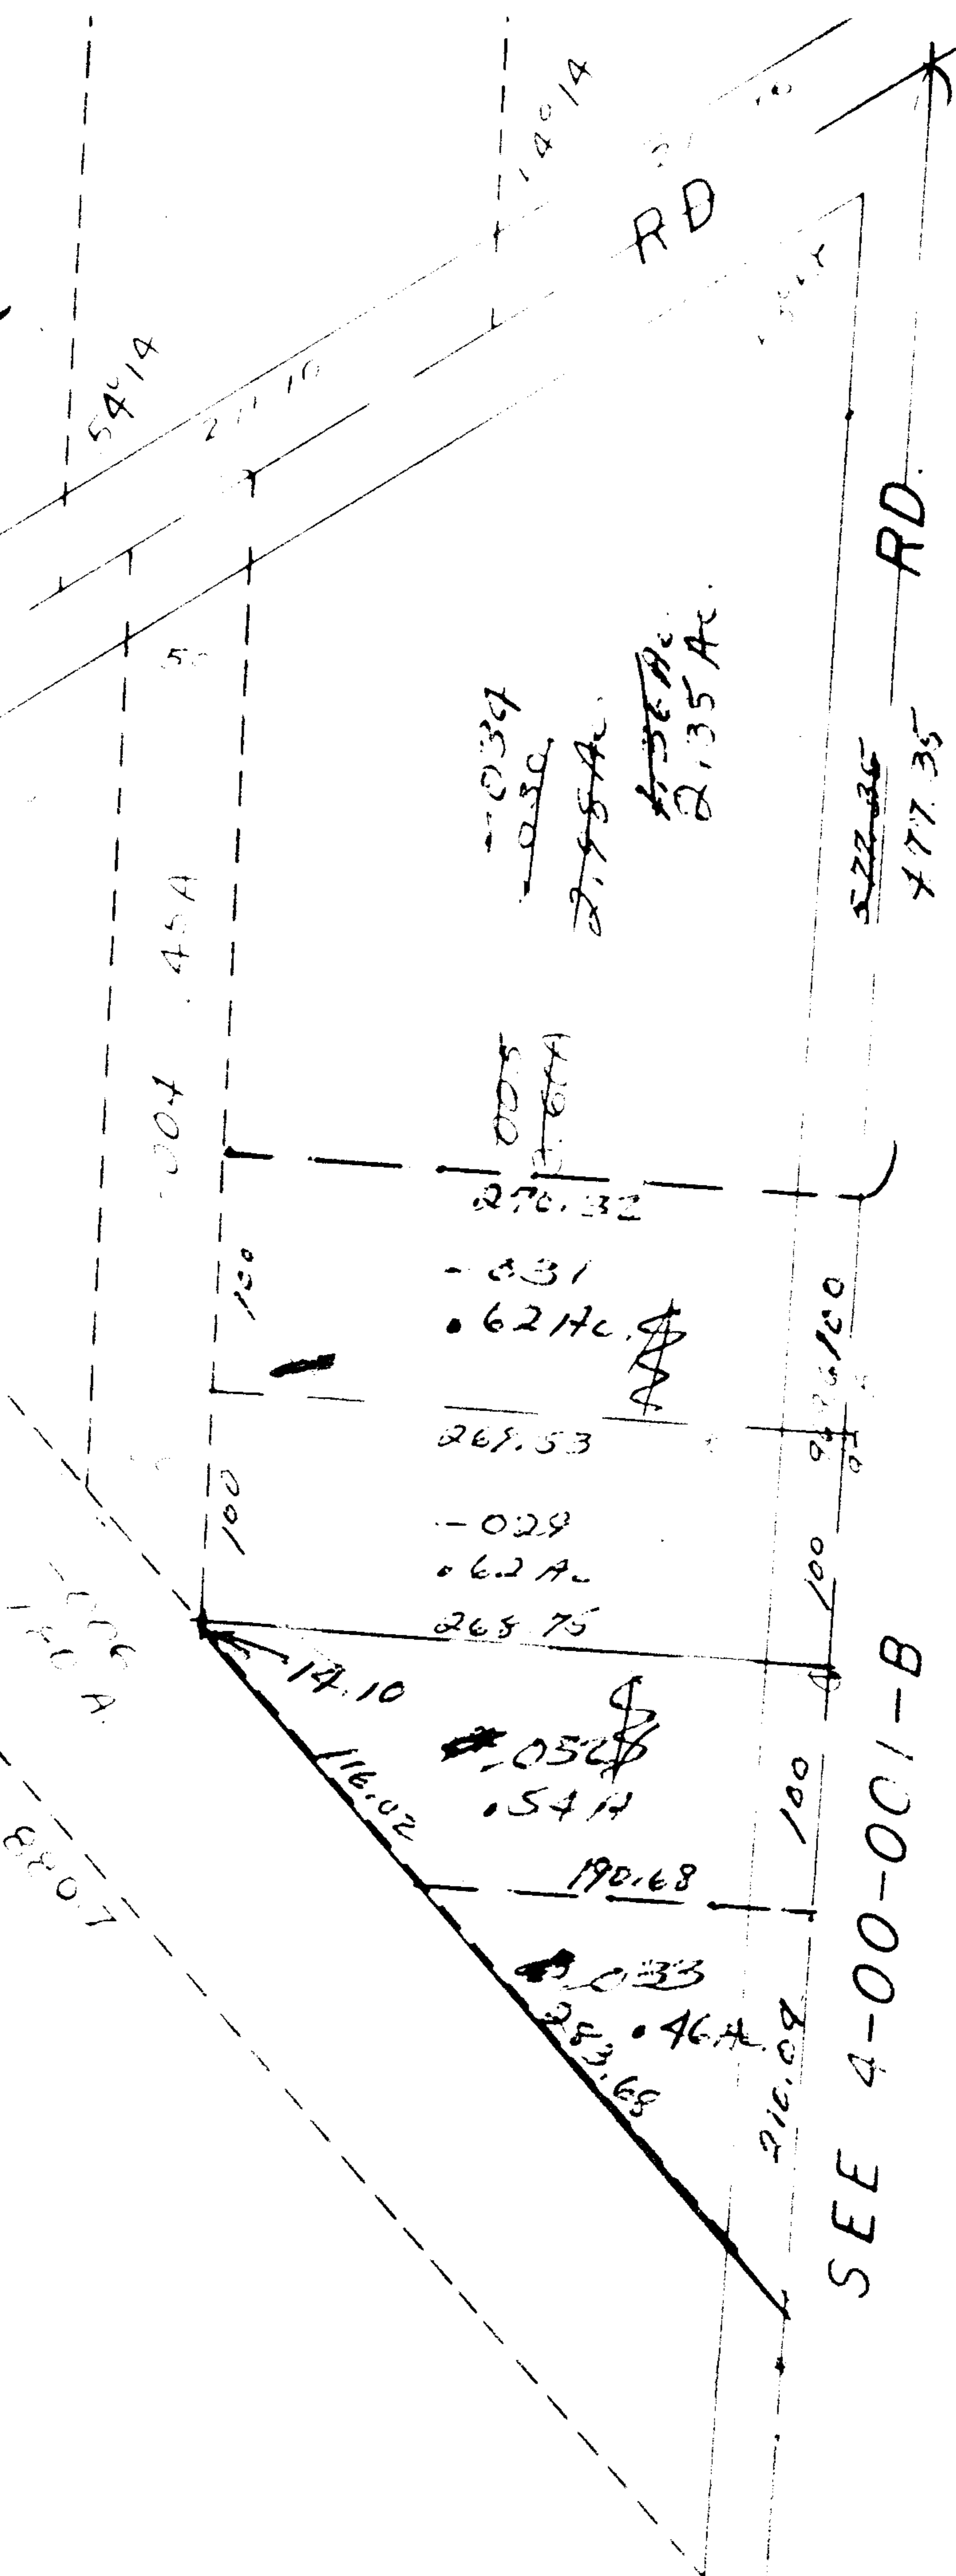

SEE 4-00-001-B

ALON

*250 x 270
 100 x 270*