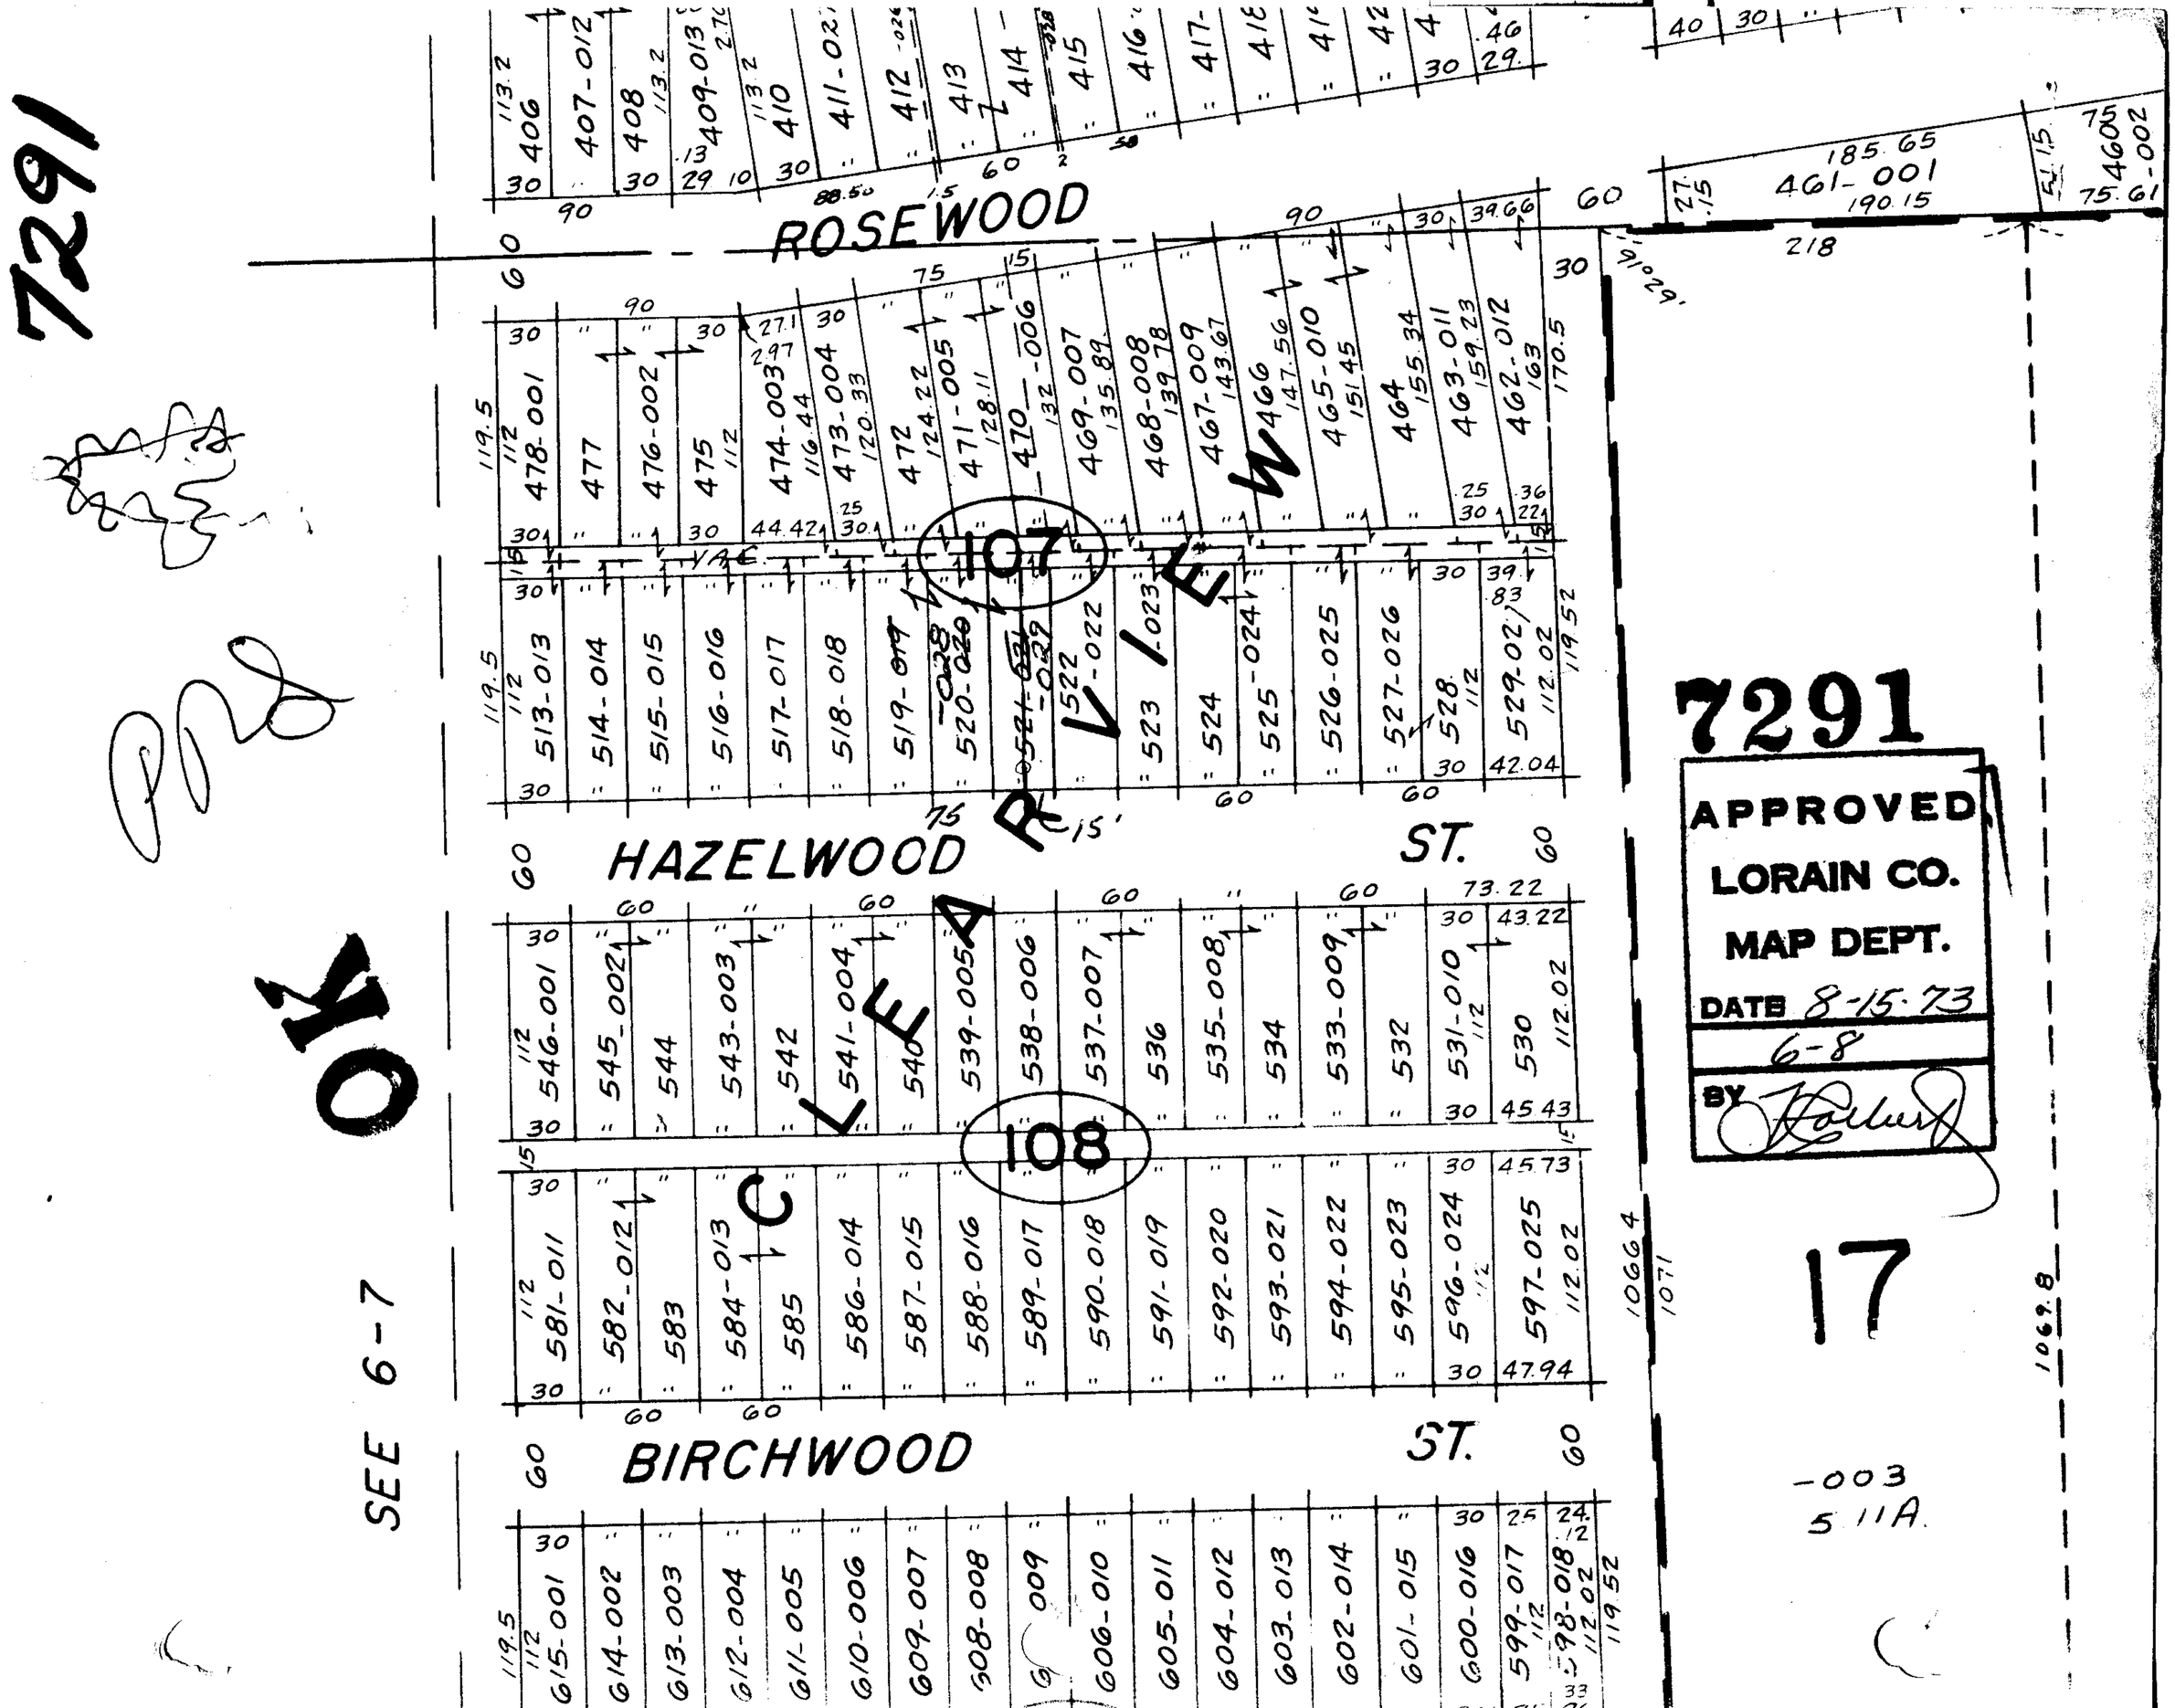
7291
OK
SEE 6-7
ROSEWOOD
HAZELWOOD ST.
BIRCHWOOD ST.
CLEAR VIEW
107
108
7291
APPROVED
LORAIN CO.
MAP DEPT.
DATE 8-15-73
6-8
BY
17
-003
5.11A.