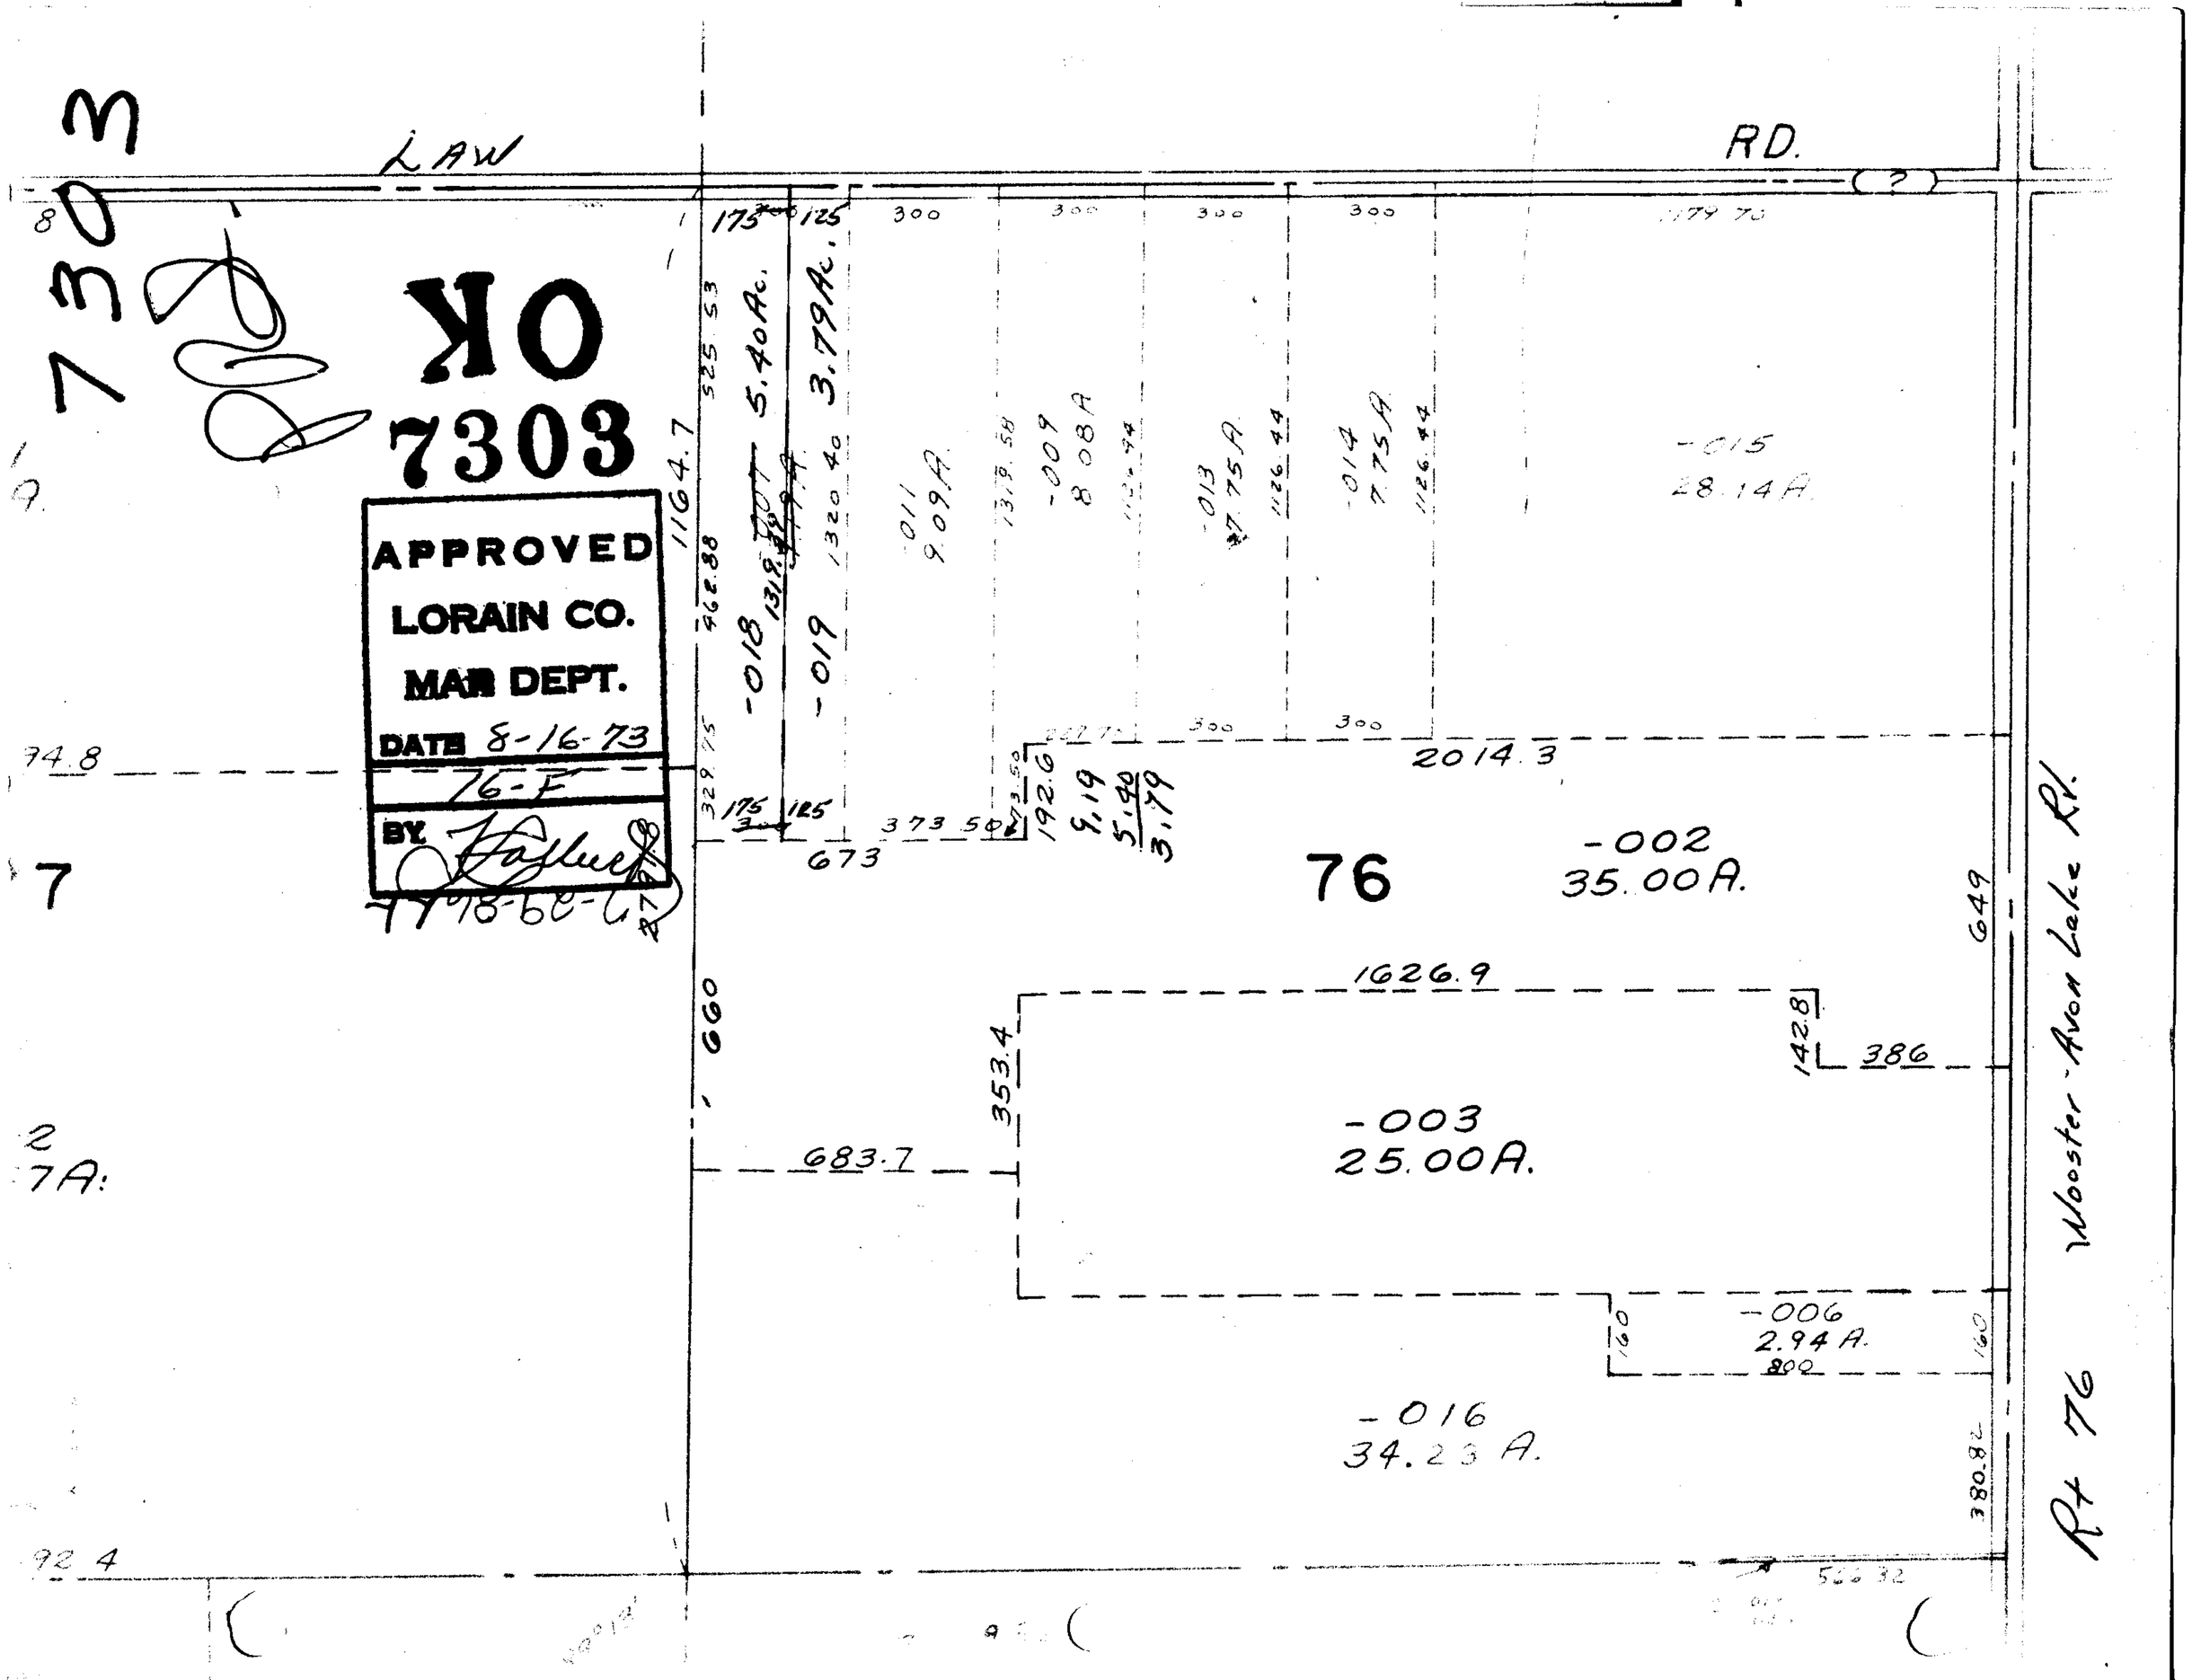

7303
LAW
RD.
OK
7303
APPROVED
LORAIN CO.
MAP DEPT.
DATE 8-16-73
76-F
BY
-018
5.40 Ac.
-019
3.79 Ac.
-011
9.09 A.
-009
8.08 A.
-013
7.75 A.
-014
7.75 A.
-015
28.14 A.
2014.3
76
-002
35.00 A.
1626.9
-003
25.00 A.
-006
2.94 A.
-016
34.23 A.
683.7
353.4
1164.7
Wooster-Avon Lake Rd.
Rt 76