


7320

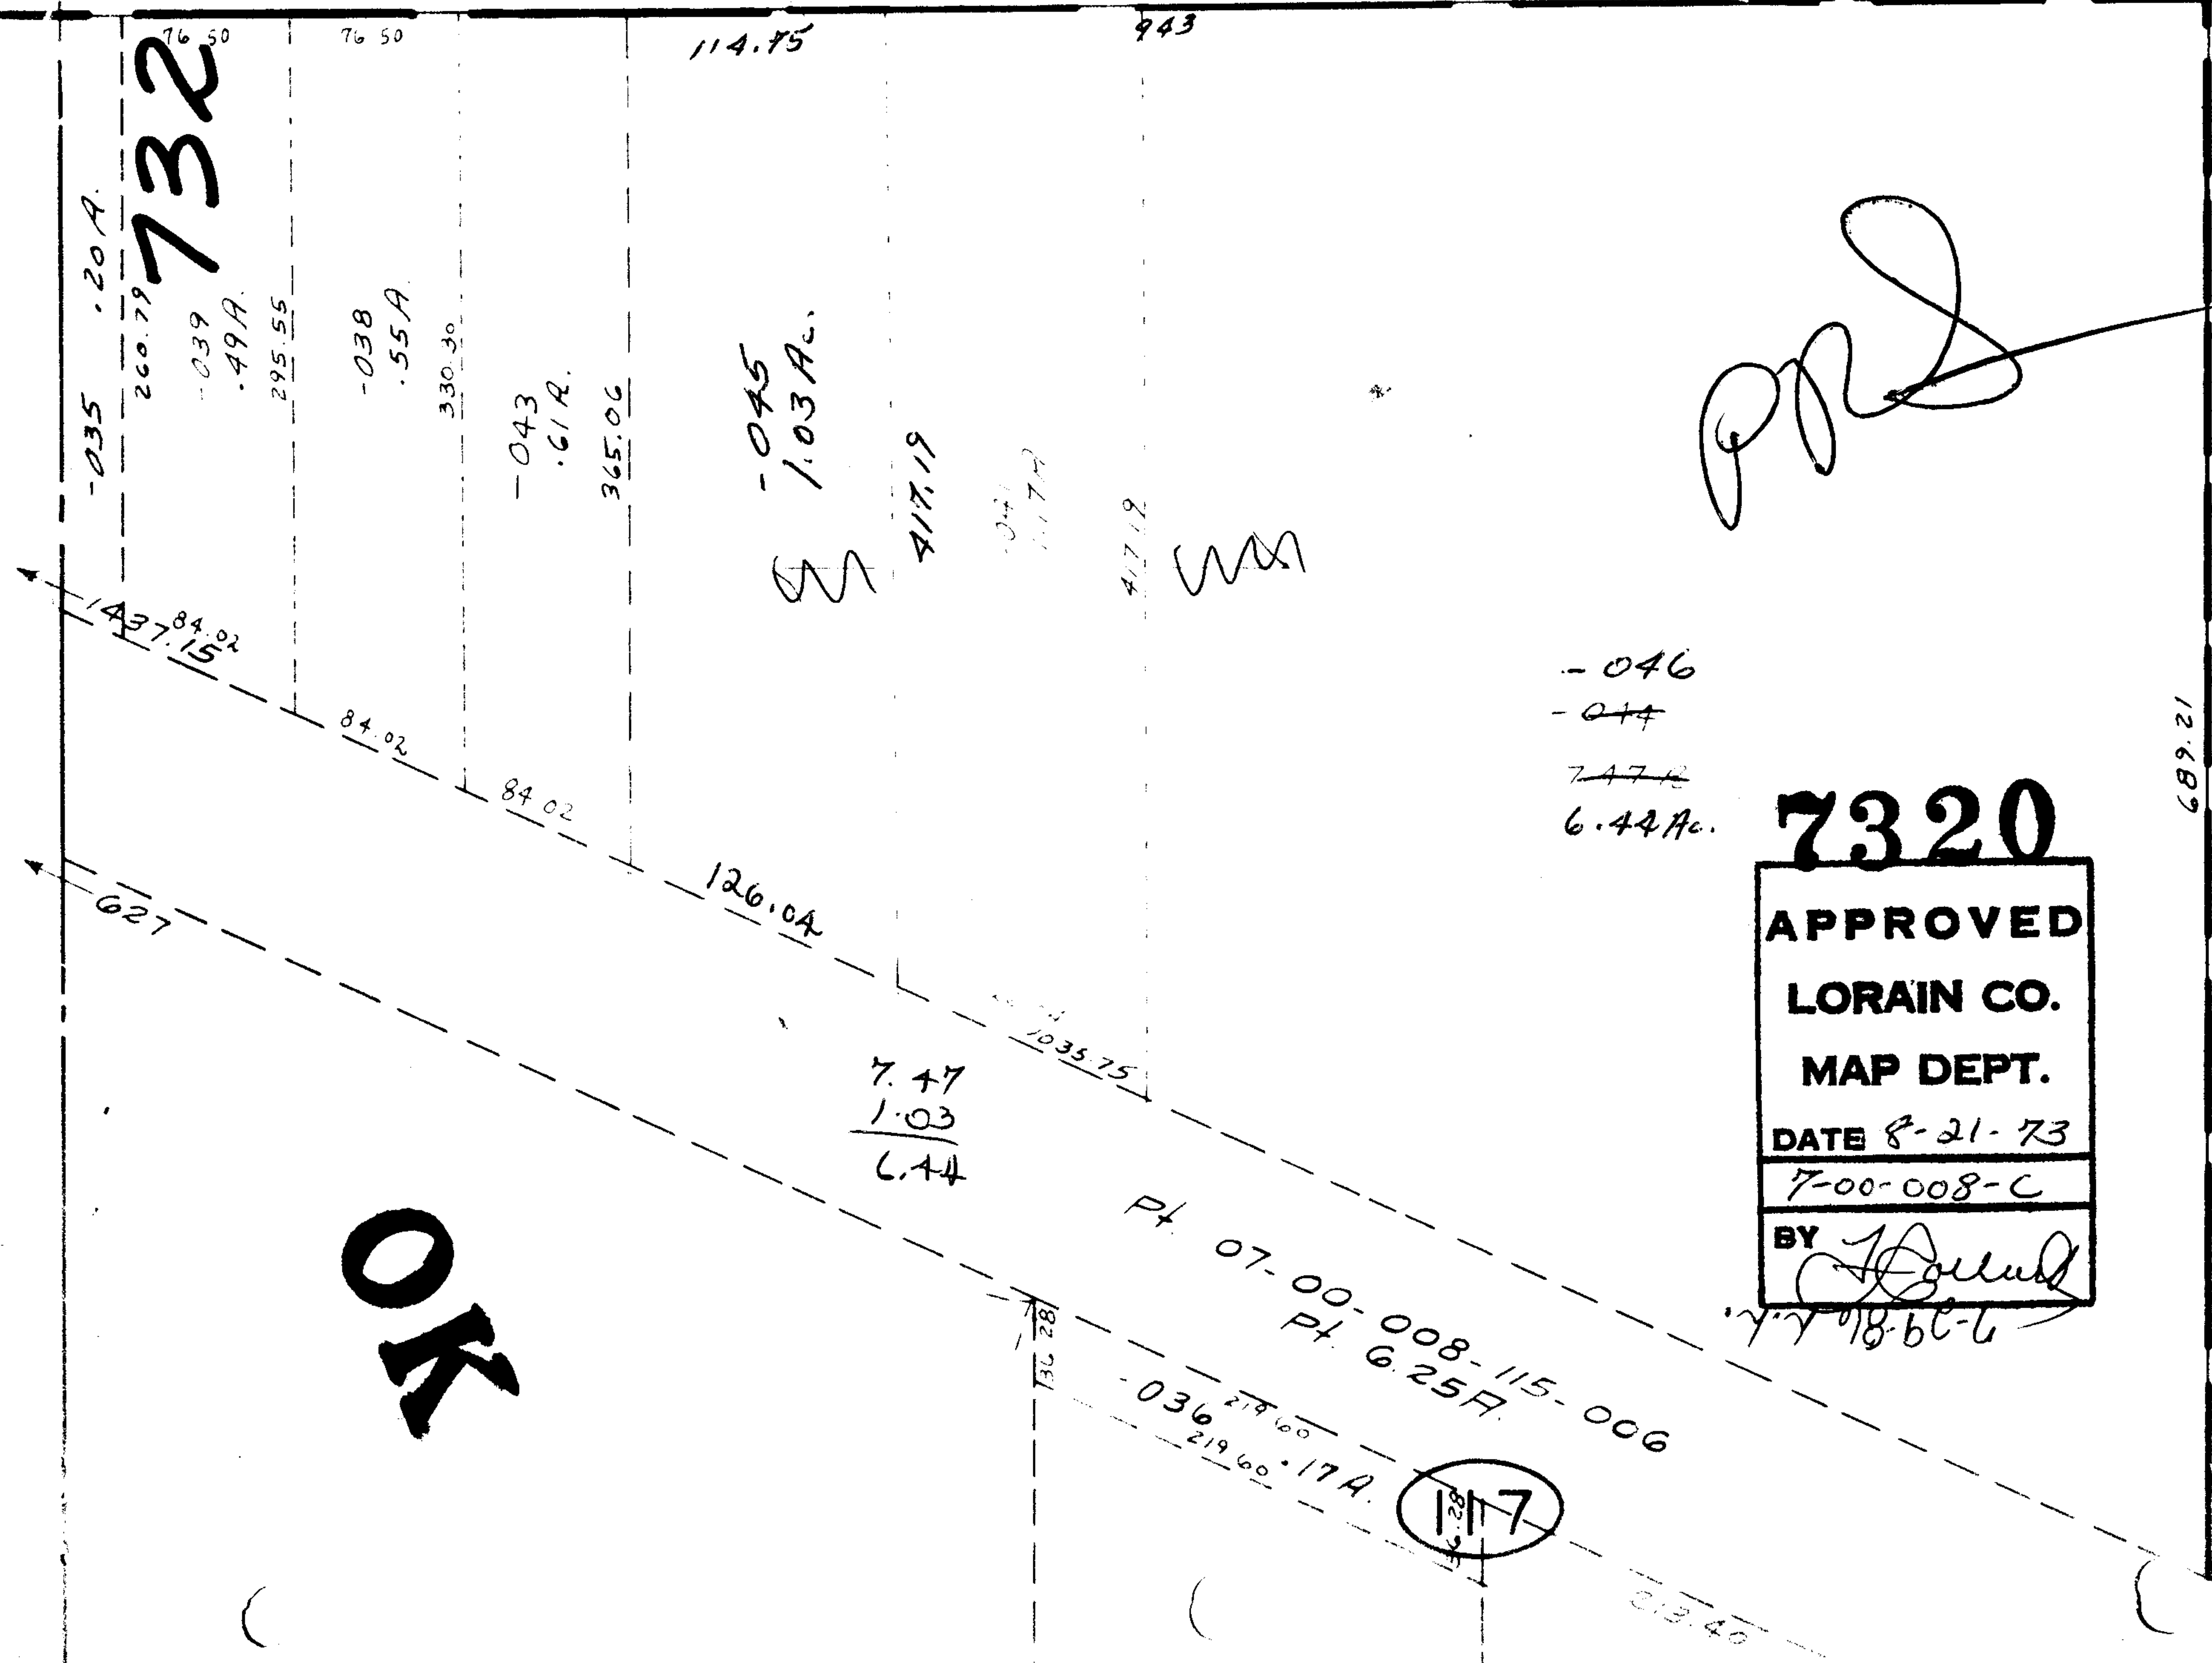

OK

**7320**  
**APPROVED**  
**LORAIN CO.**  
**MAP DEPT.**  
**DATE 8-21-73**  
**7-00-008-C**  
**BY** *Hollud*

Pt. 07-00-008-115-006  
 Pt. 6.25A  
 -036 219.60  
 219.60 17A

117


