7323

3-00-011-B

See also 3-00-012B

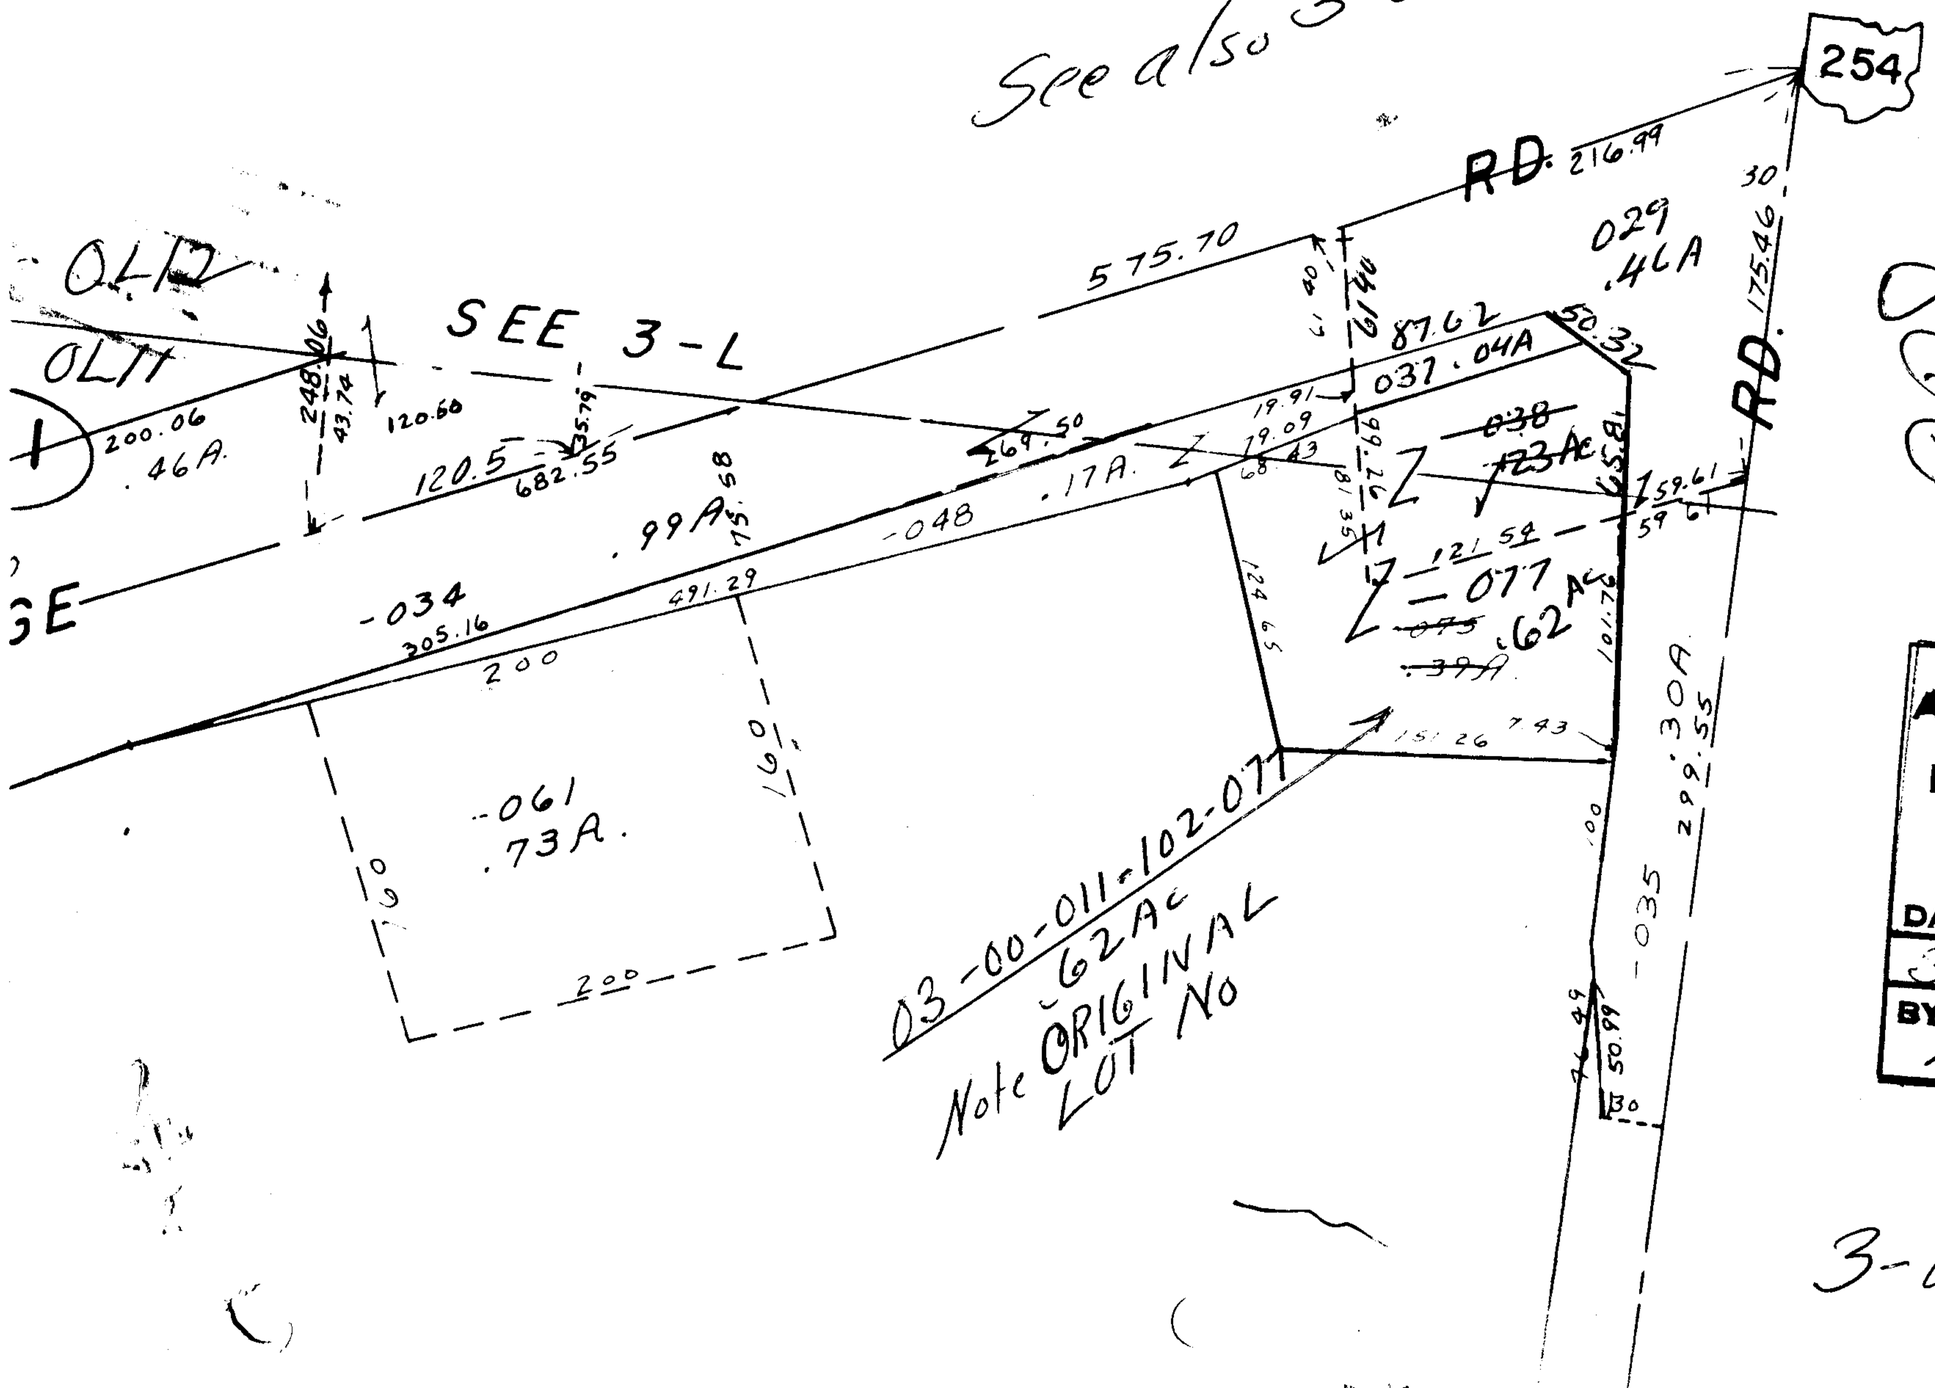

OK

7323

APPROVED
LORAIN CO.
MAP DEPT.
DATE 8-21-73
3-00-011B
BY L W Hall

3-00-011A