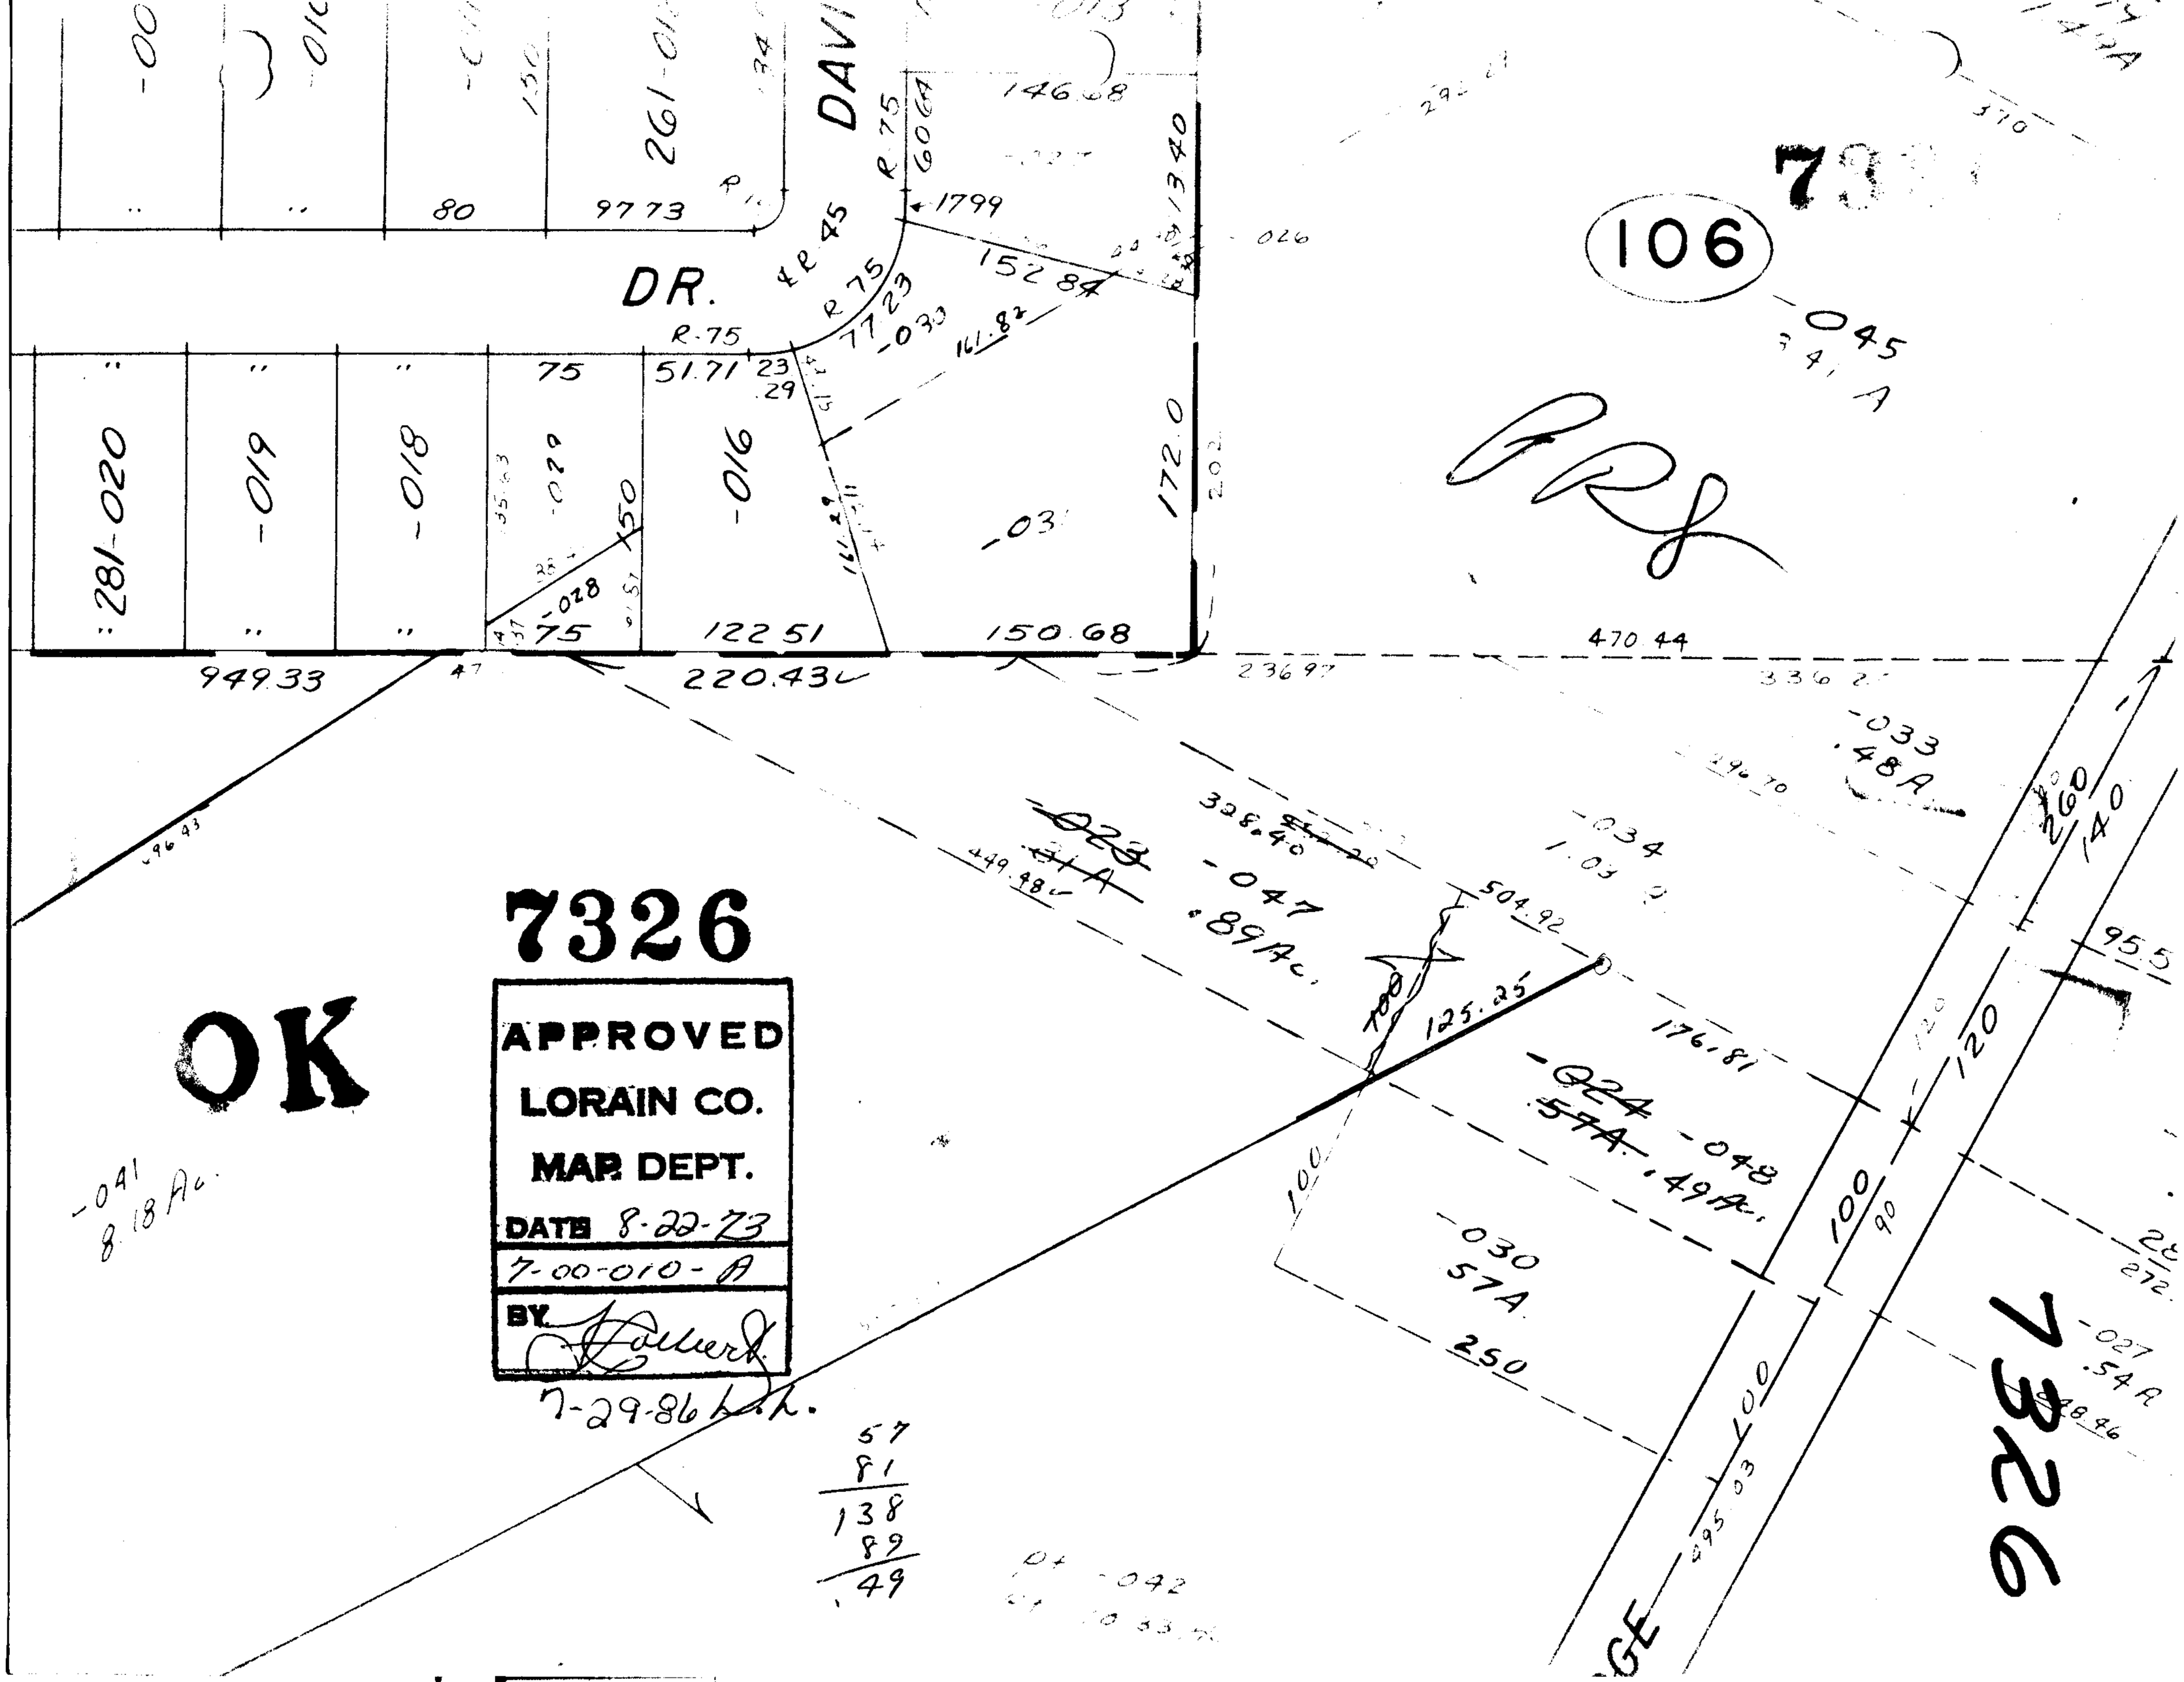

DR.
106
7326
OK
APPROVED
LORAIN CO.
MAP DEPT.
DATE 8-22-73
7-00-010-A
BY
7-29-86
-045
-033
.48A
-047
.89Ac.
-024
.57A
-048
.49Ac.
-030
57A
-041
8.18 Ac.
-027
.54A
-042
-016
-018
-019
281-020
949.33
220.43
470.44
172.0
150.68
122.51
152.84
146.68
95.5
57
81
138
89
.49