


7336

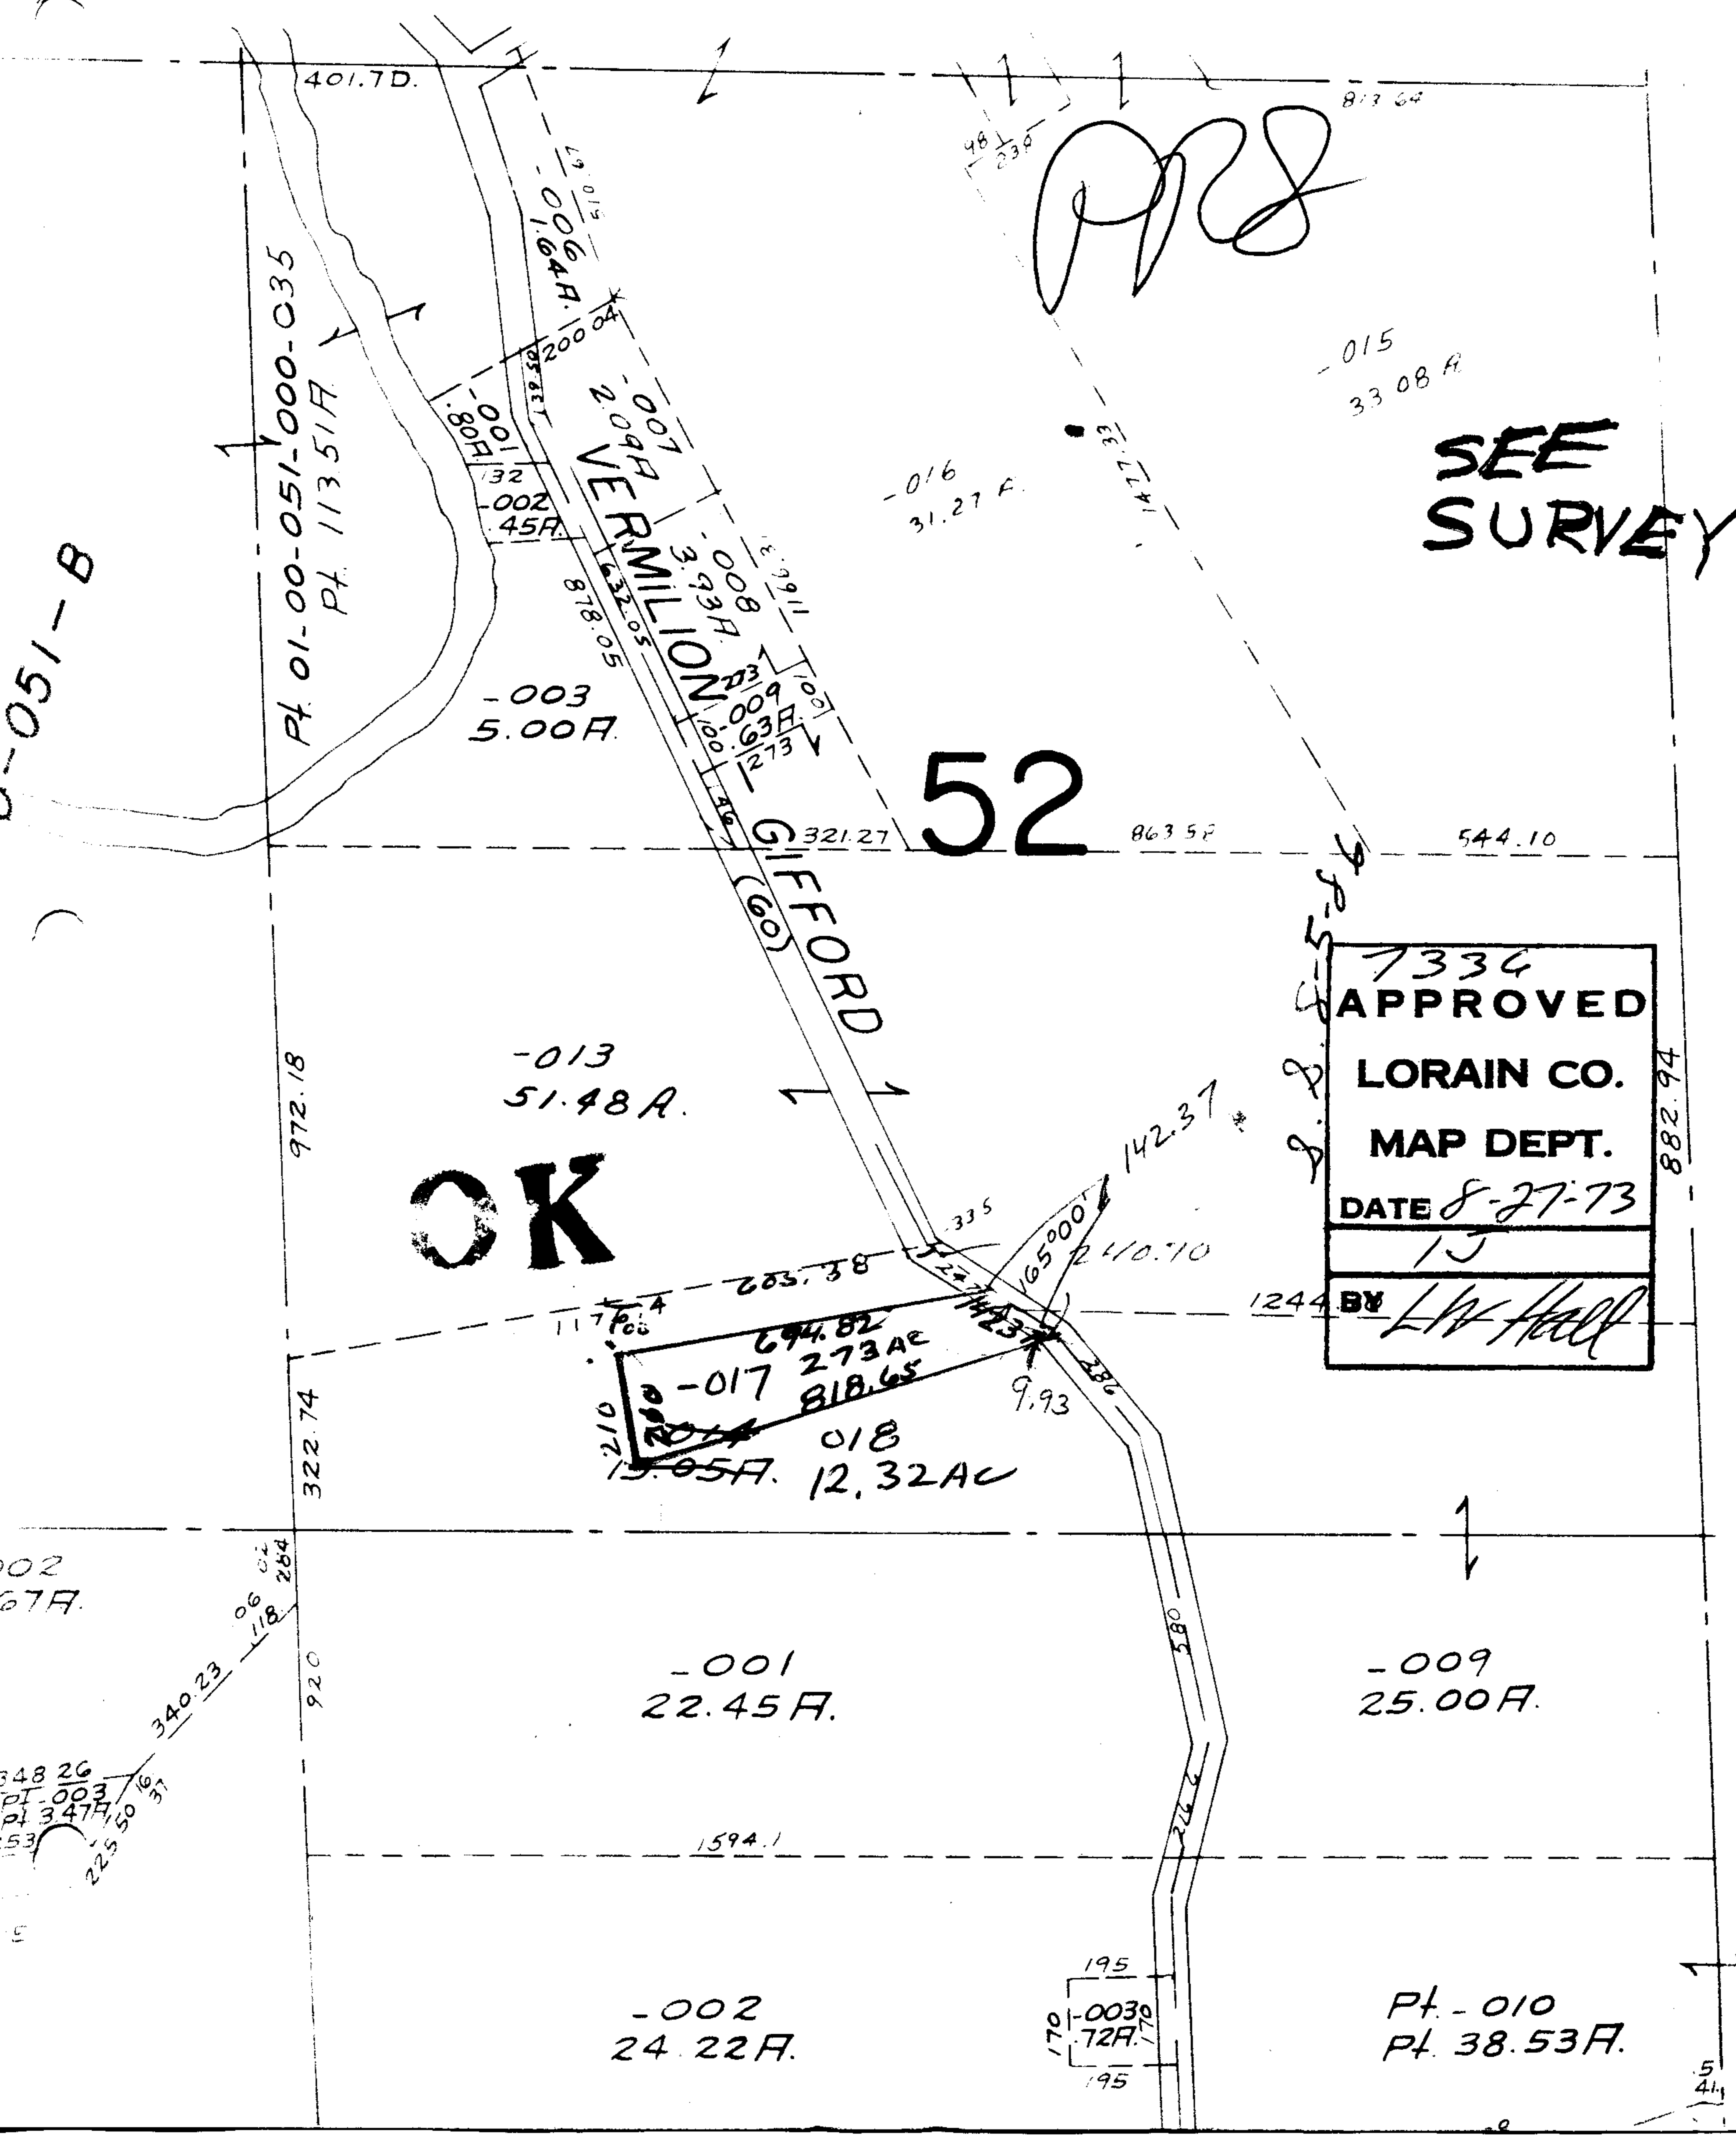

*Handwritten signature*

**SEE SURVEY**

**52**

**OK**

7336  
**APPROVED**  
**LORAIN CO.**  
**MAP DEPT.**  
**DATE 8-27-73**  
 13  
 BY *L. W. Hall*

0-051-B

PT. 01-00-051-000-035  
PT. 113.51 A.

VERMILION

GILFORD

348 26  
 PT. 003  
 PT. 347 A.  
 225.50  
 340.23  
 118.284  
 920

-001  
22.45 A.

-002  
24.22 A.

-009  
25.00 A.

PT. -010  
PT. 38.53 A.

195  
 170  
 -0030  
 72 A.  
 195

882.94

*Handwritten notes*