


7350

GIFFORD

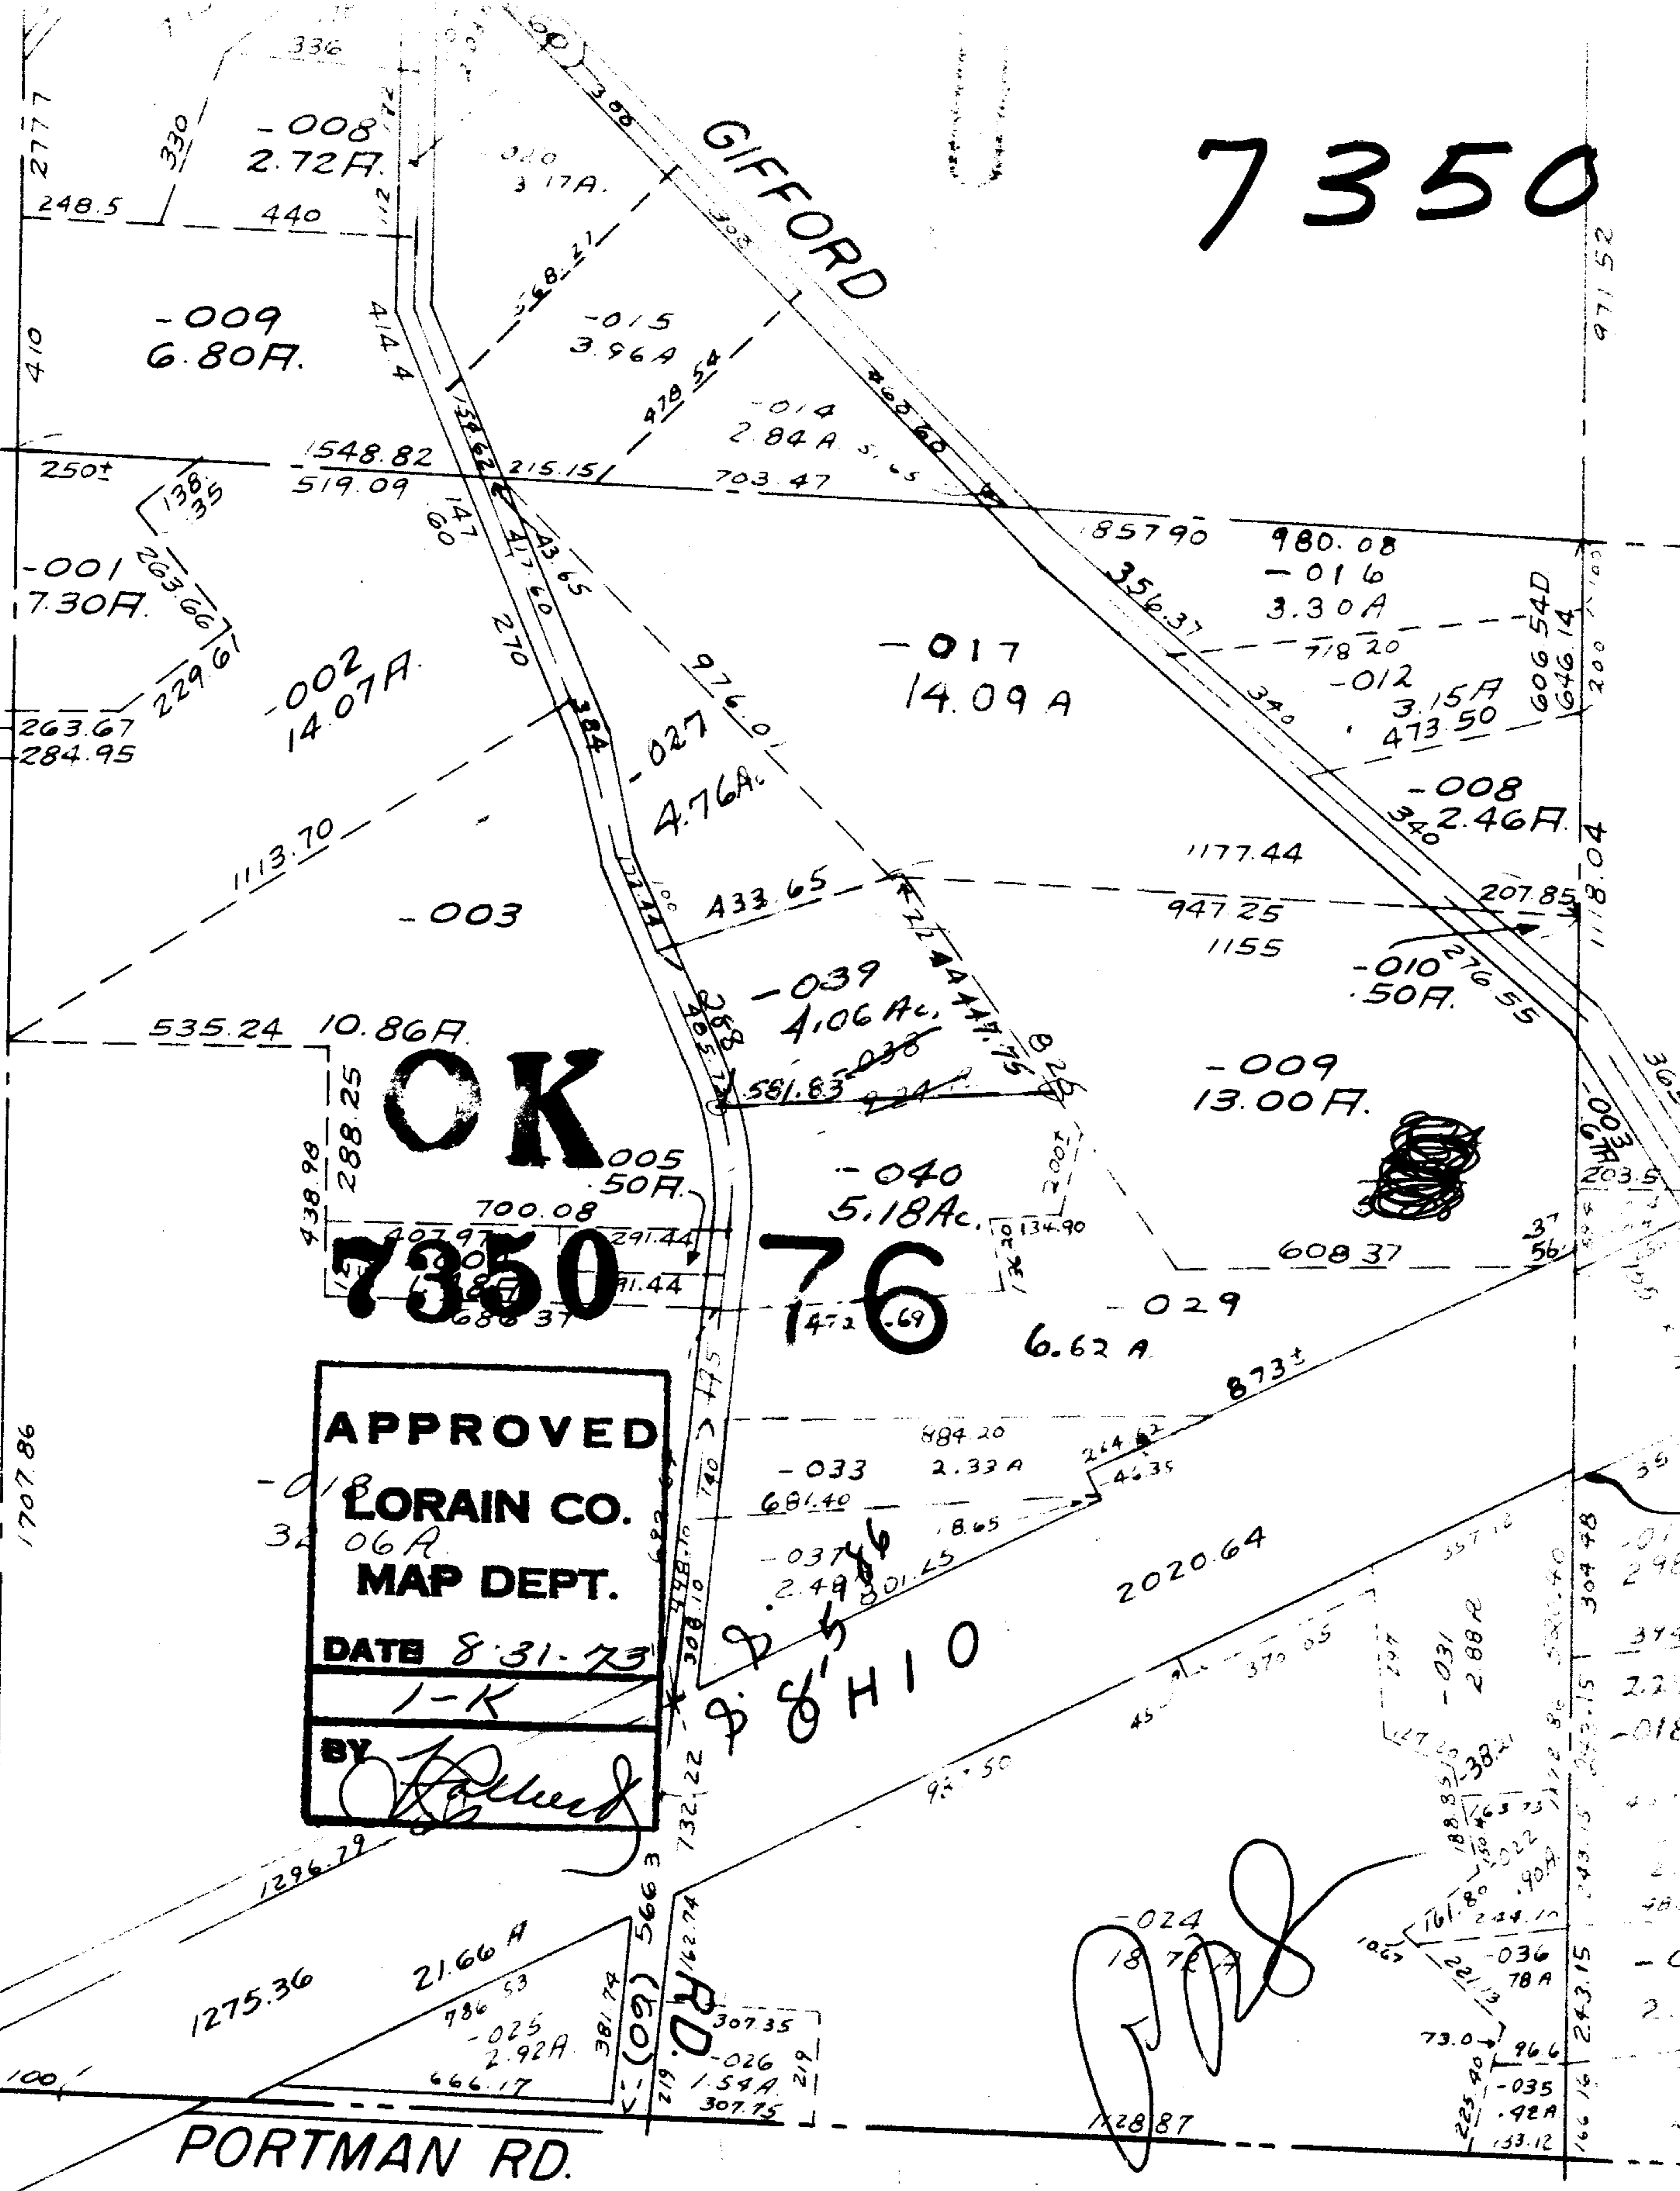

APPROVED
LORAIN CO.
MAP DEPT.
DATE 8-31-73
 1-K
 BY *[Signature]*

OK
7350

76

P & H IO

[Signature]

PORTMAN RD.

RD. (09) 563