


7351

SEE 8-C

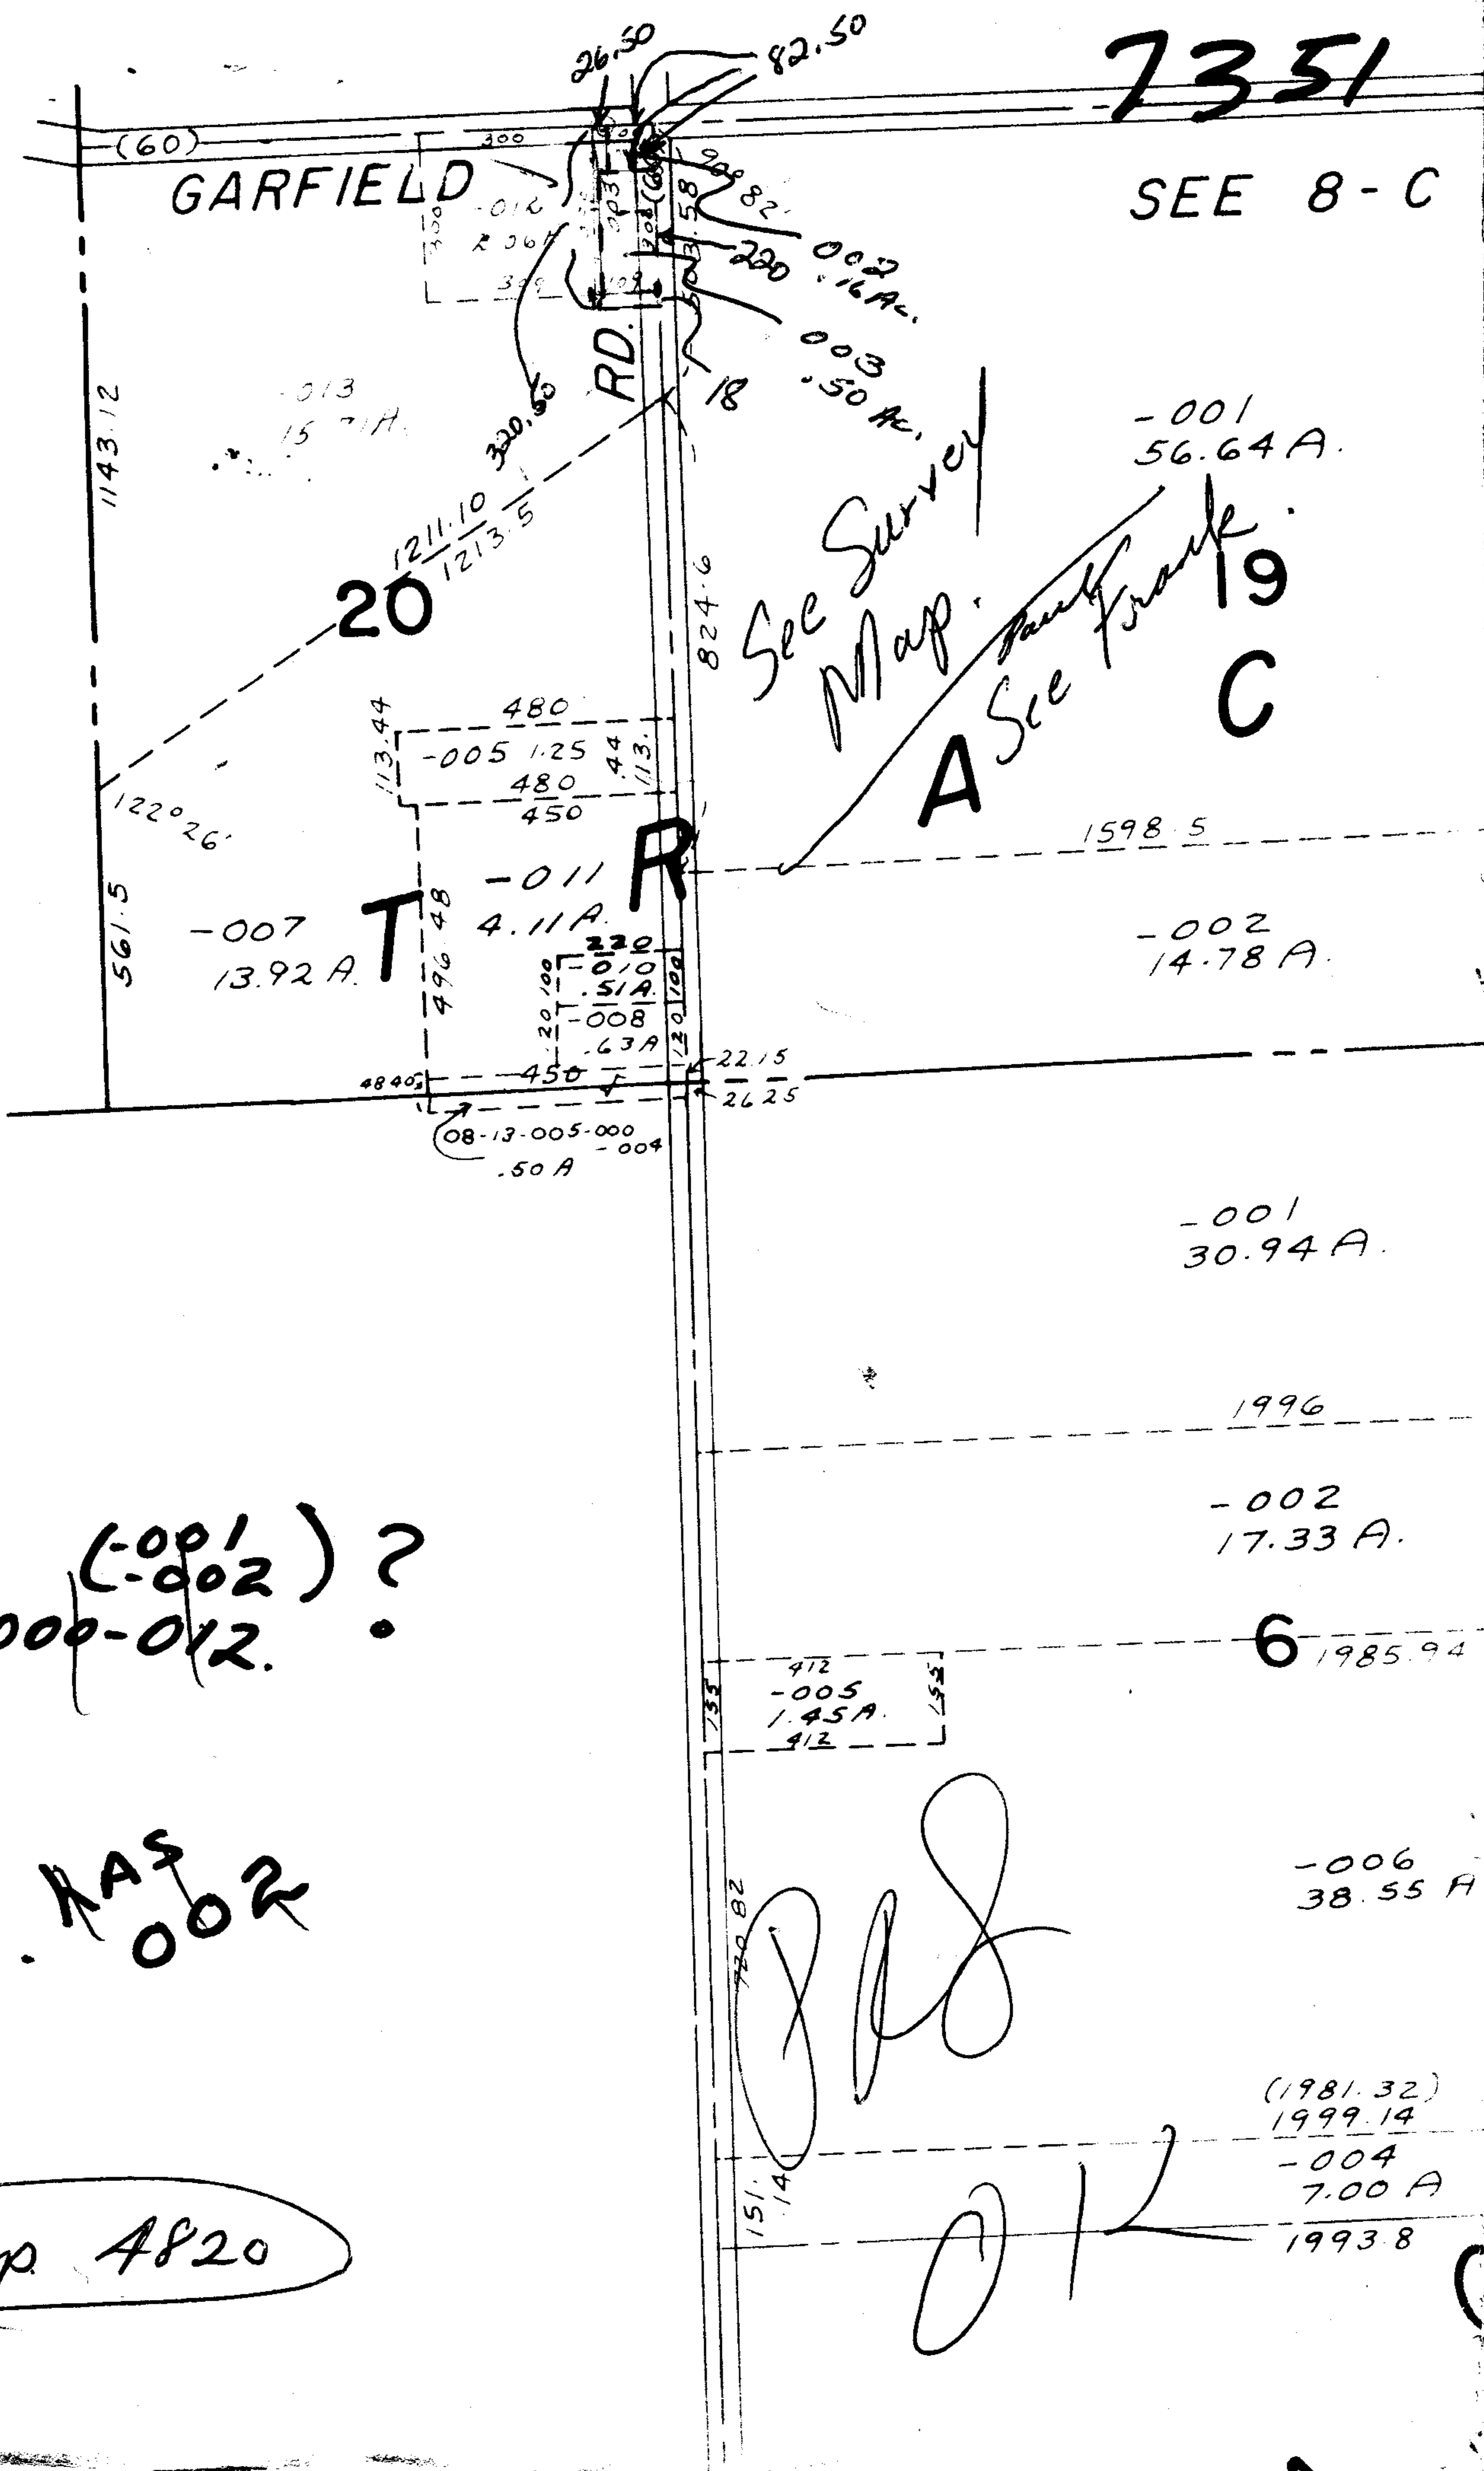

~~8-15-020-000-~~

~~Pg 8 G~~

ALSO
SEE
TRANS.
4-5-71
FOR
SPLIT.

8-15-020-000-012. (-001 / -002) ?

MIR. HAS
002

See Map 4820

[Handwritten signature]

[Handwritten signature]