#7360
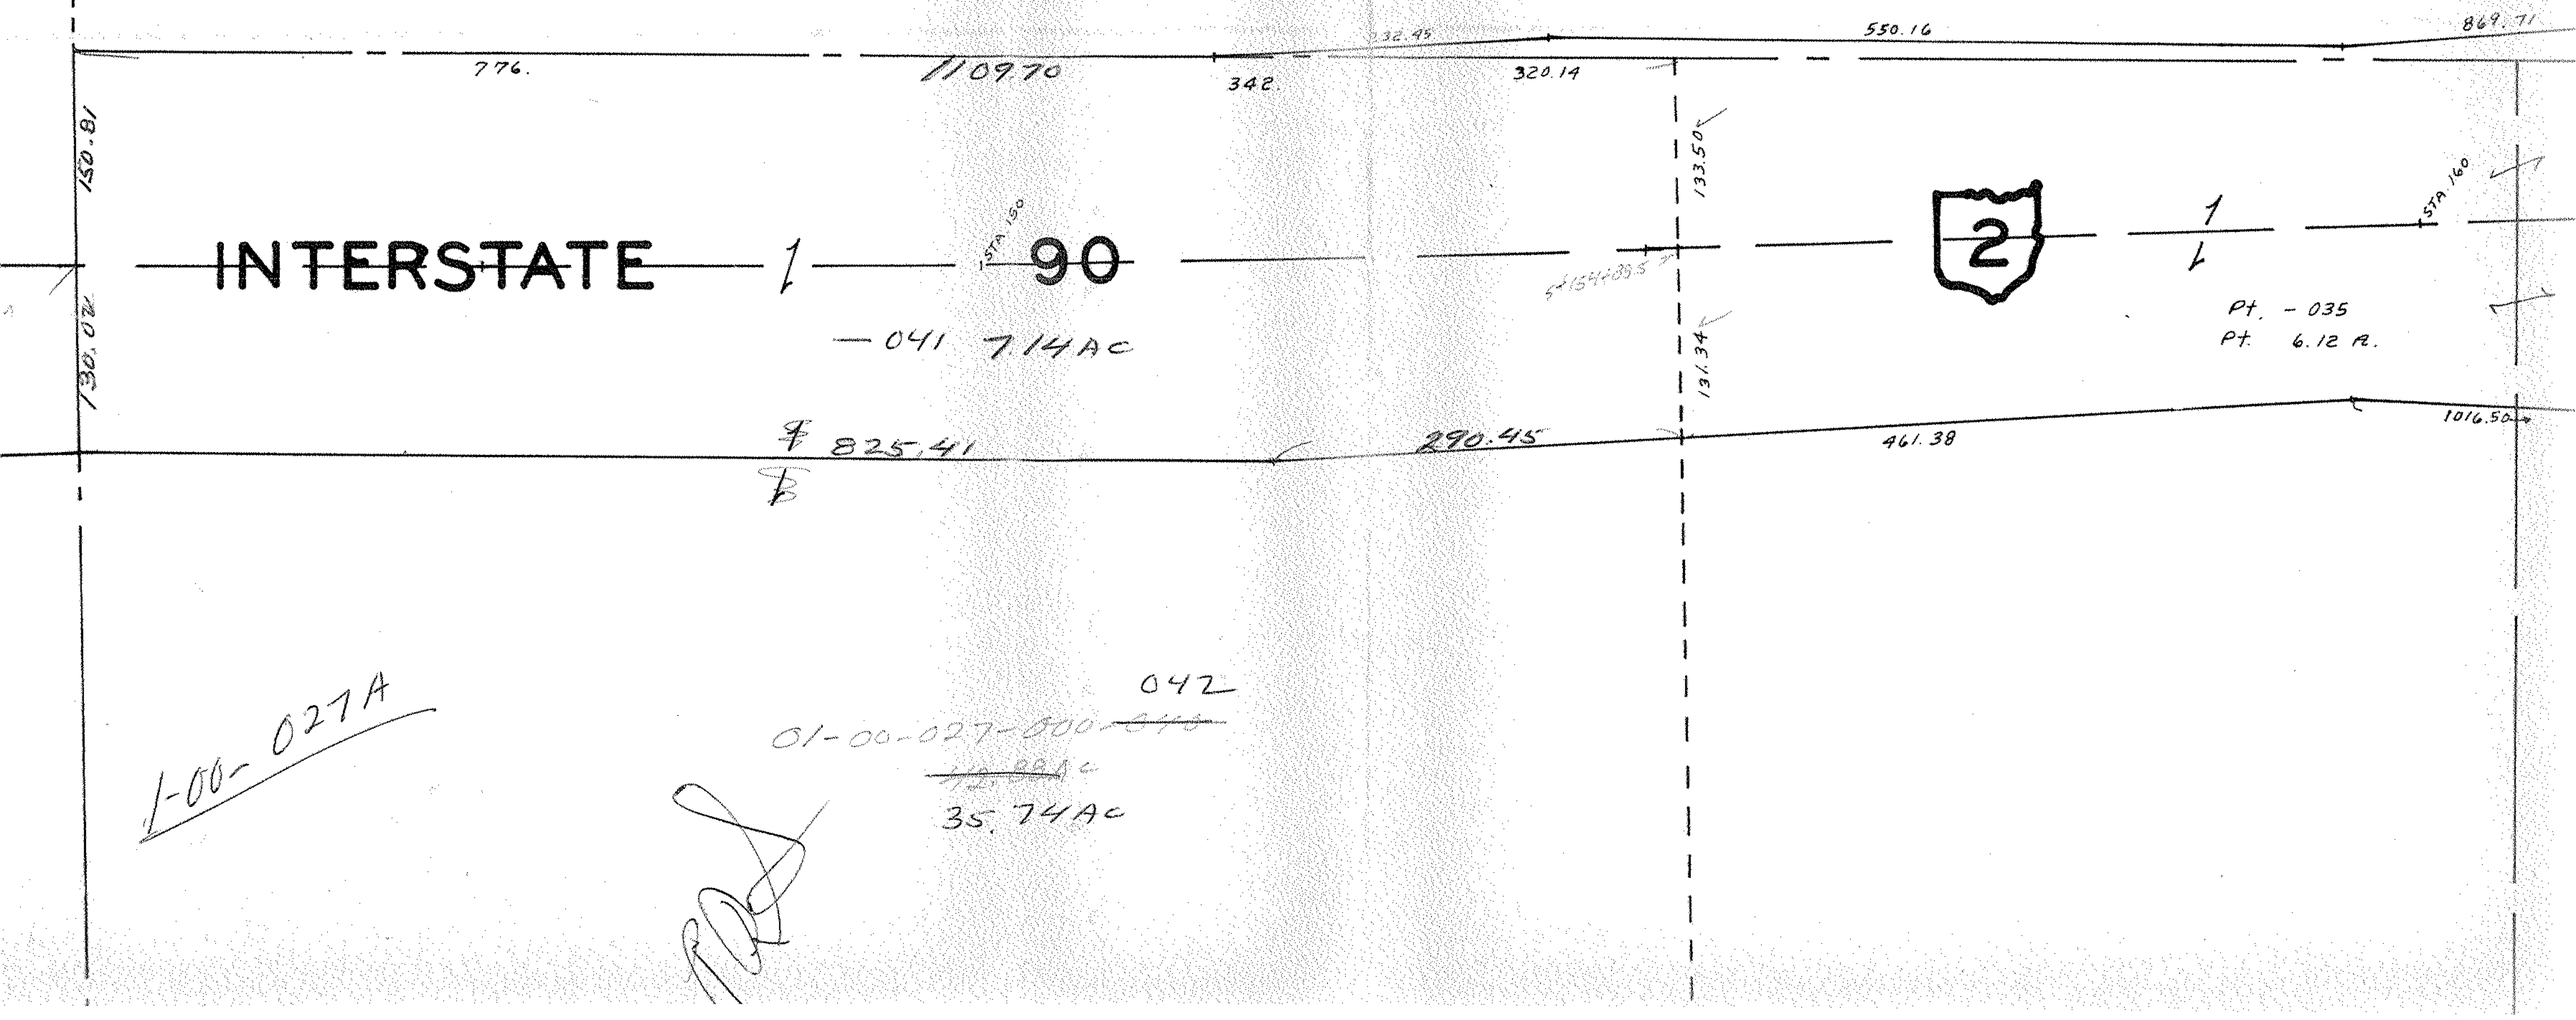
SEE 1-00-022-A