


7363

7363

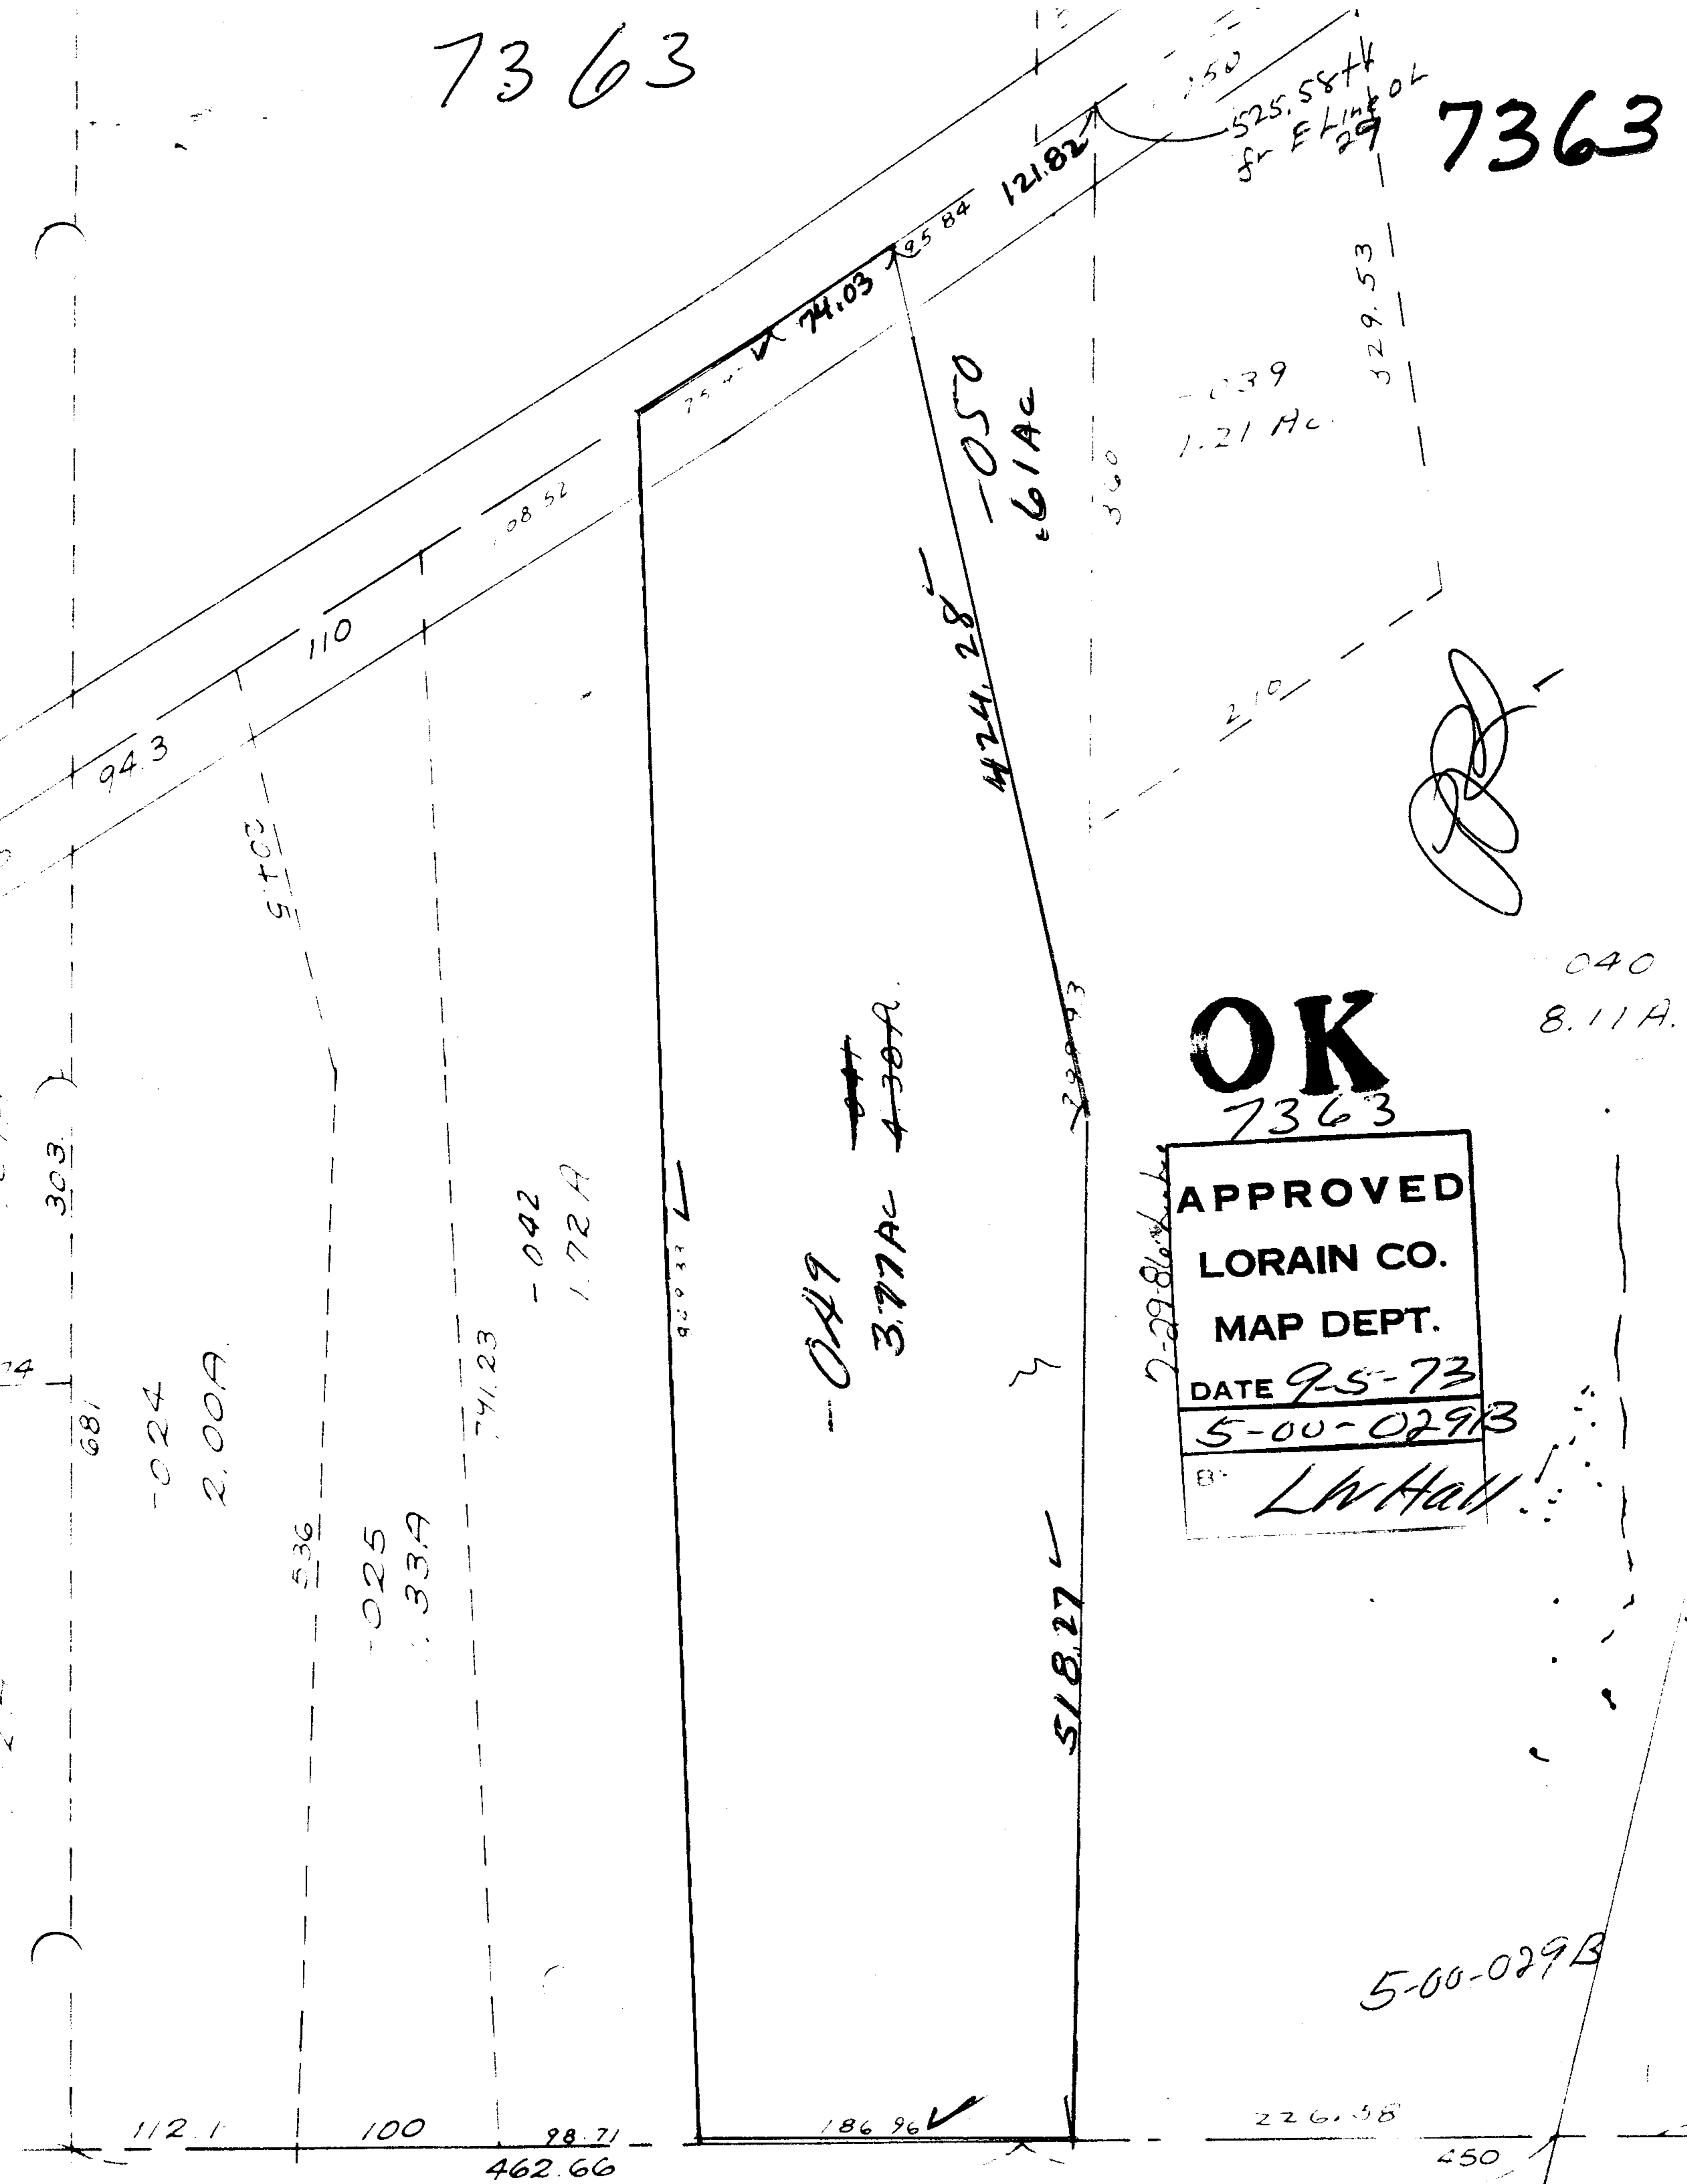

OK
7363

APPROVED
 LORAIN CO.
 MAP DEPT.
 DATE 9-5-73
 5-00-029B
 L. W. Hall

040
8.11A.

5-00-029B