


26

7369

4-026-F

CT.

RD.

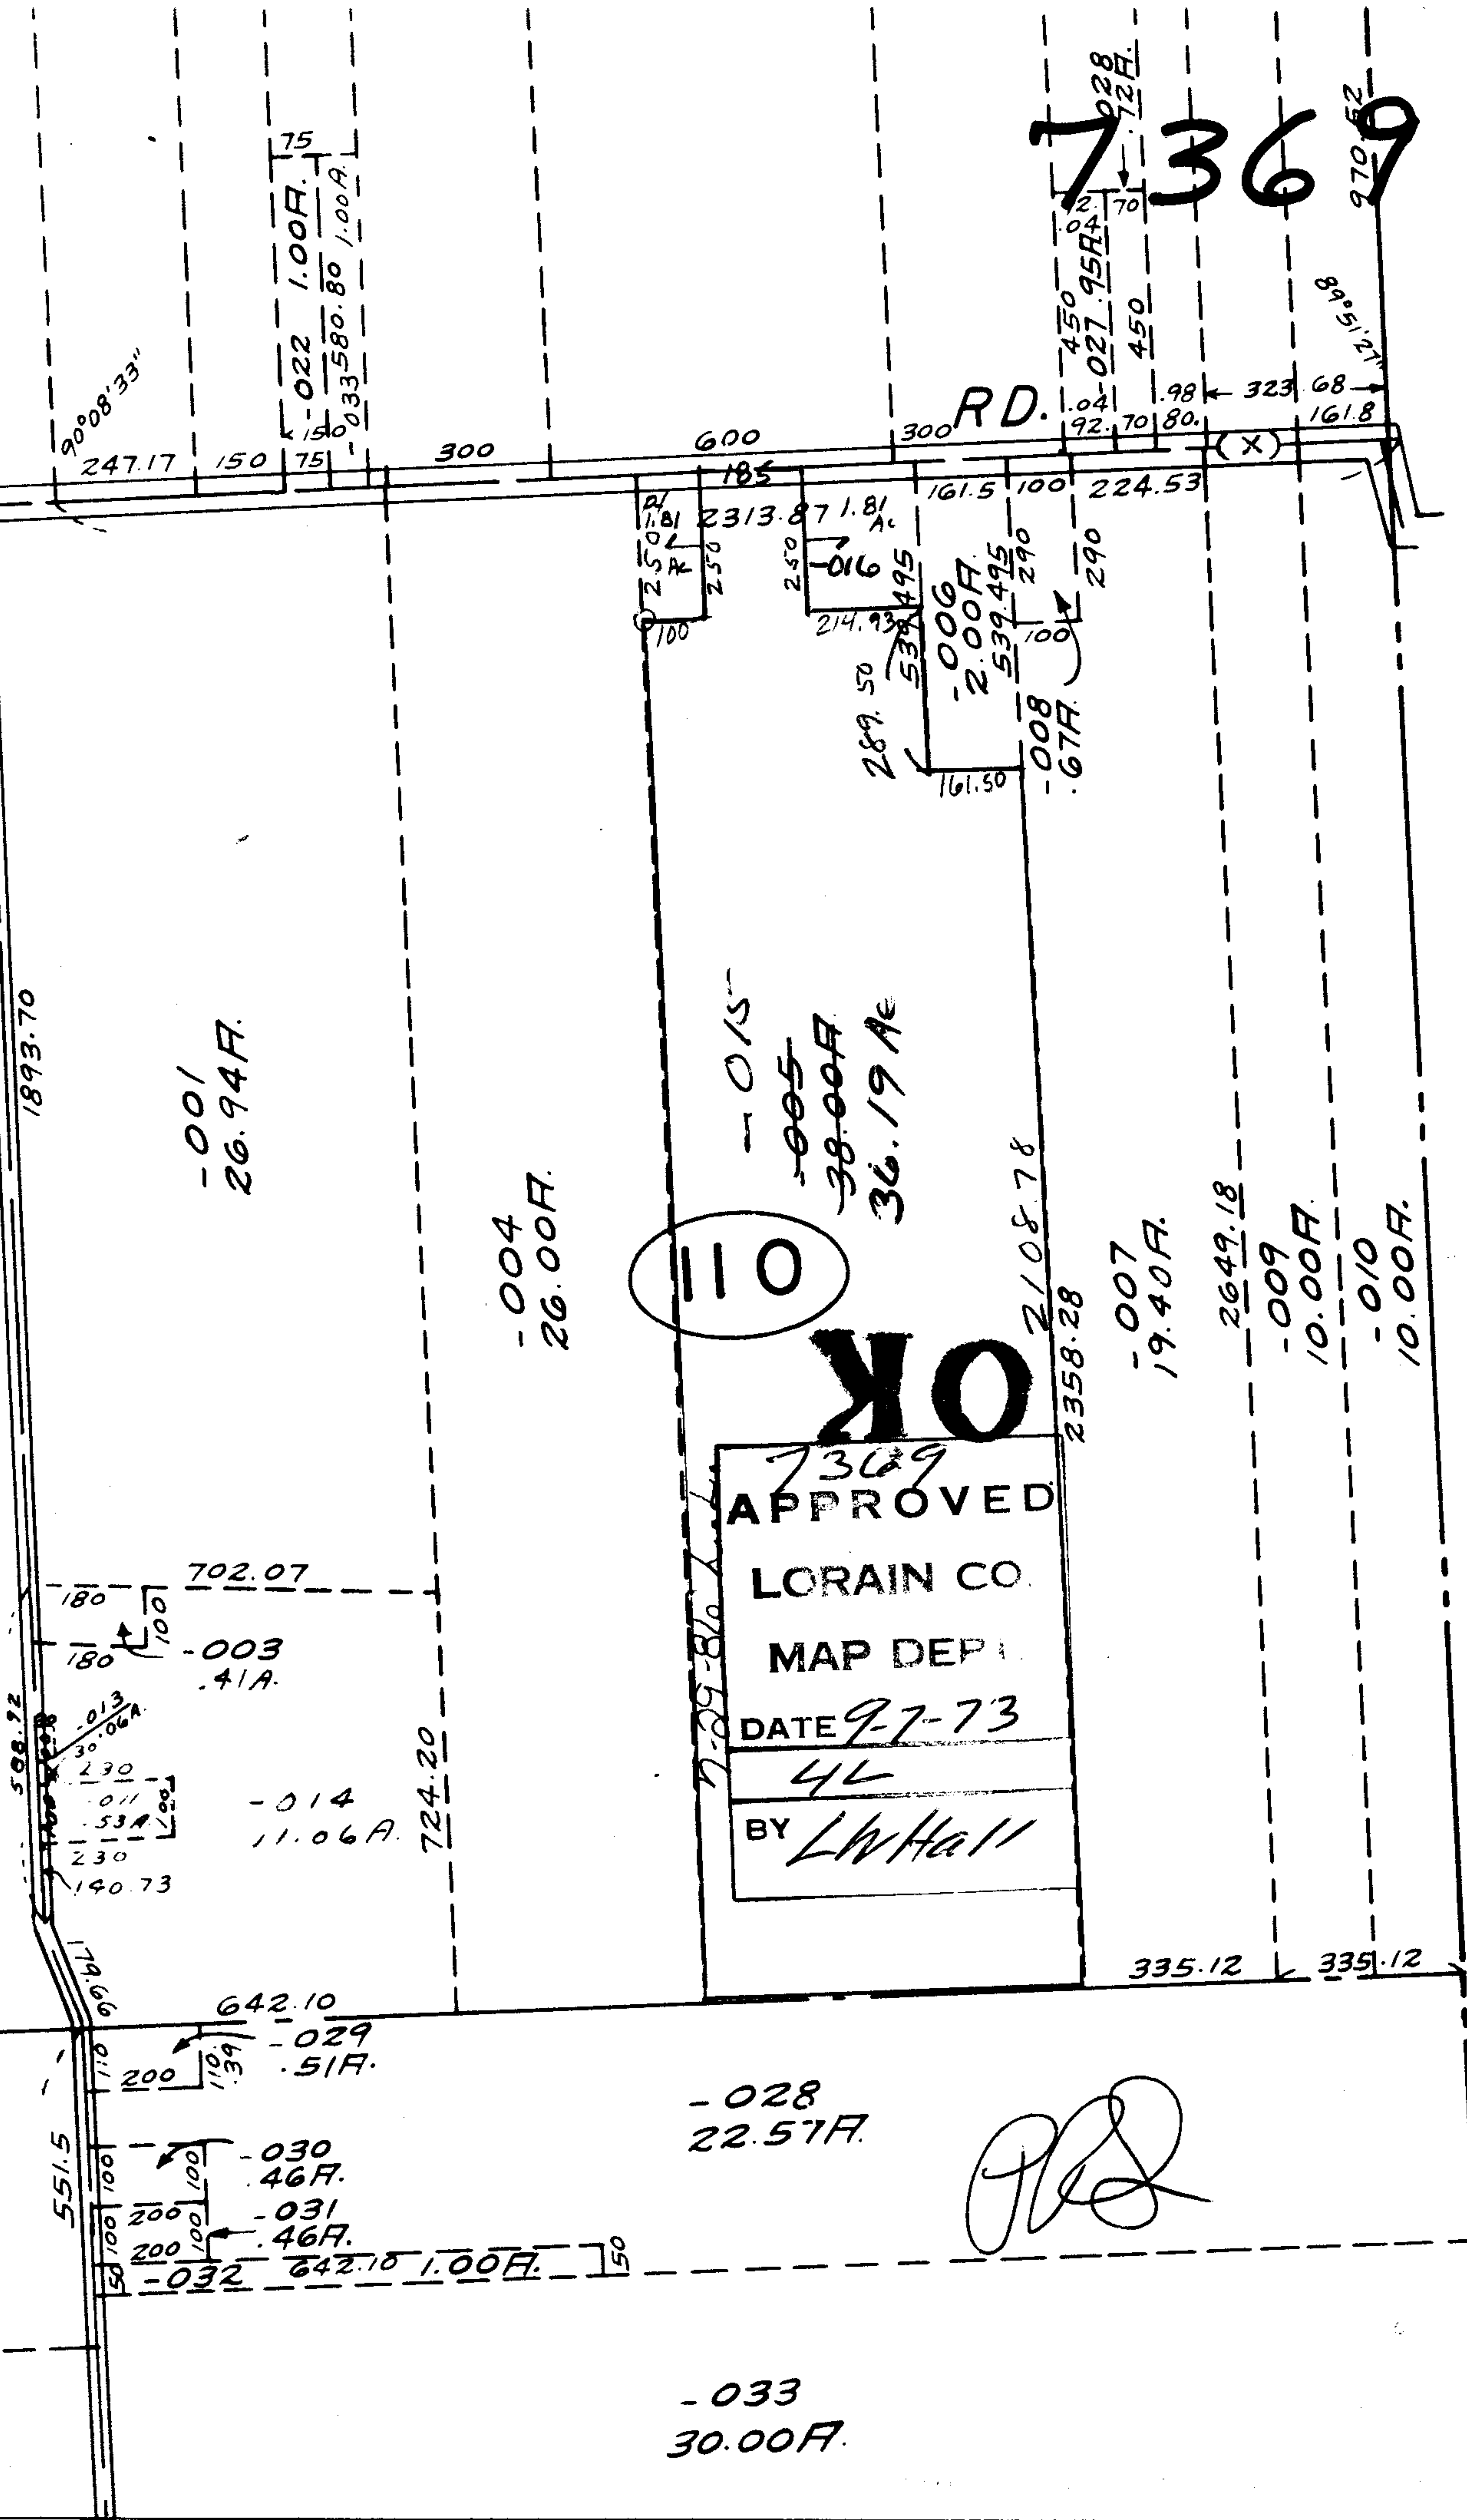

7369  
 APPROVED  
 LORAIN CO.  
 MAP DEPT.  
 DATE 9-7-73  
 44  
 BY L.W. Hall

*[Handwritten Signature]*

4-013  
 26.19A.