


7377

(45-60)

76

RD. (60)

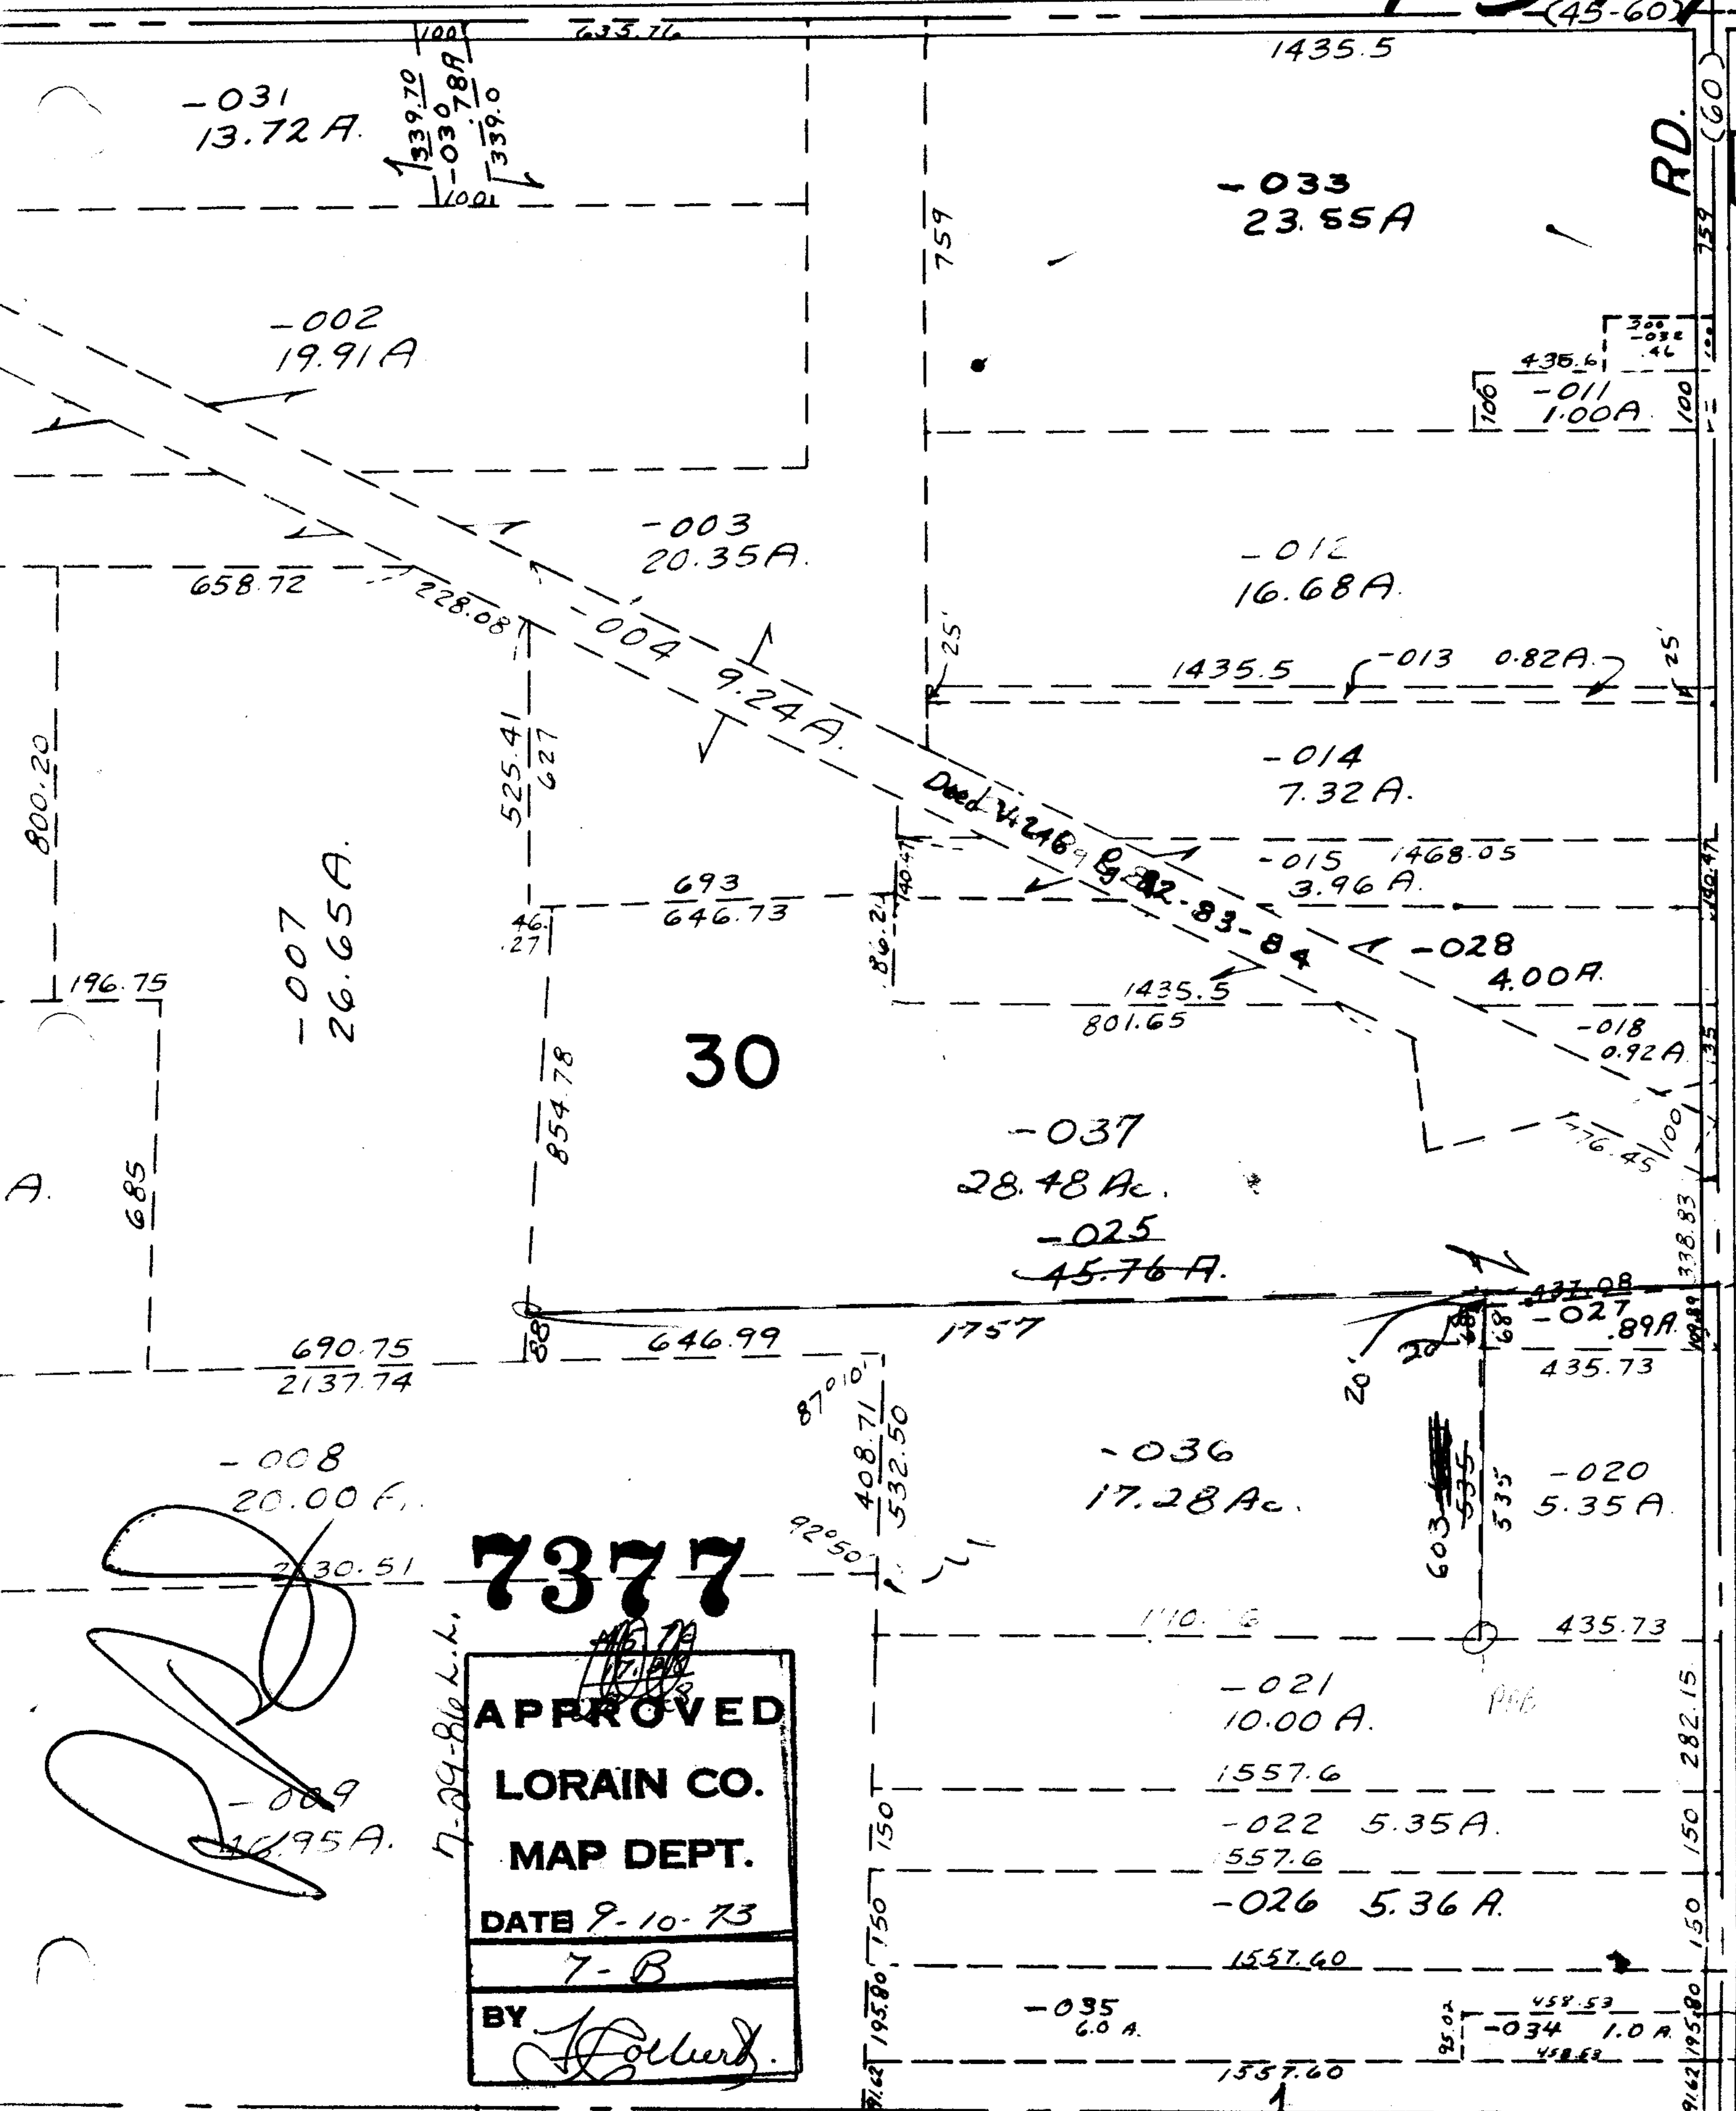

7377

APPROVED
 LORAIN CO.
 MAP DEPT.
 DATE 9-10-73
 7-B
 BY *J. L. L...*

[Large signature]

7-24-816 L.L.

535
 580
 623

-001

50

-037

4.26