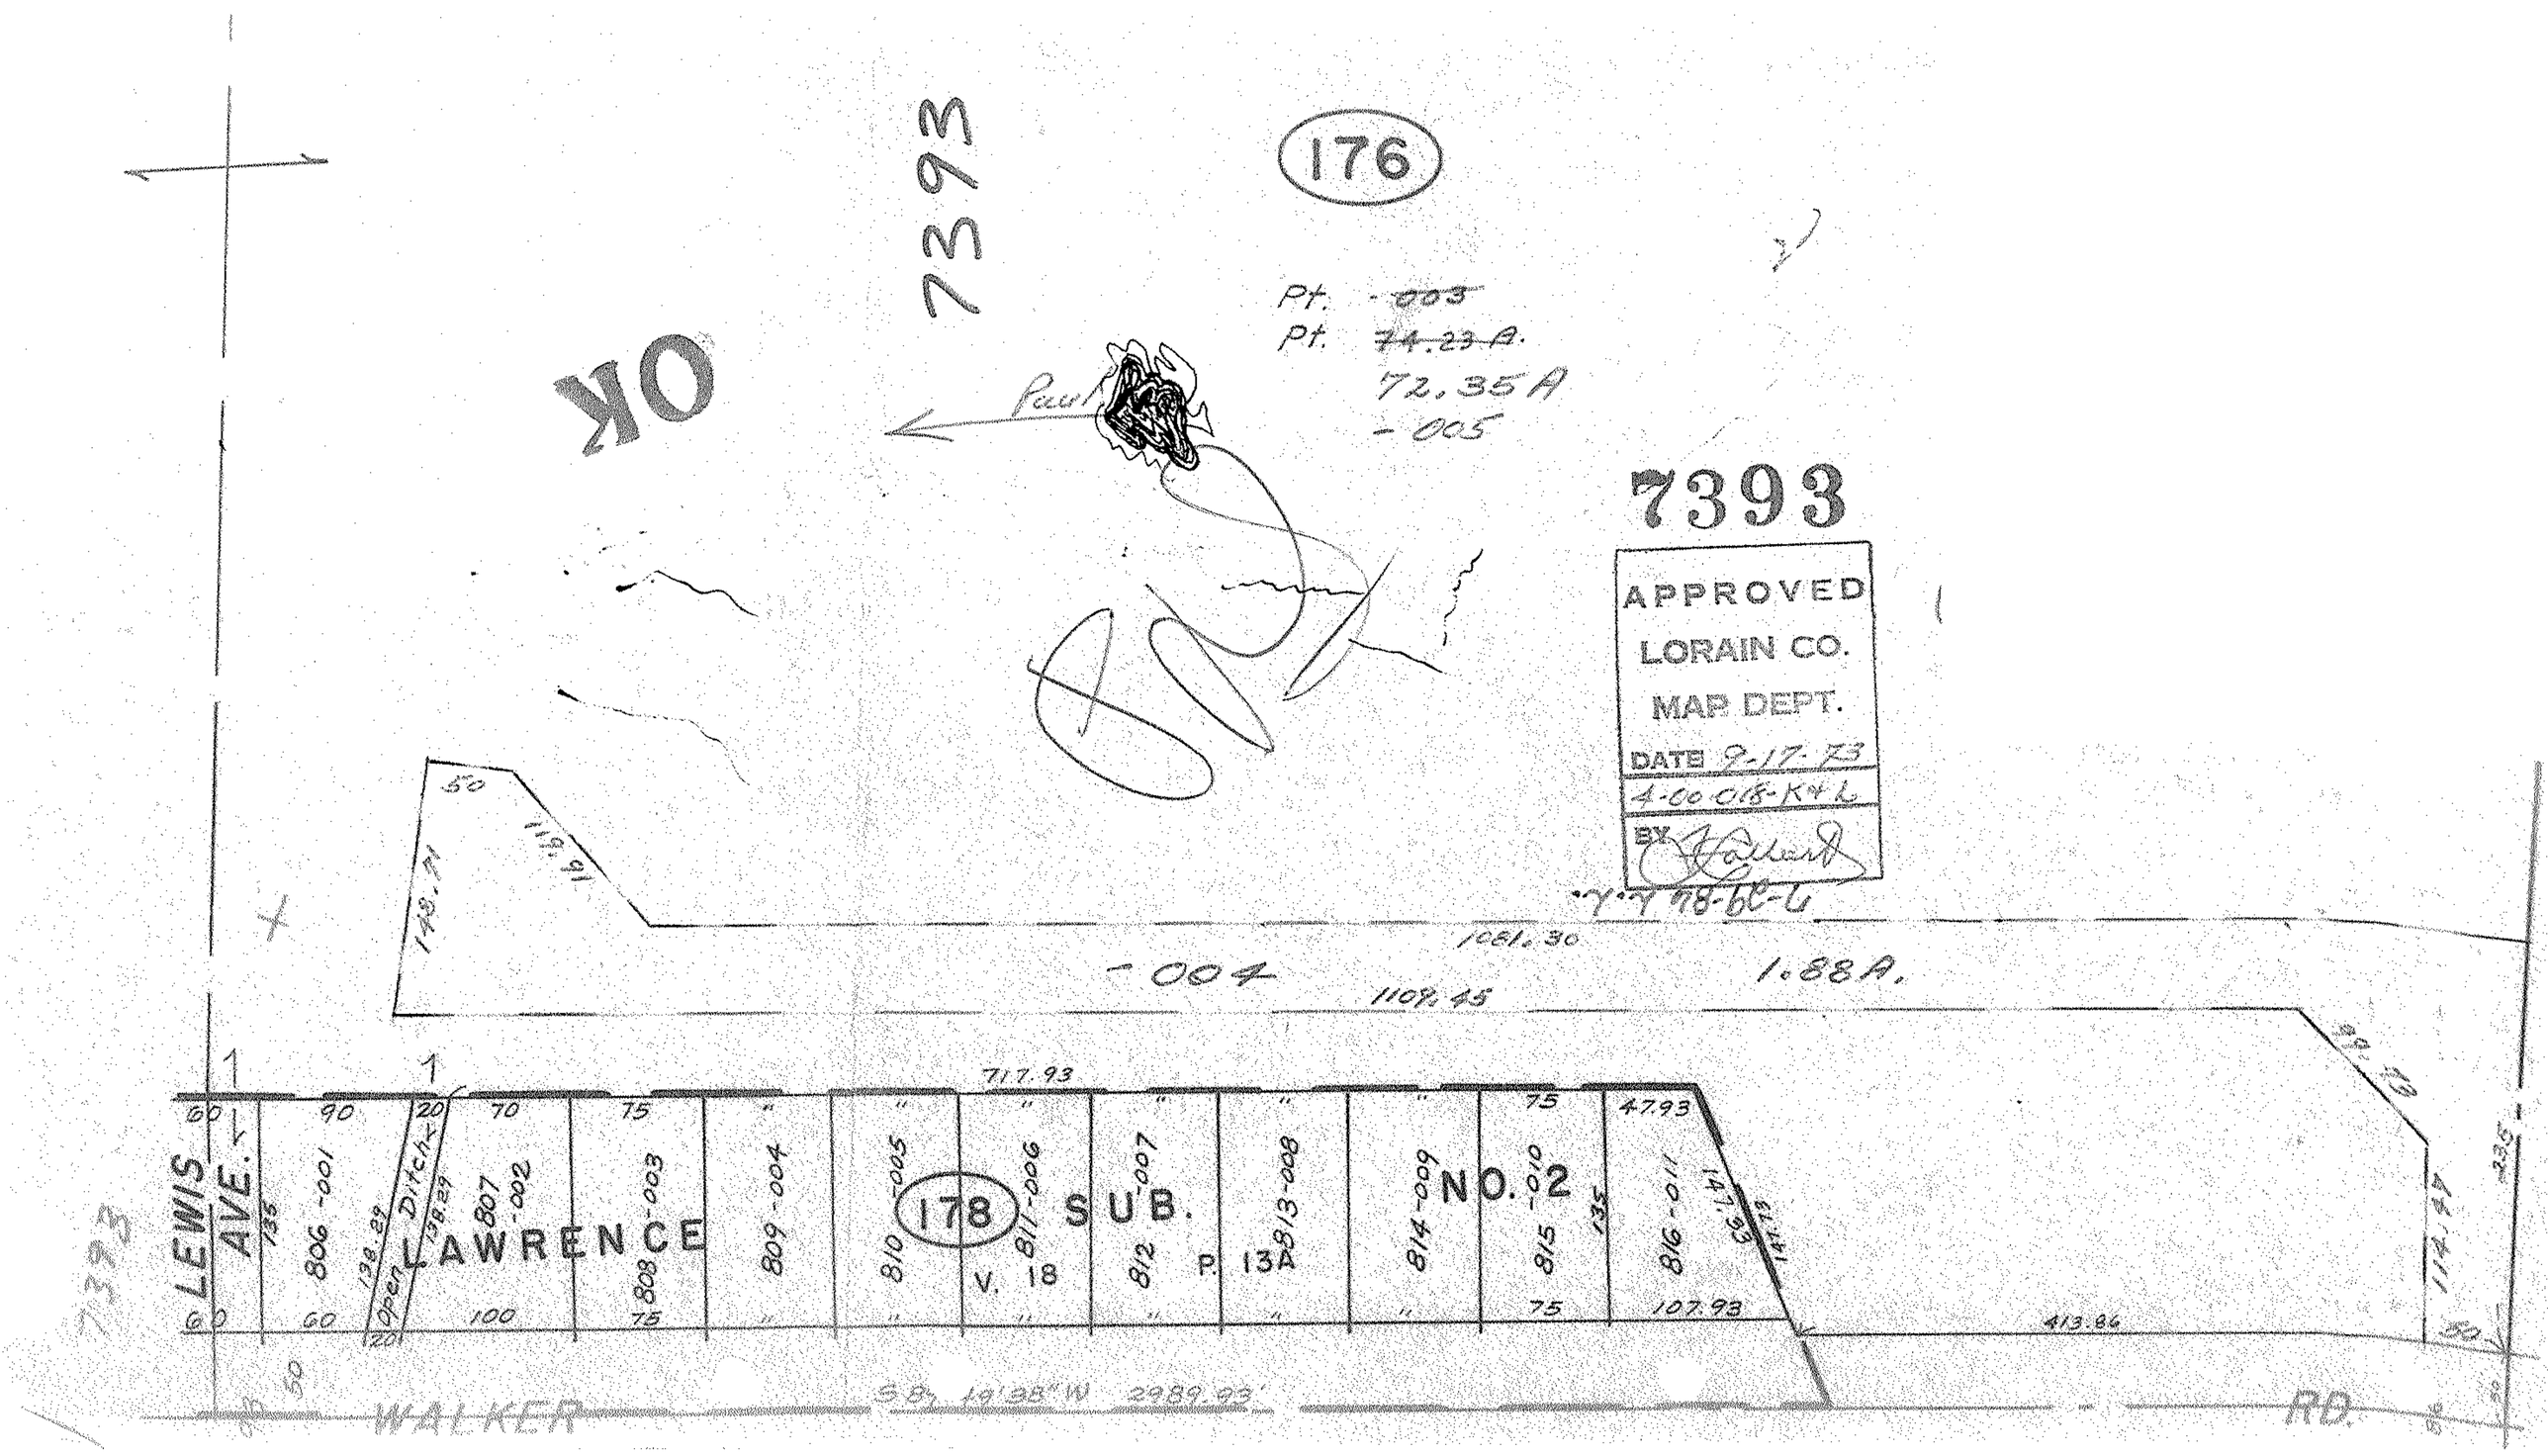

176
7393
OK
Pt. -003
Pt. ~~74.23 A.~~
72.35 A
-005
Paul
7393
APPROVED
LORAIN CO.
MAP DEPT.
DATE 9-17-73
4-00-018-K+L
BY
-004
1.88 A.
1081.30
1109.45
717.93
47.93
LEWIS AVE.
LAWRENCE
178 SUB. NO. 2
V. 18 P. 13A
806-001
807-002
808-003
809-004
810-005
811-006
812-007
813-008
814-009
815-010
816-011
Open Ditch
107.93
413.86
114.47
WALKER RD.
S 8° 19'38" W 2989.93'