


7395

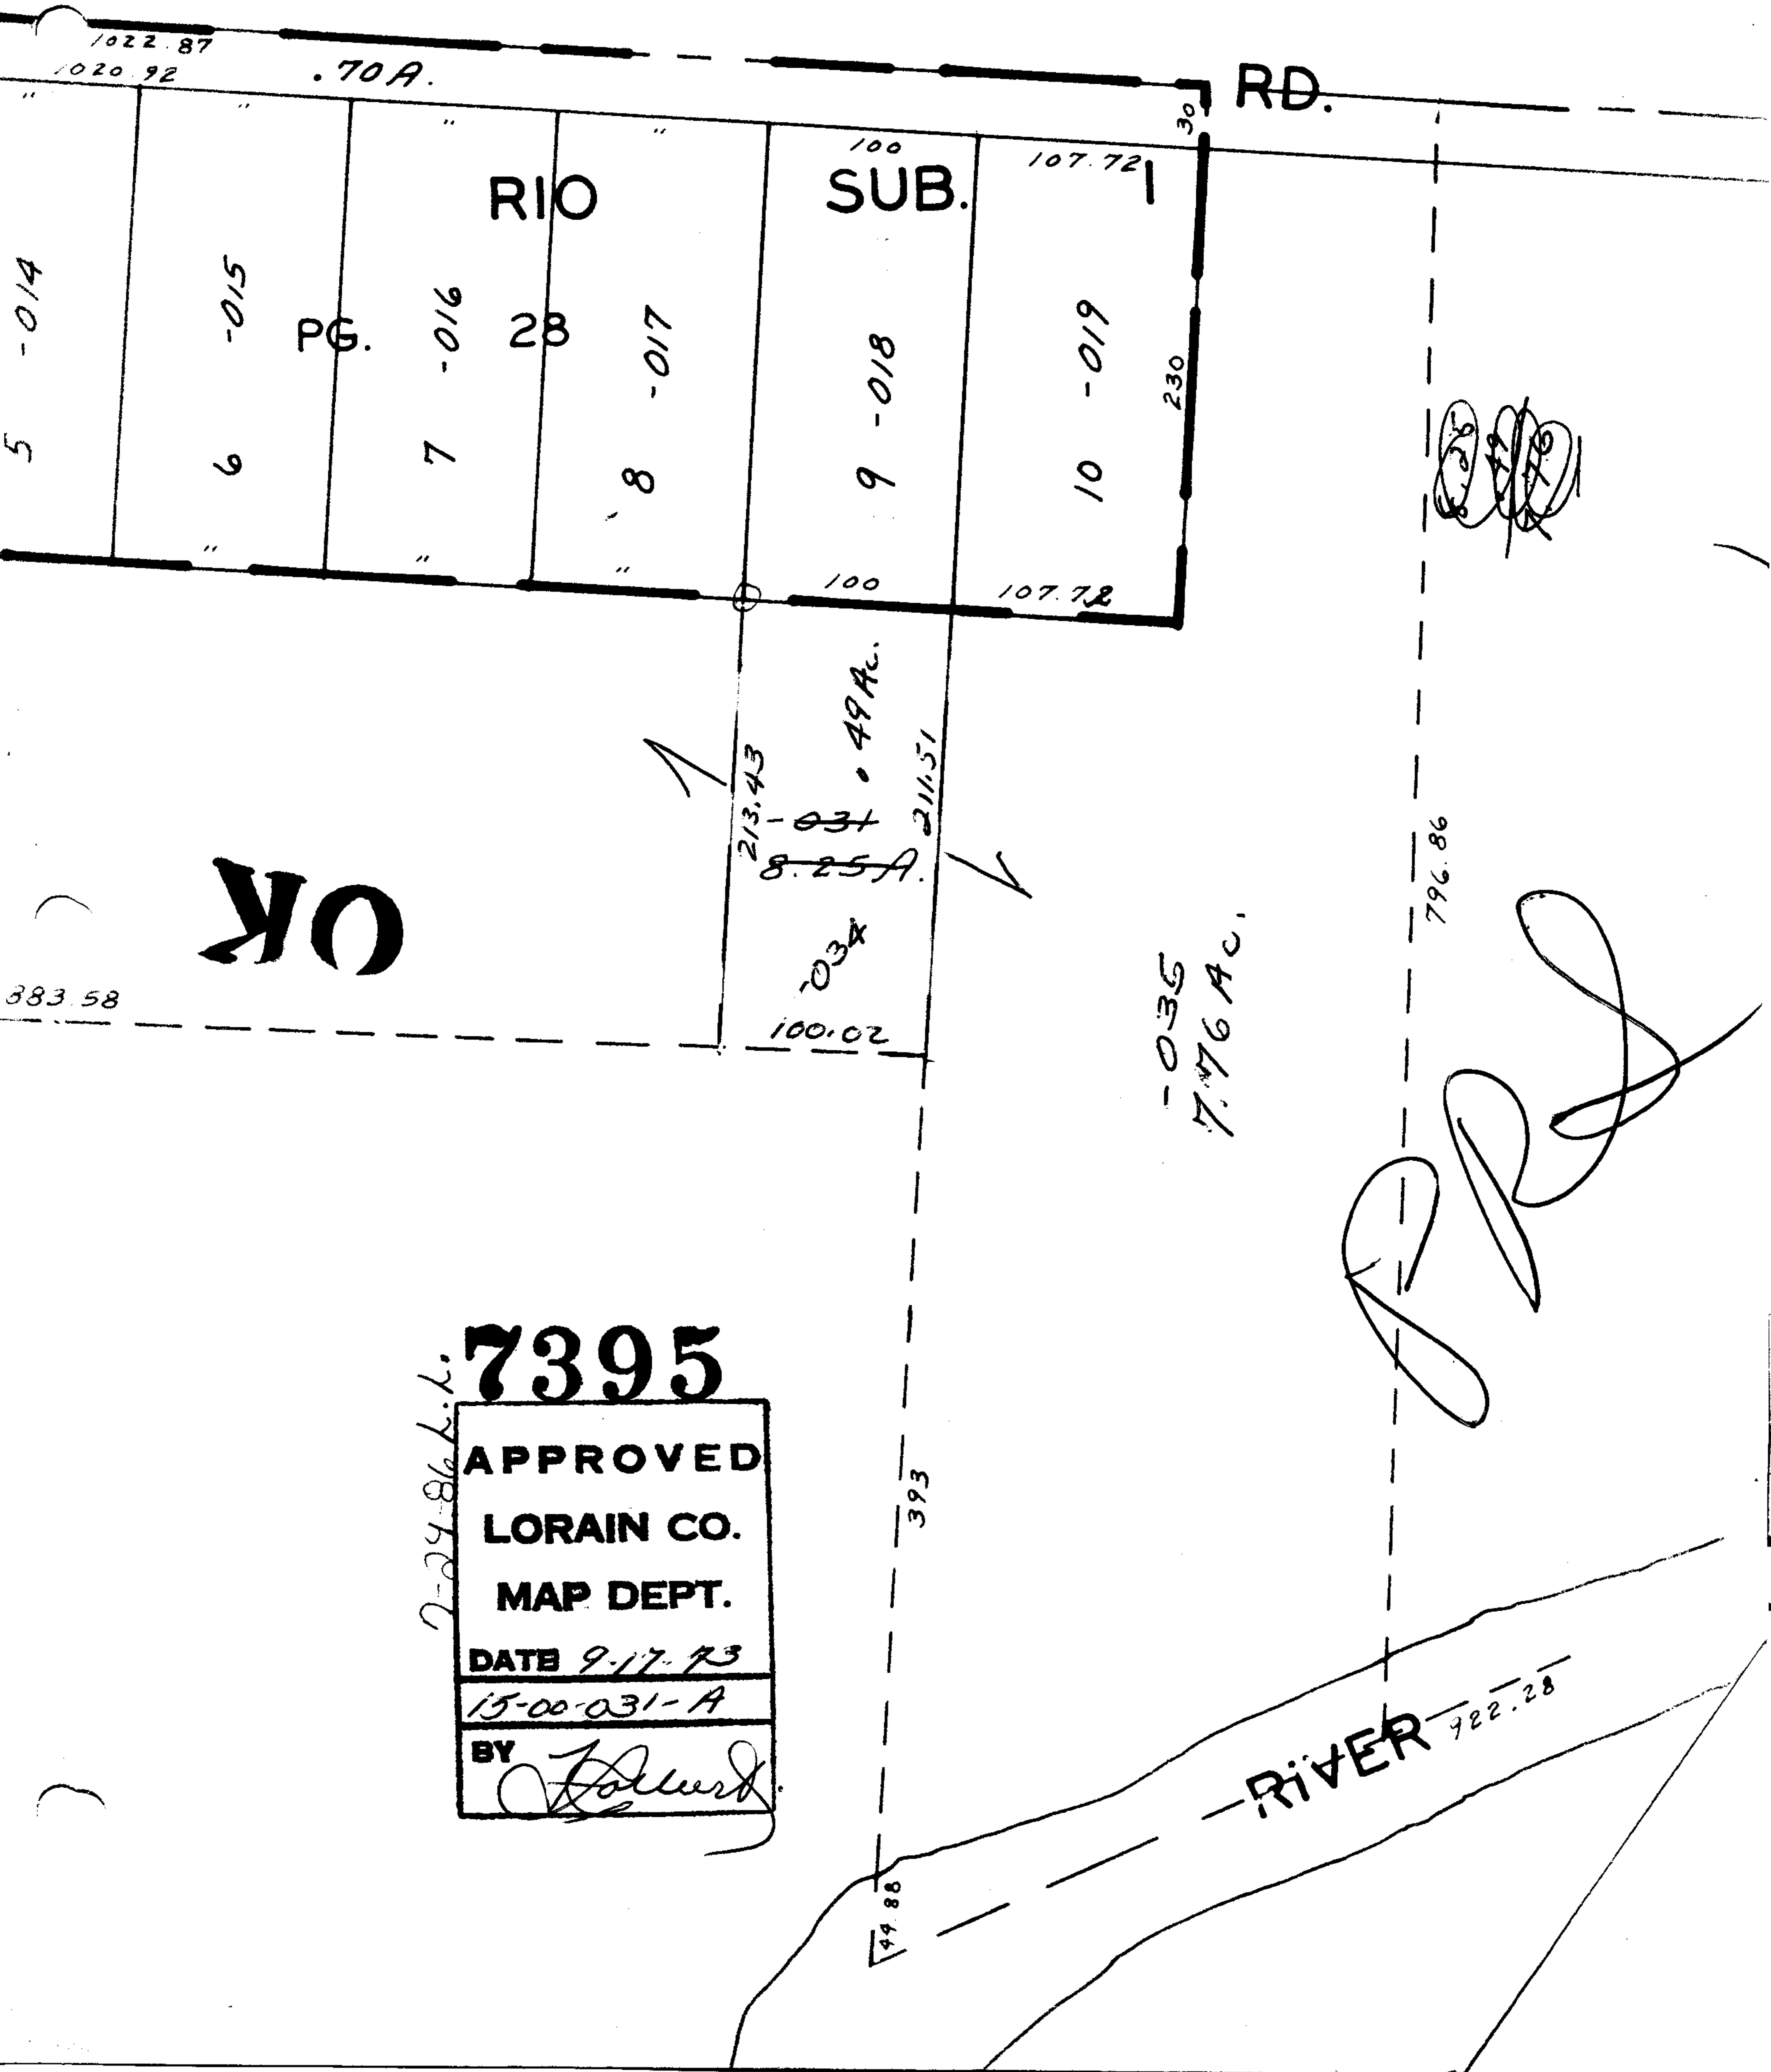

2-24-86 L.L.  
**7395**  
 APPROVED  
 LORAIN CO.  
 MAP DEPT.  
 DATE 9-17-73  
 15-00-031-A  
 BY *Follert*