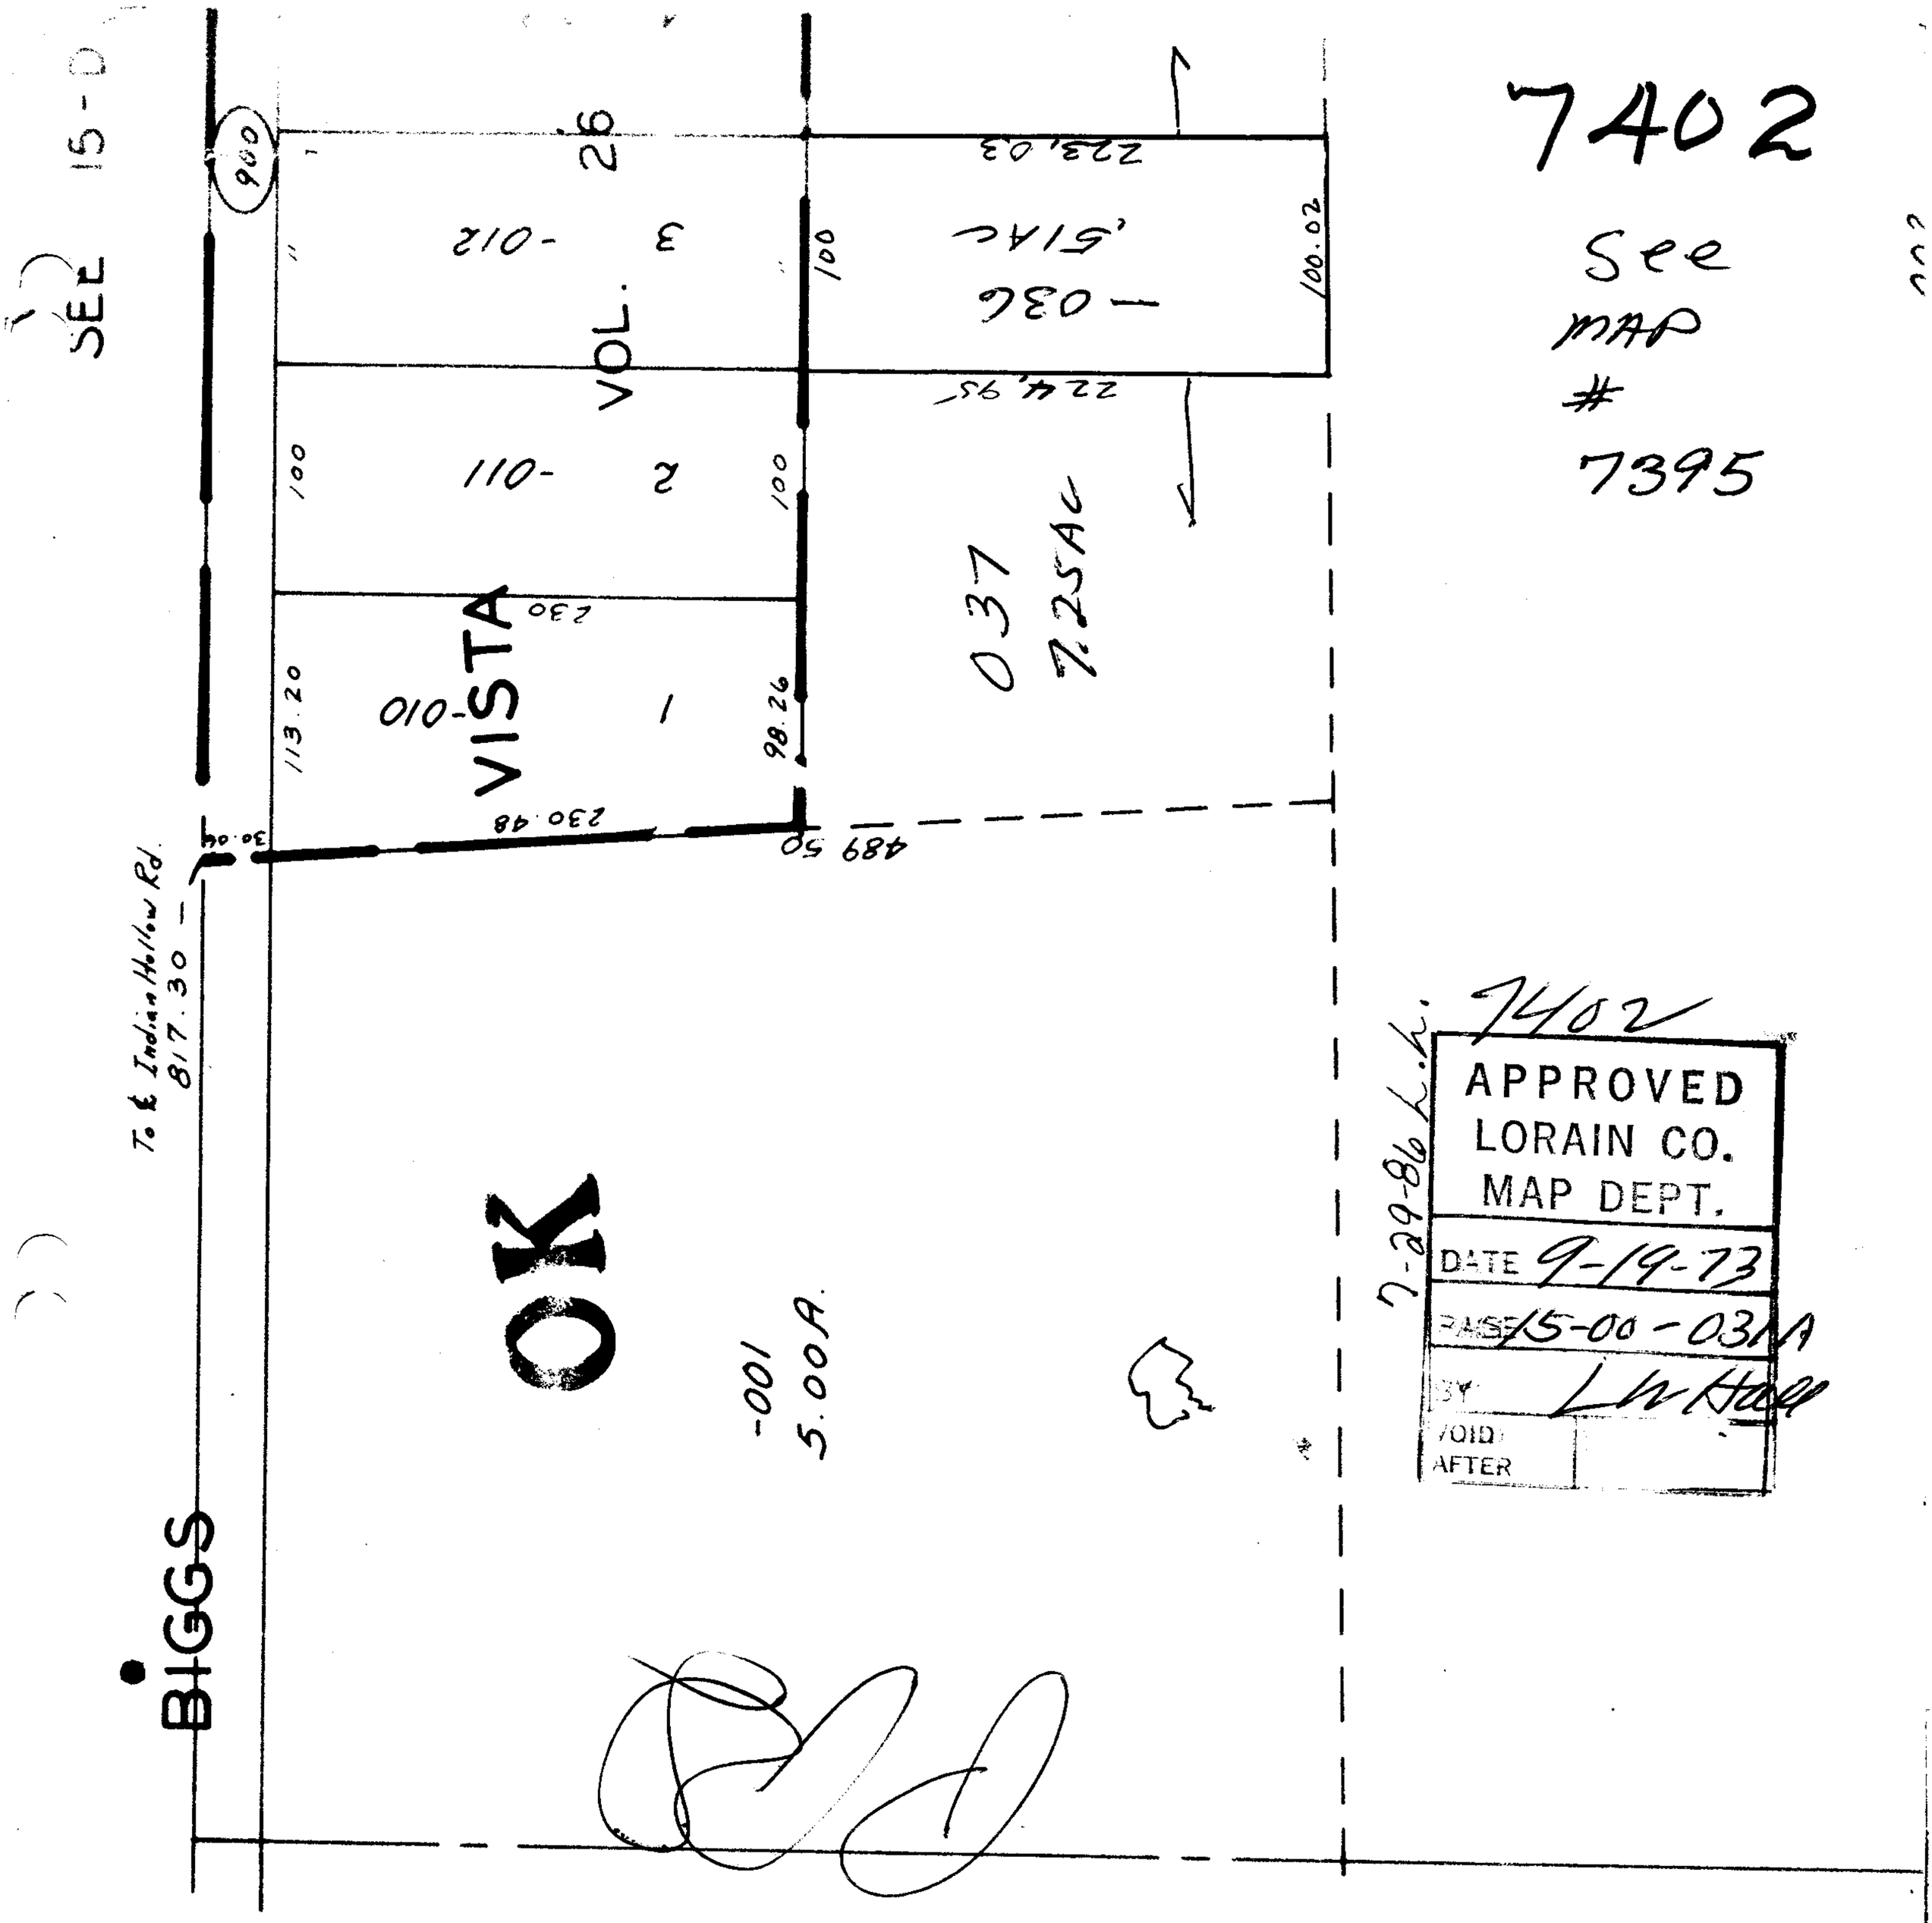

7402

See MAP # 7395

7402

APPROVED
LORAIN CO.
MAP DEPT.

DATE 9-19-73

PAGE 15-00-031A

BY LW Hall

VOID AFTER

7-29-86 L.L.