


170.98
 94.82
 26580
 70
 3580

00-005-C

POD

degar's - A Turn O
 Tran's Sheets
 15

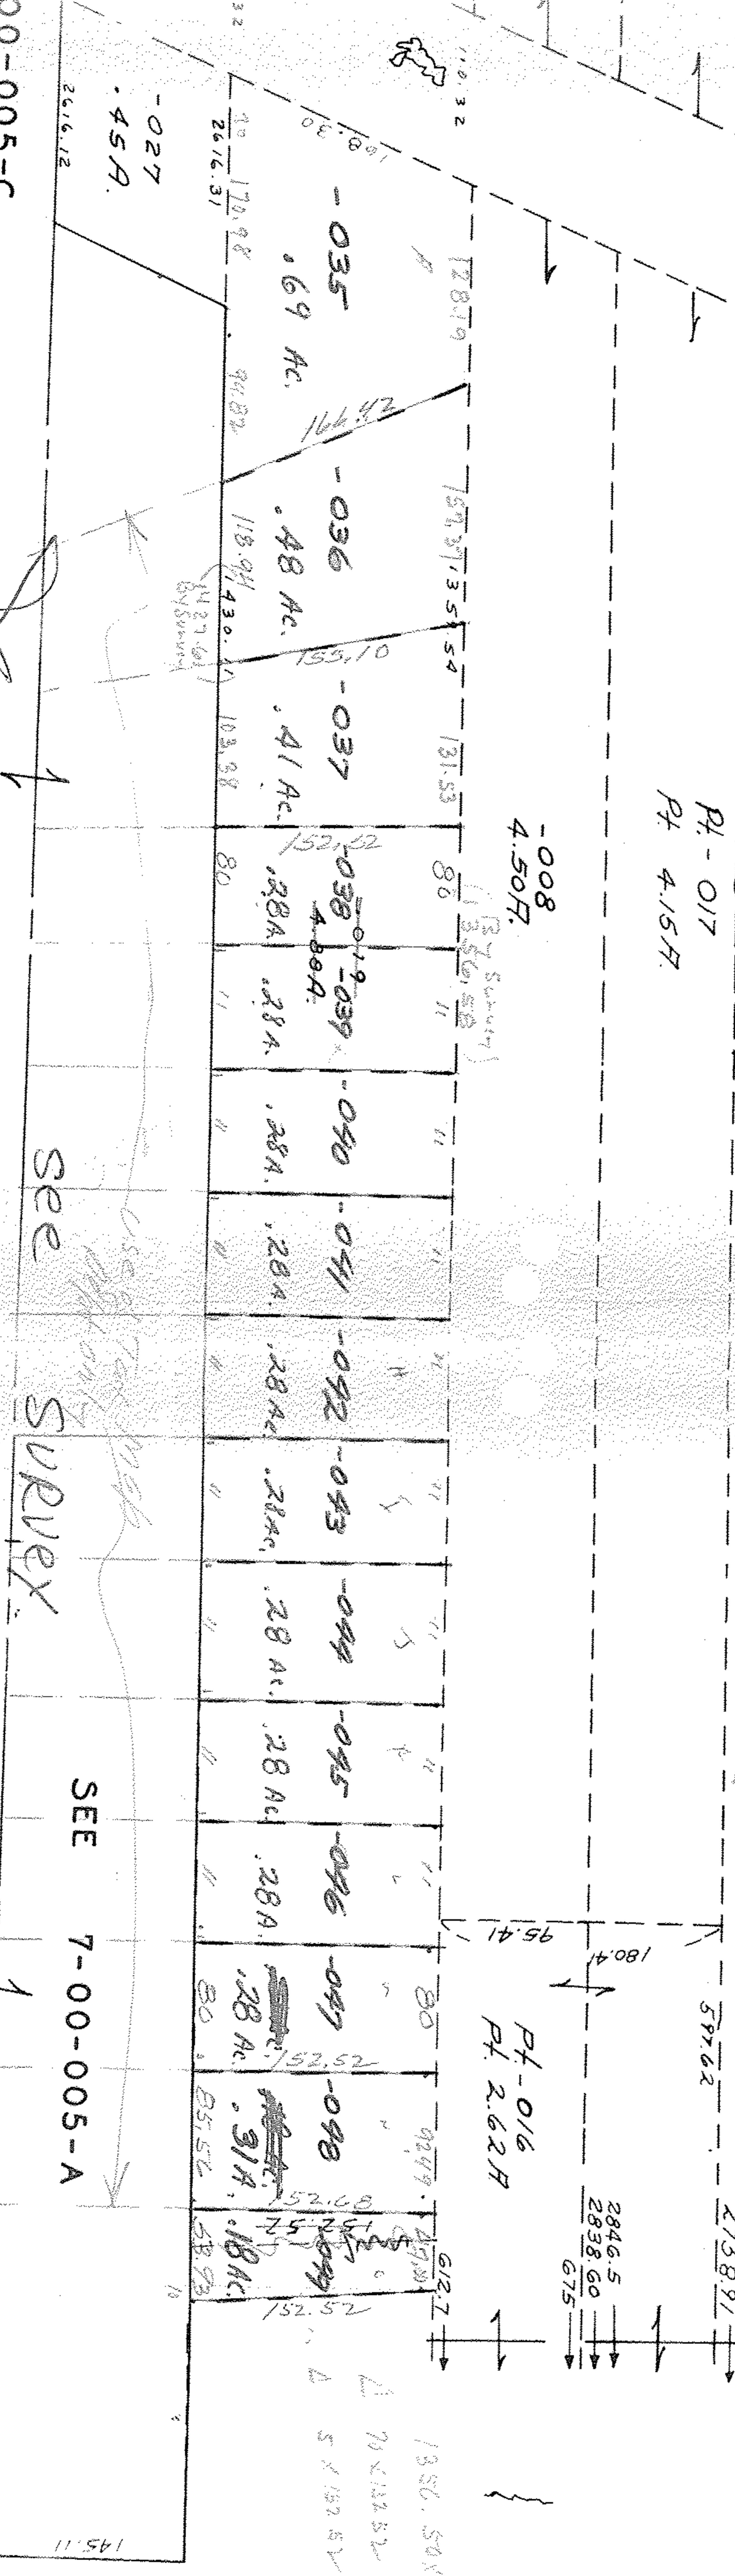

OK
 SEE SURVEY

115

APPROVED
LORAIN CO.
MAP DEPT.
DATE
PAGE
BY
VOID AFTER

Pt - 017
 Pt 4.15A

APPROVED
LORAIN CO.
MAP DEPT.
DATE
PAGE
BY
VOID AFTER

APPROVED
LORAIN CO.
MAP DEPT.
DATE
PAGE
BY
VOID AFTER



7406

APPROVED
LORAIN CO.
MAP DEPT.
DATE 9-26-73
7-00-008-D
BY P. Small
7-29-86 L.H.

RD. 20
 MCKINLEY AV
 7406

7406