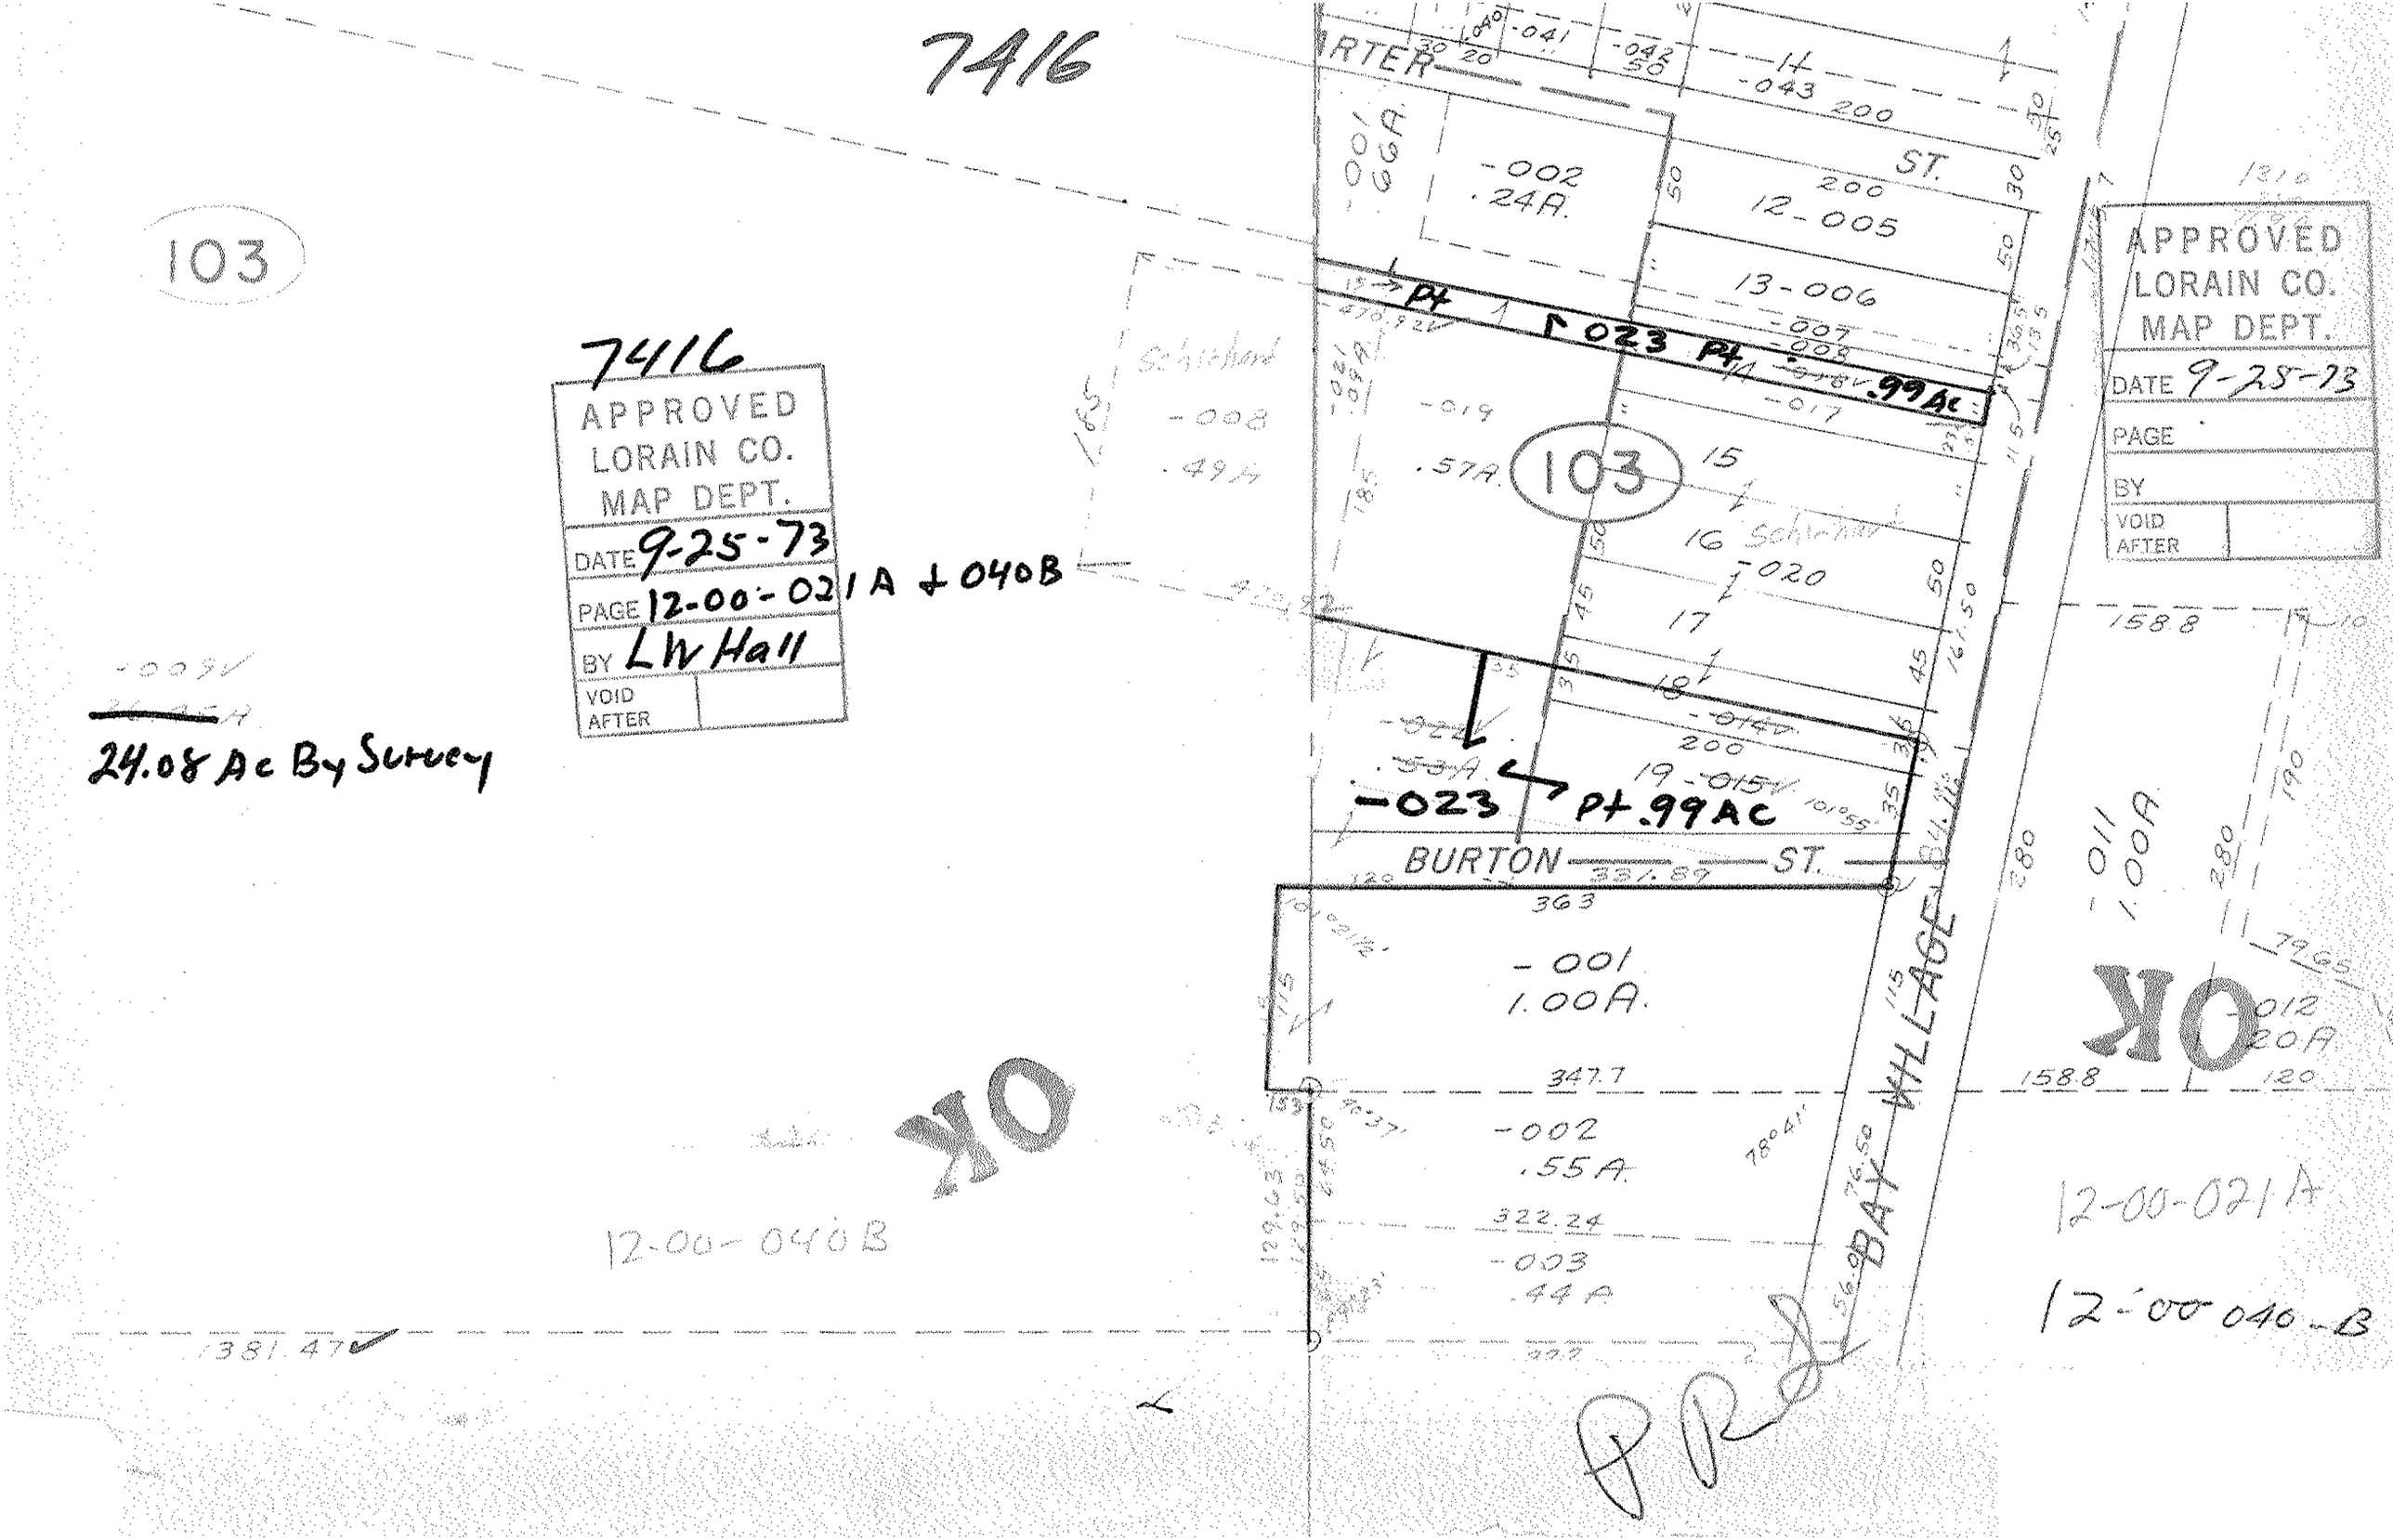
7416
103
7416
APPROVED
LORAIN CO.
MAP DEPT.
DATE 9-25-73
PAGE 12-00-021A + 040B
BY LW Hall
VOID AFTER
24.08 Ac By Survey
ARTER ST.
-002
.24A.
12-005
13-006
Pt
023 Pt .99Ac
Schirhart
-008
.49A
-019
.57A.
103
15
16
Schirhart
-020
17
18
-014
200
19-015
-023 Pt .99AC
BURTON ST.
363
-001
1.00A.
347.7
-002
.55A.
322.24
-003
.44A
BAY VILLAGE
APPROVED
LORAIN CO.
MAP DEPT.
DATE 9-25-73
PAGE
BY
VOID AFTER
158.8
-011
1.00A
-012
.20A
OK
OK
12-00-040B
12-00-021A
12-00-040-B
1381.47