


7419

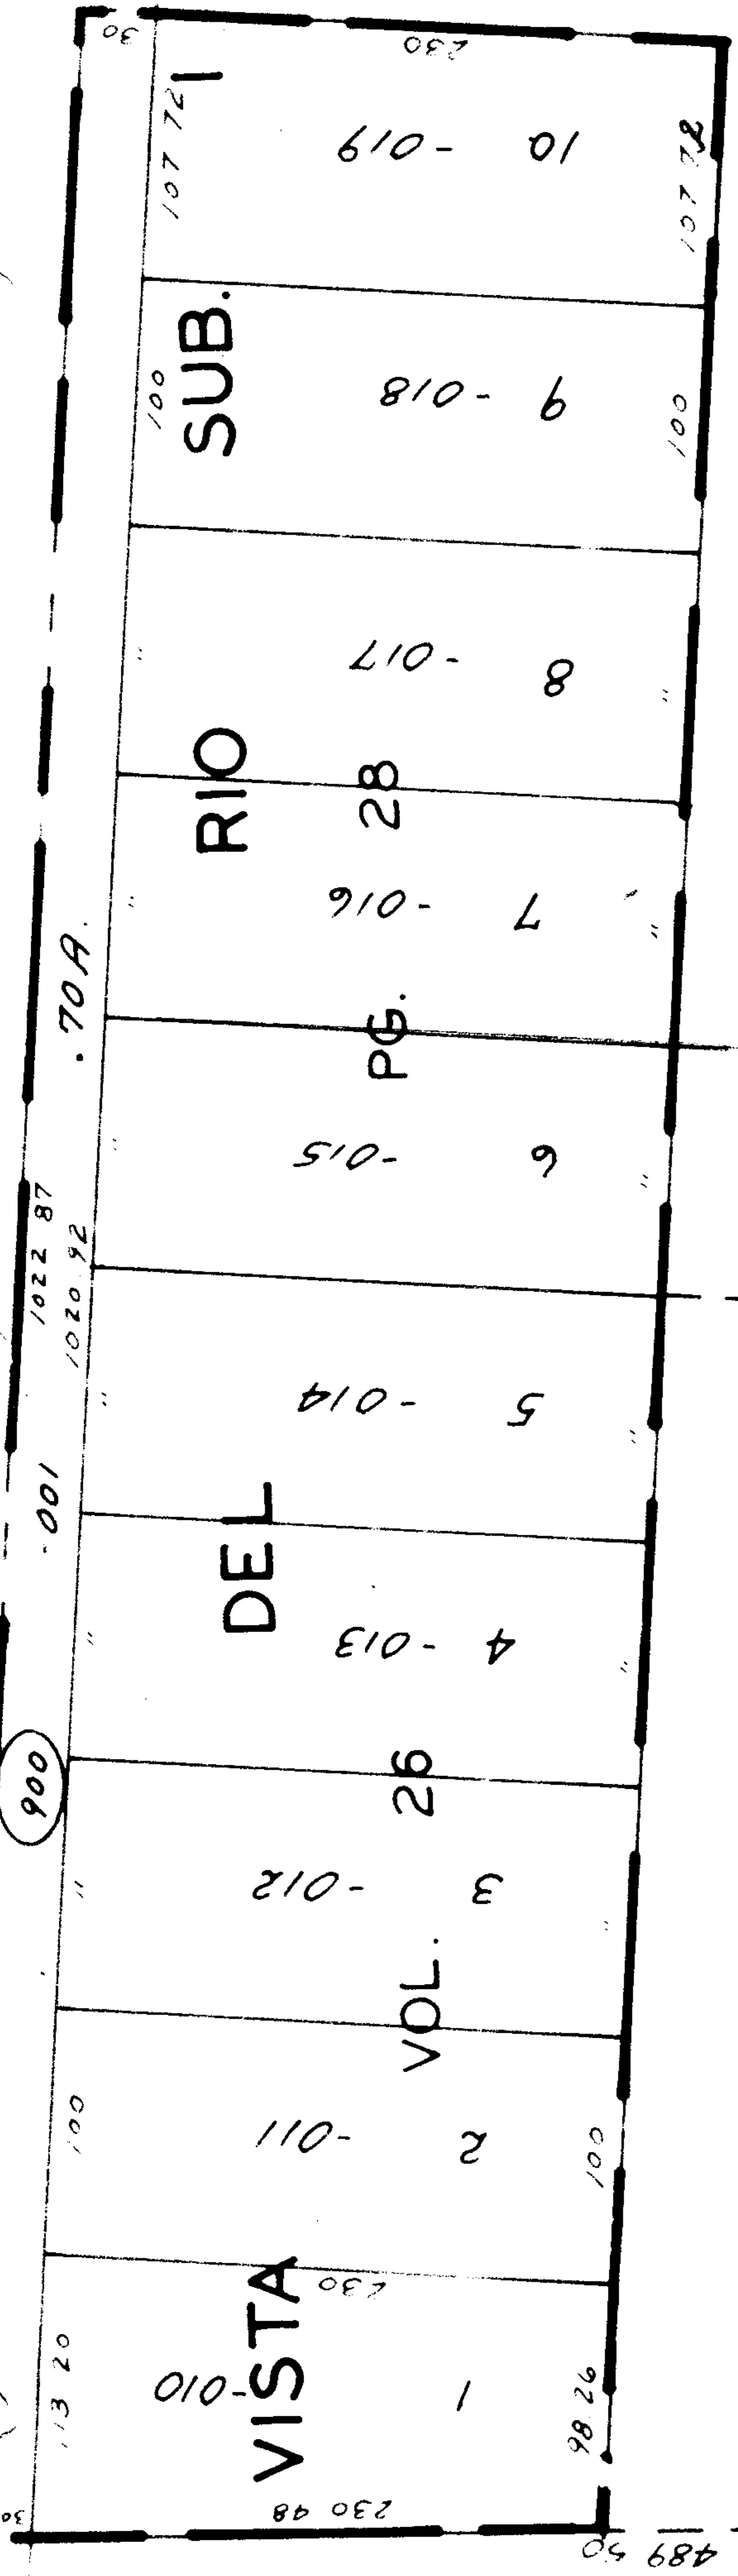

~~7-257~~
~~7-037~~
~~8-257A~~
~~7-257Ac~~

OK

1

217.27
 .50 Ac.
 -038

219.19
 1

-039
 6.75 Ac.

[Handwritten signature]

7419

APPROVED
LORAIN CO.
MAR DEPT.
DATE 9-26-73
15-00-031-A
BY <i>[Signature]</i>

7-29-86
 L.H.

-002
 17604

725
 50
 675

3x5

489 50