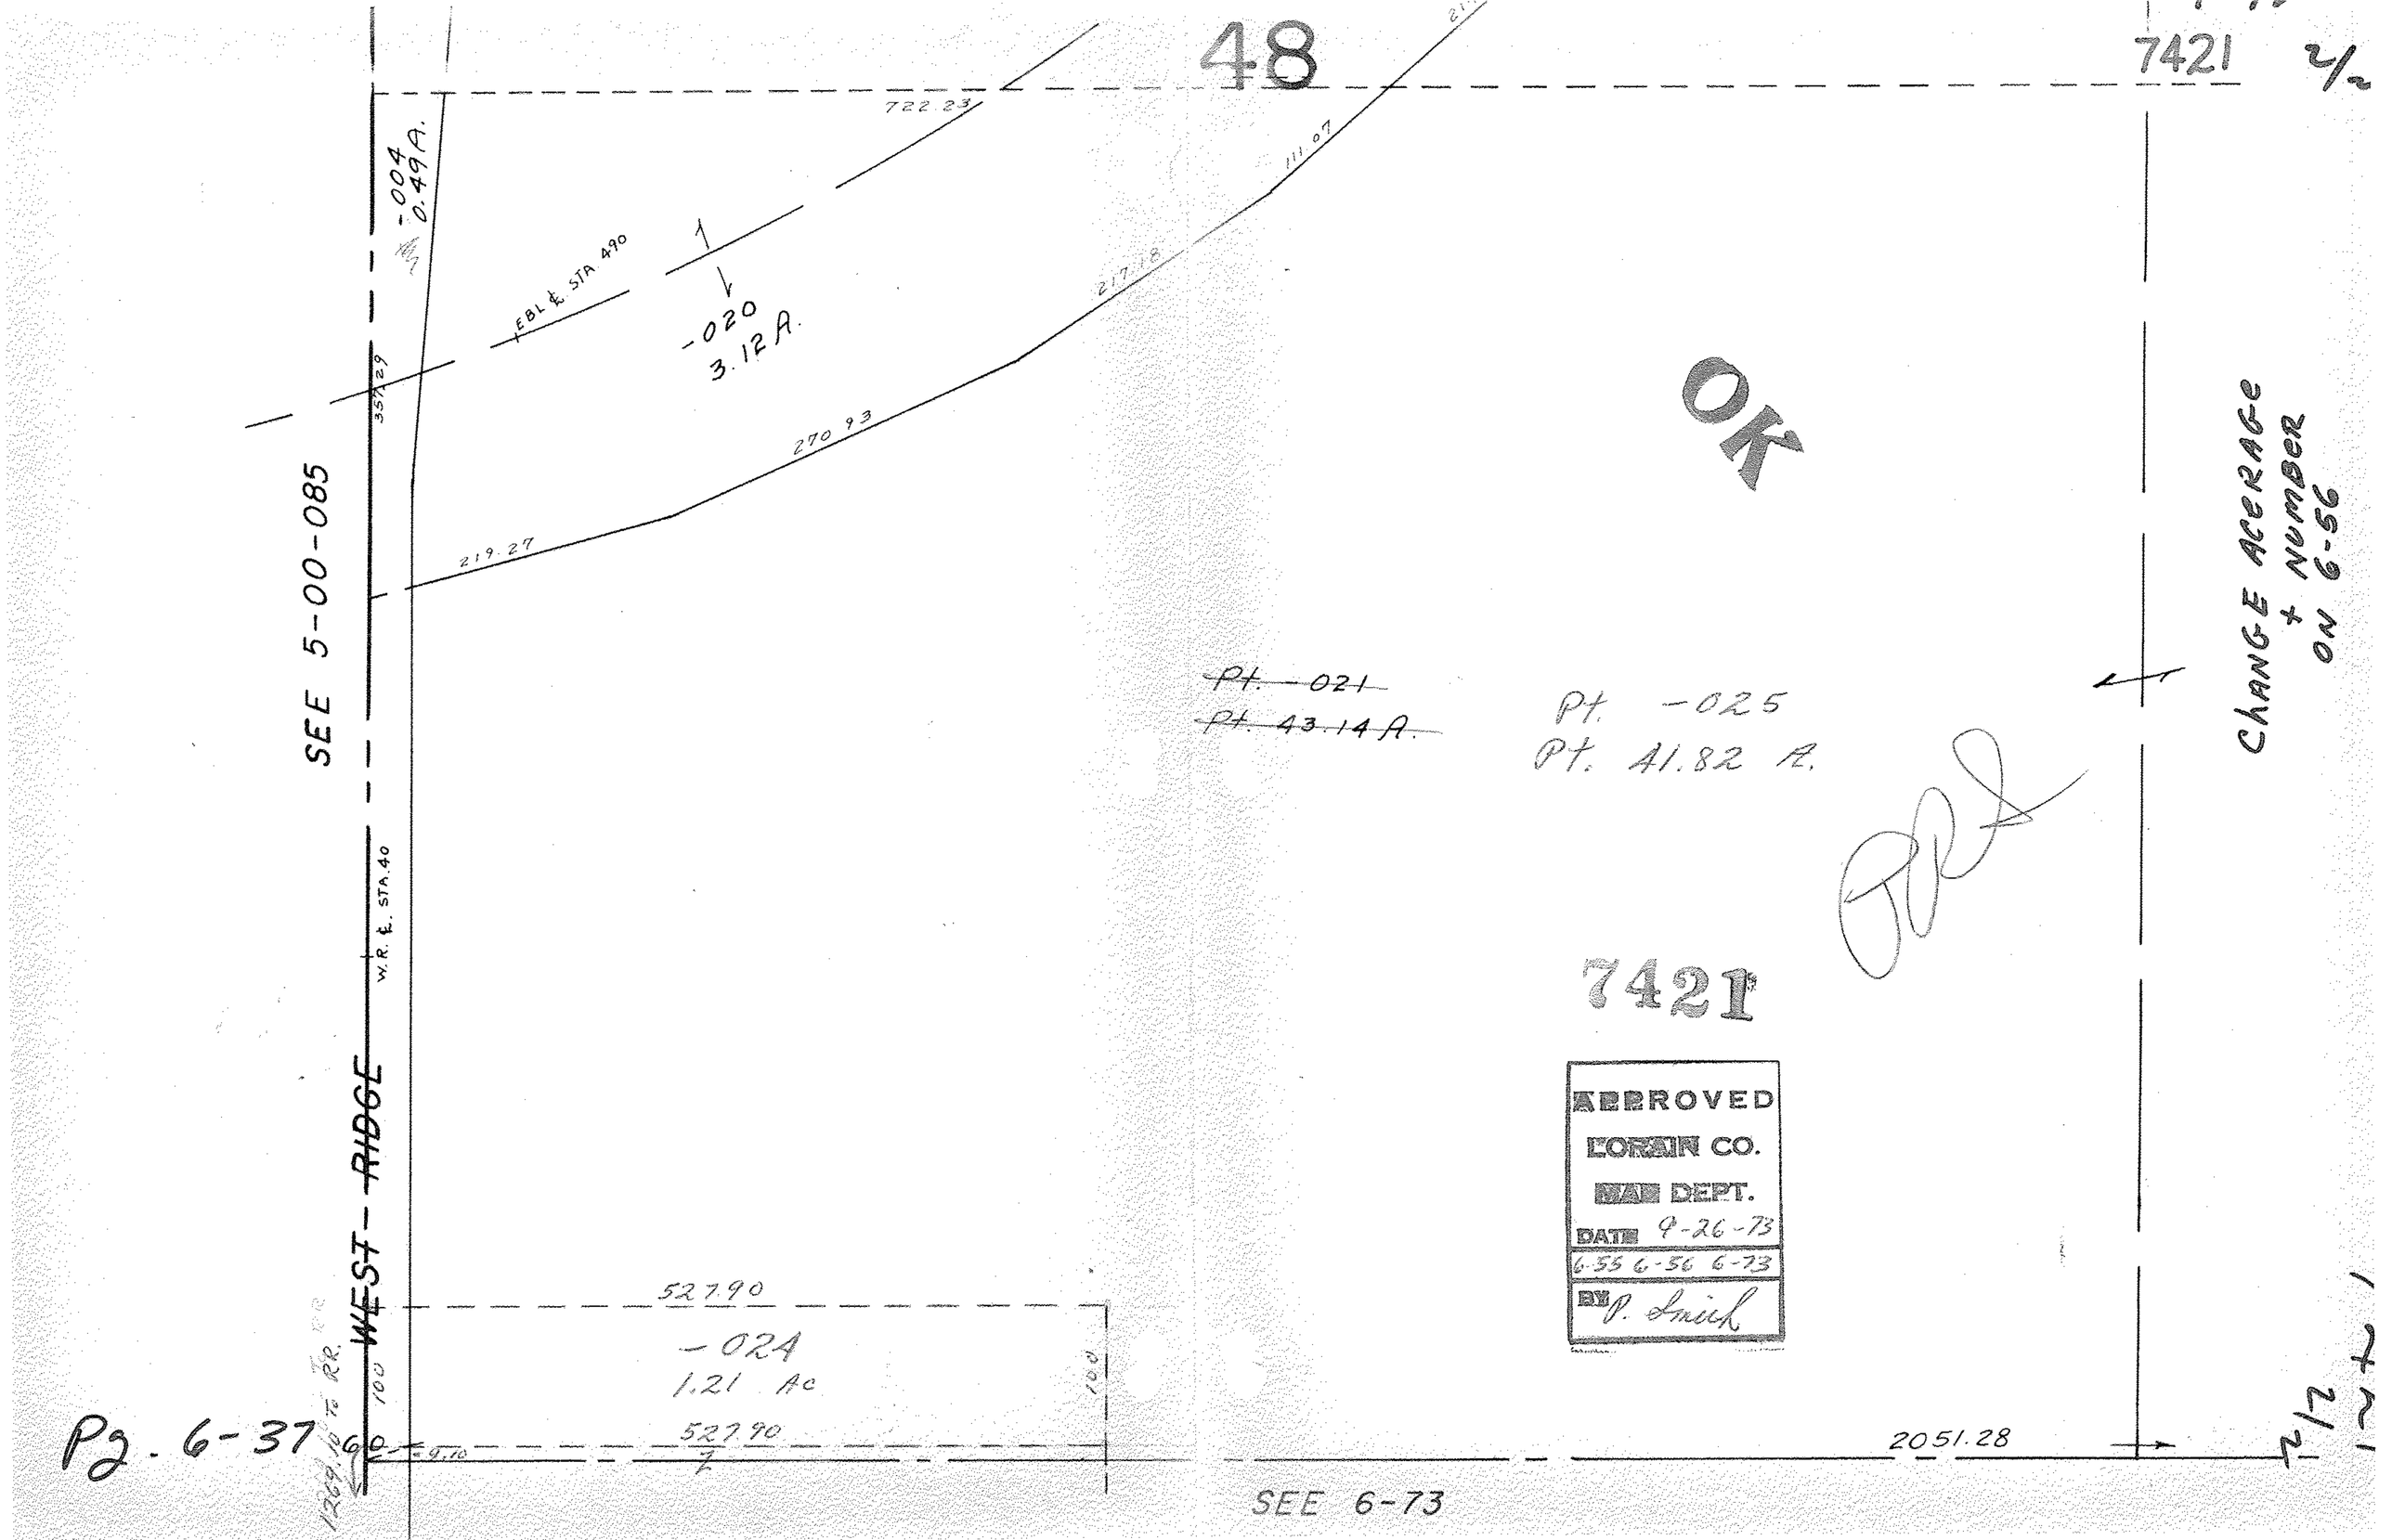
48
7421
2/2
722.23
111.07
217.18
270.93
219.27
357.29
-004
0.49 A.
EBL ℄ STA 490
-020
3.12 A.
OK
SEE 5-00-085
CHANGE ACERAGE + NUMBER ON 6-56
~~Pt. -021~~
~~Pt. 43.14 A.~~
Pt. -025
Pt. 41.82 A.
W.R. ℄ STA. 40
WEST RIDGE
7421
APPROVED
LORAIN CO.
MAP DEPT.
DATE 9-26-73
6-55 6-56 6-73
BY P. Smith
527.90
-024
1.21 Ac
527.90
100
100
2051.28
SEE 6-73
Pg. 6-37