


07-00-038 C & D

SUGAR RIDGE

7427

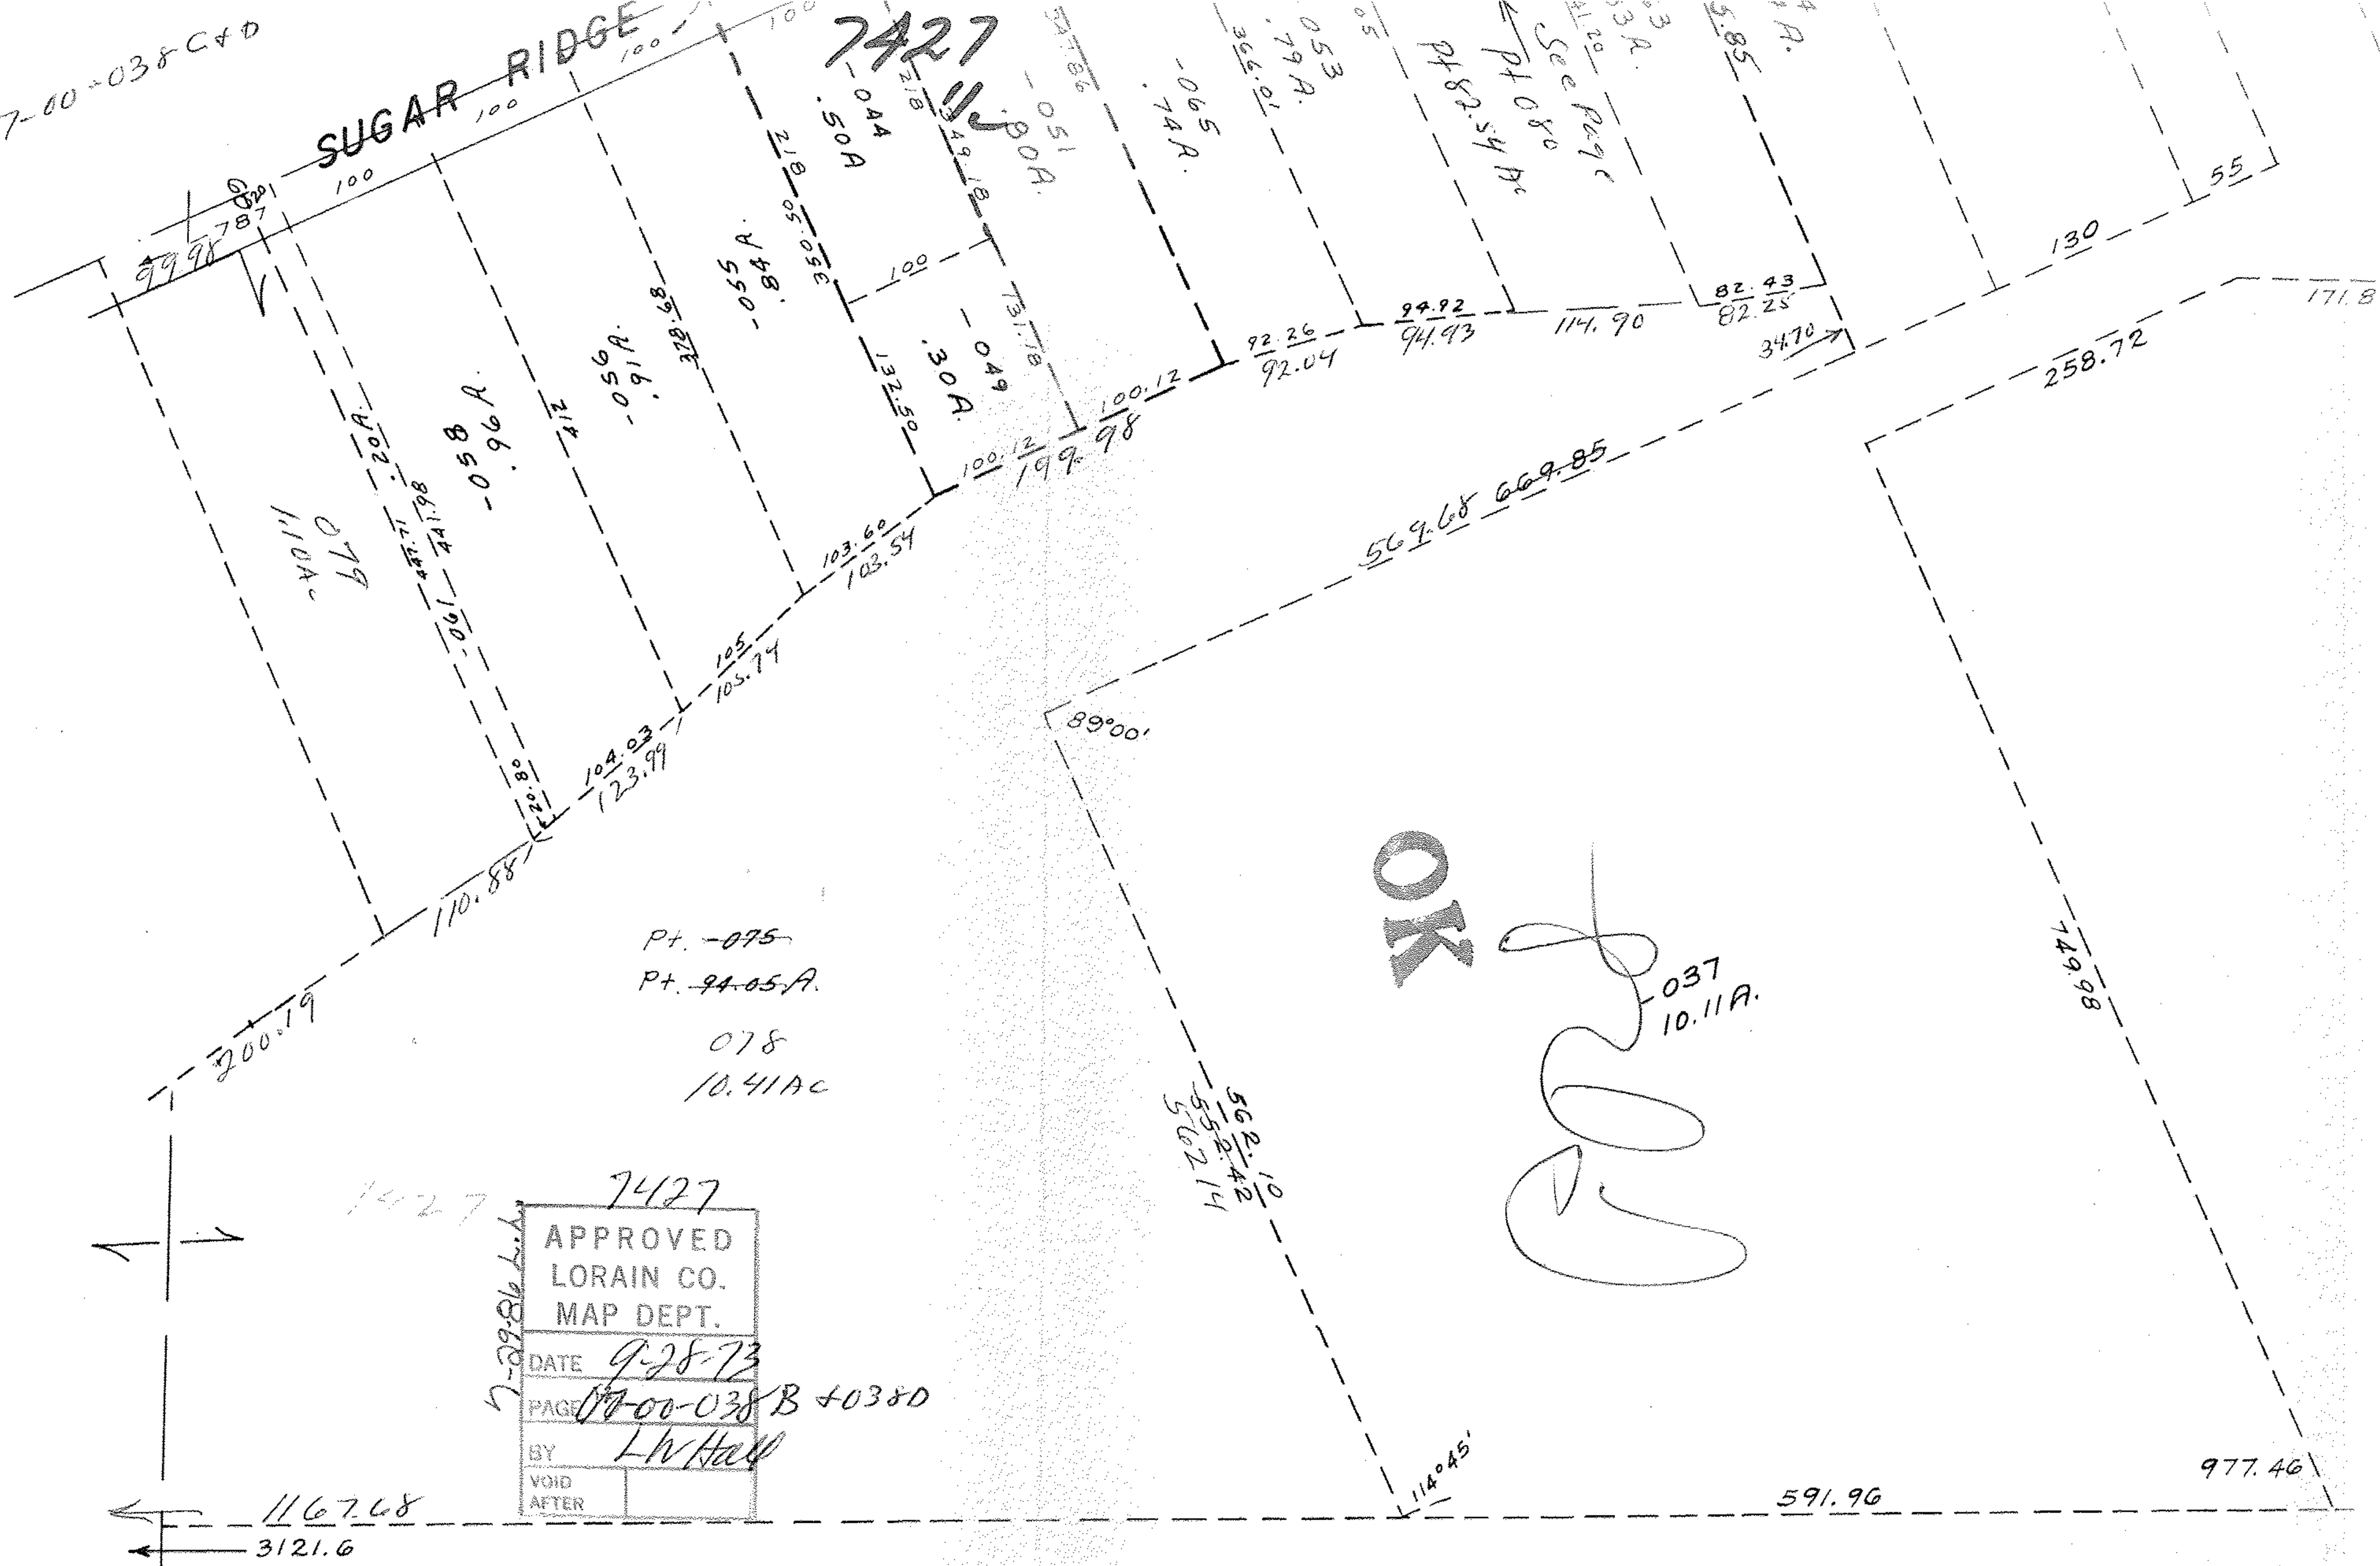

Pt. -075
Pt. 94.05.A.

078
10.41AC

7427

| |
|------------------------|
| APPROVED |
| LORAIN CO. |
| MAP DEPT. |
| DATE 9-28-73 |
| PAGE 07-00-038 B +0380 |
| BY L.W. Hall |
| VOID AFTER |

OK
[Signature]
-037
10.11A.

1167.68
3121.6

591.96

977.46