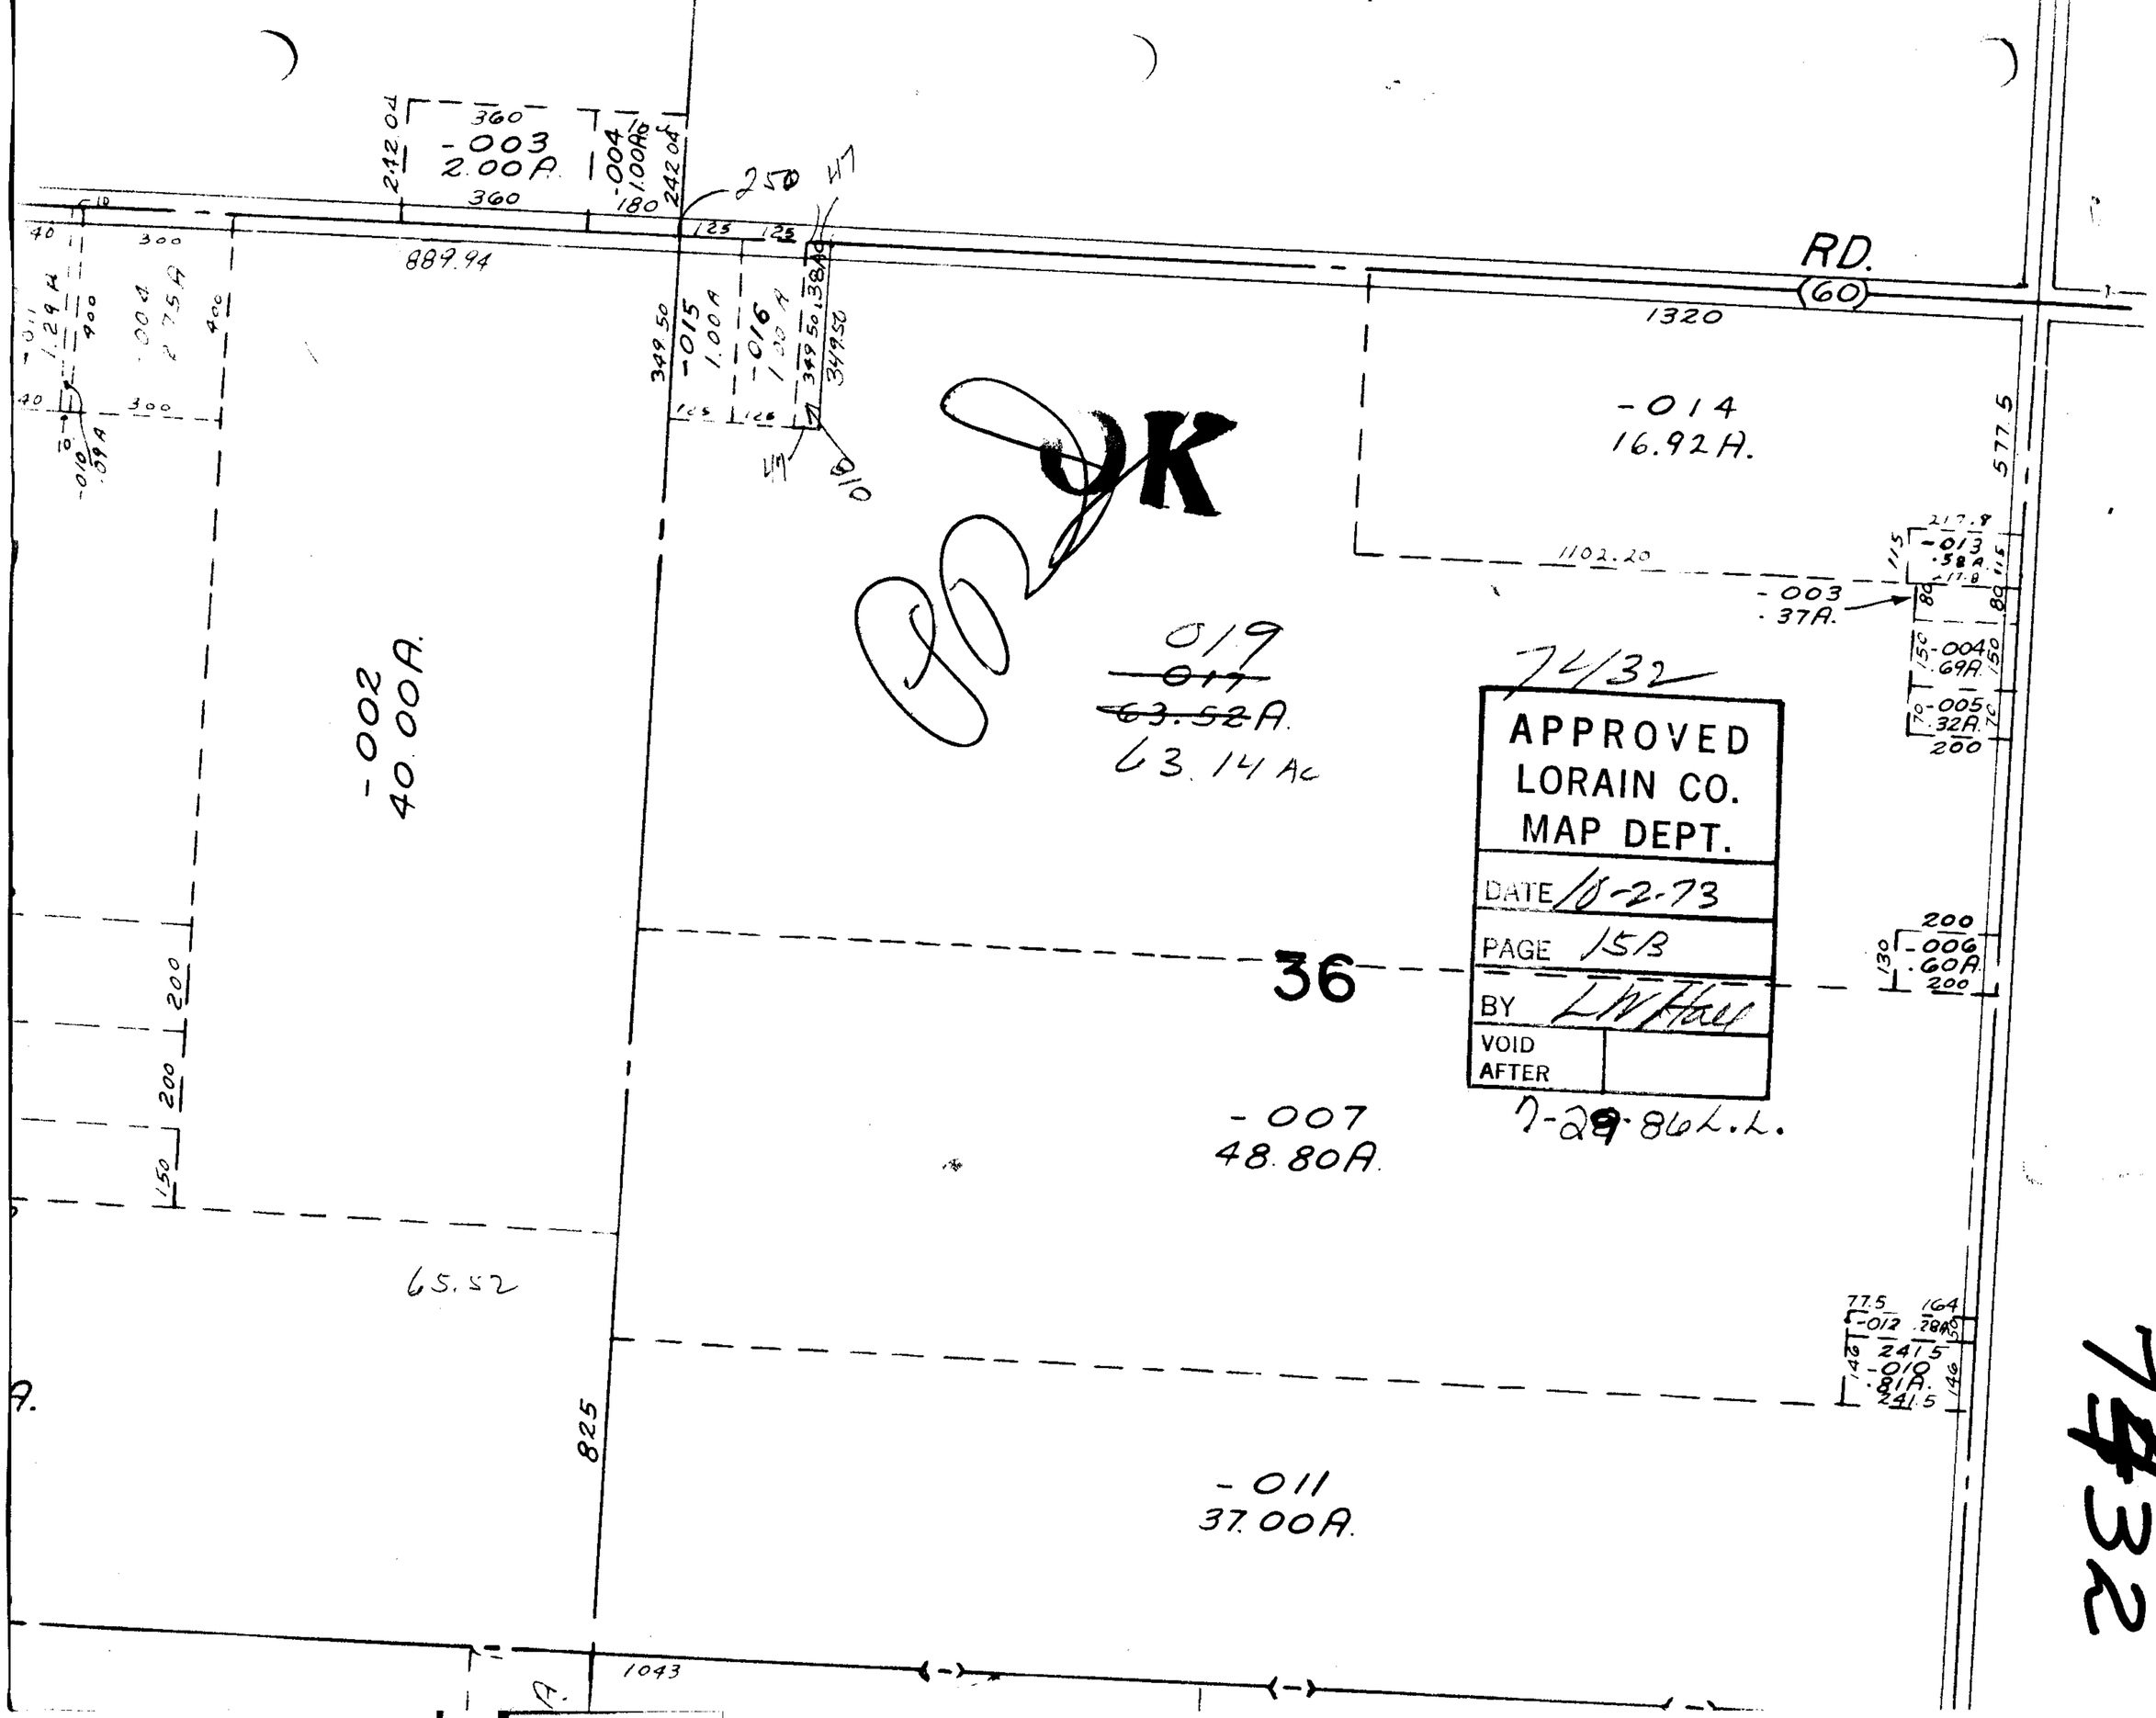

APPROVED
LORAIN CO.
MAP DEPT.
DATE 10-2-73
PAGE 15B
BY L.W. Hall
VOID AFTER
7-29-86 L.L.

7432