7453

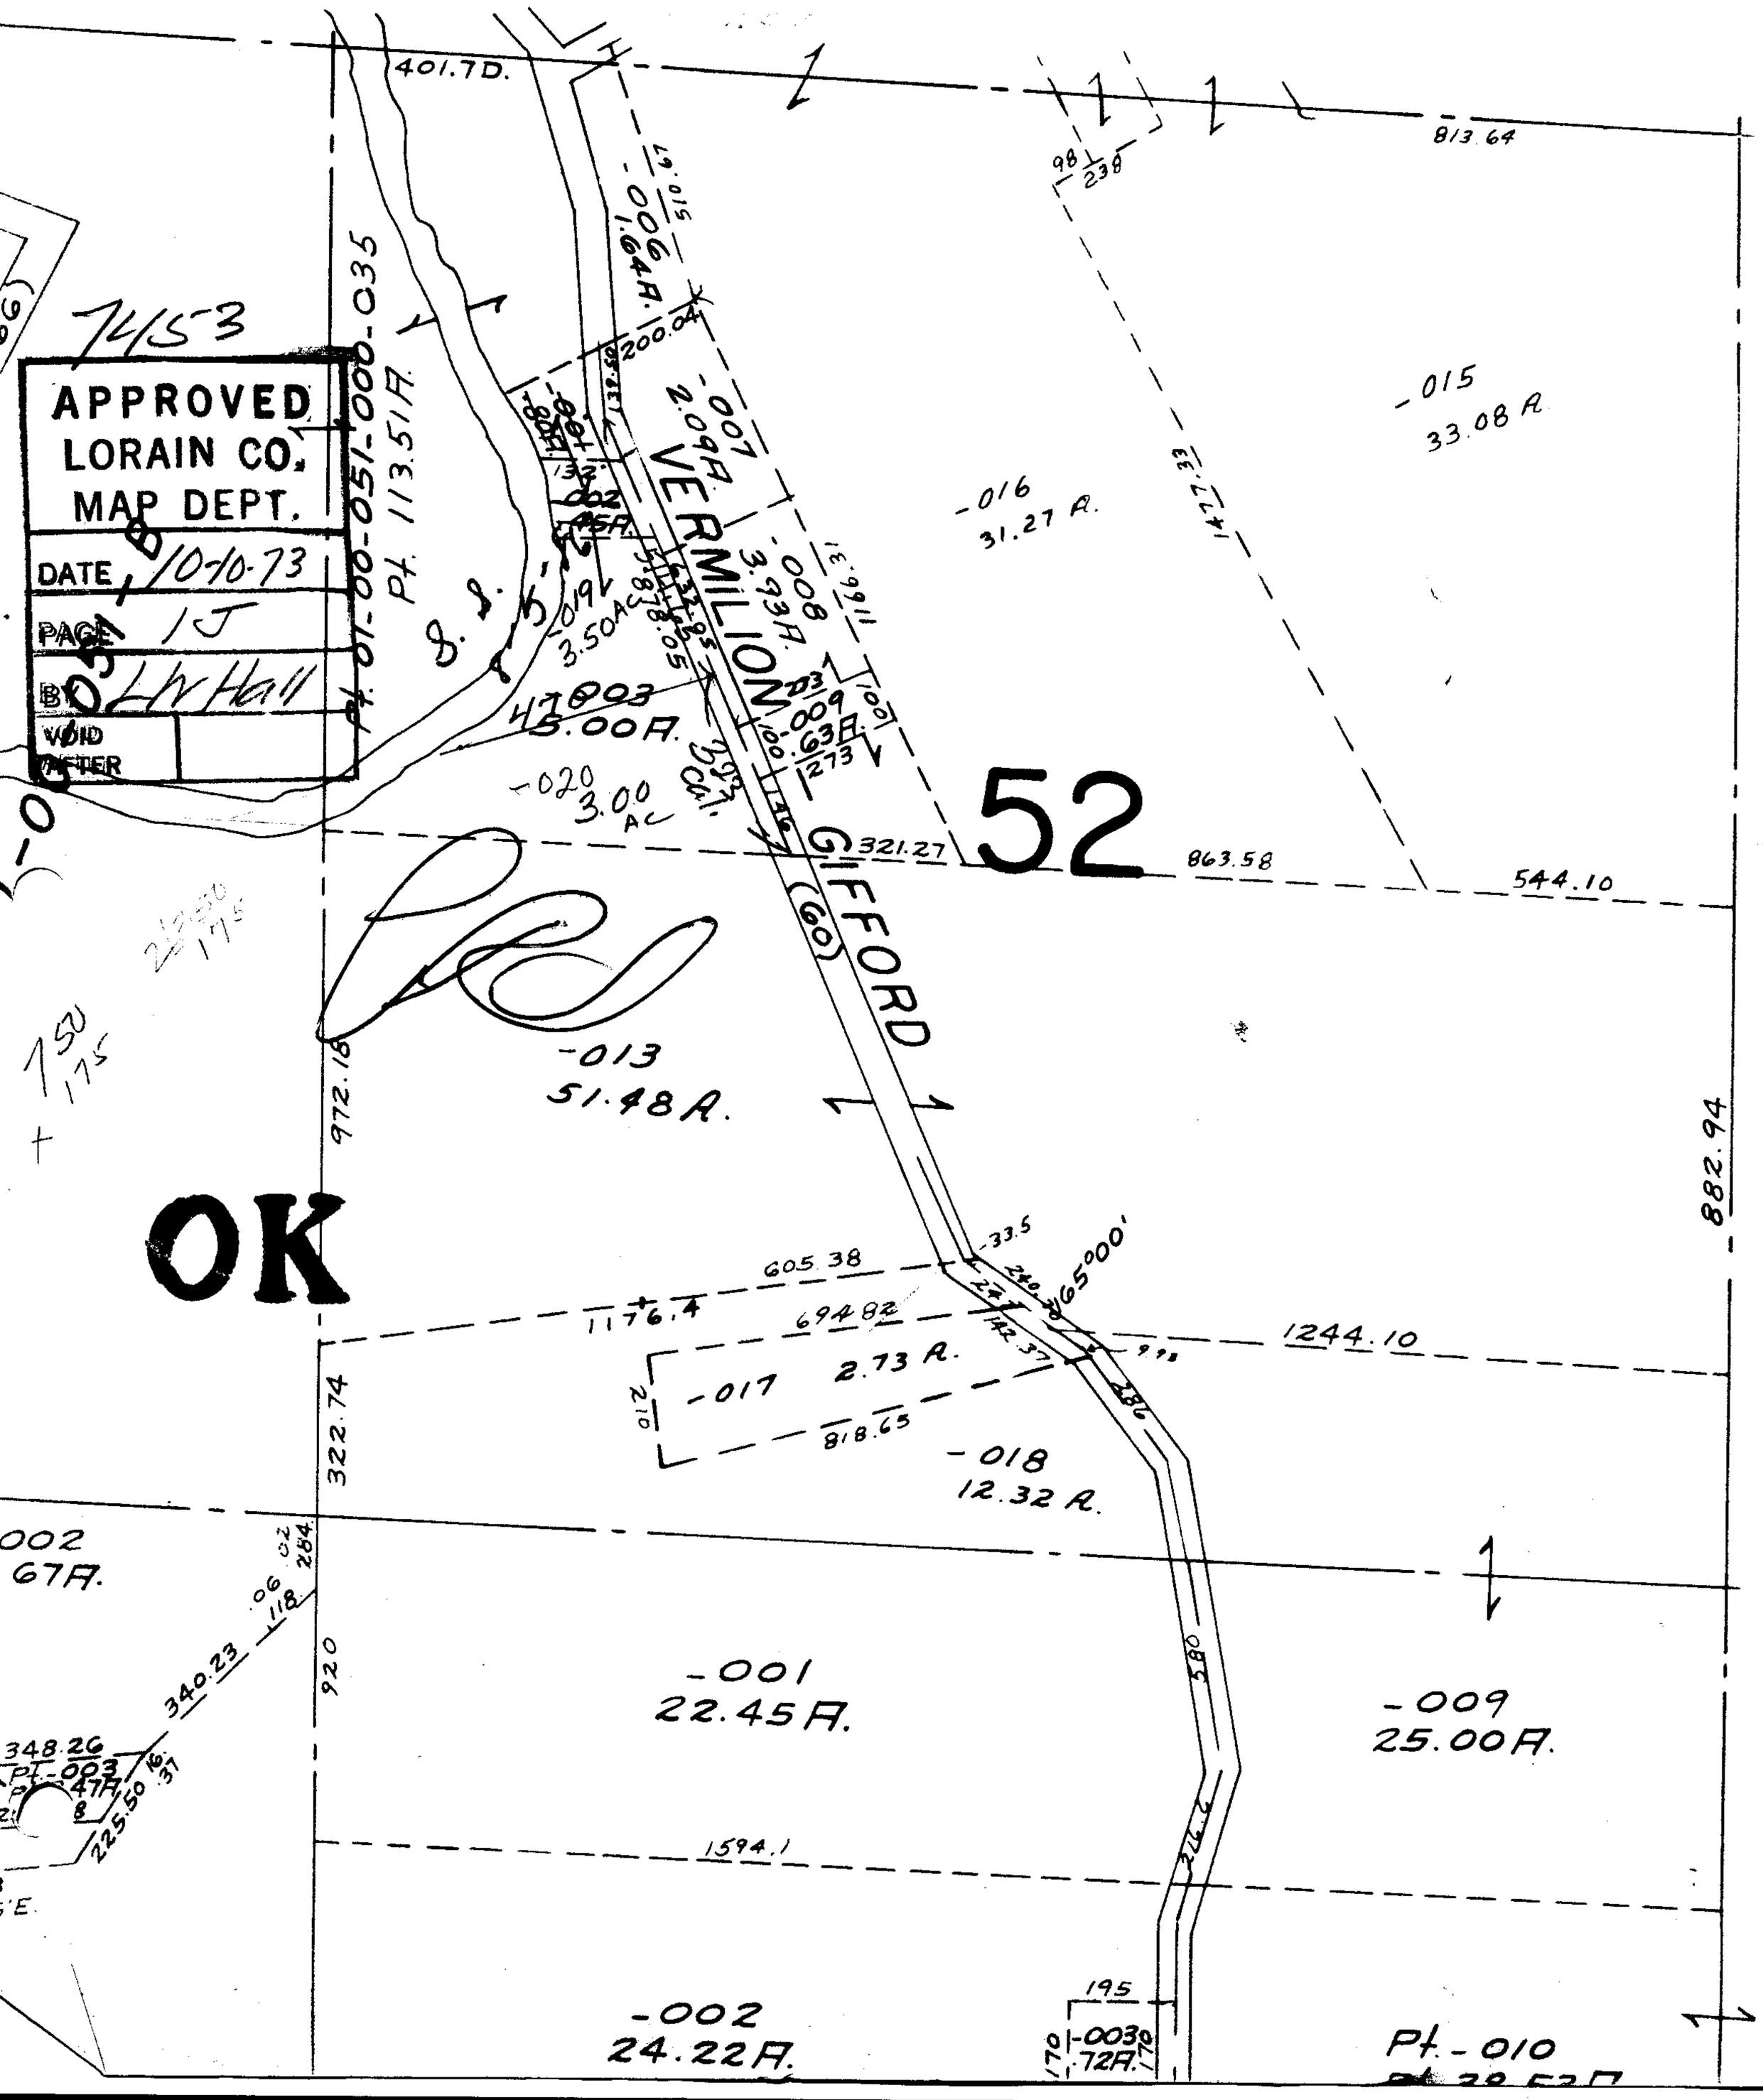
APPROVED
LORAIN CO.
MAP DEPT.
DATE 10-10-73
PAGE 1J
BY L.W. Hall
VOID AFTER
7453
OK
52
VERMILION
GIFFORD
401.7D.
813.64
863.58
544.10
1244.10
882.94
972.18
322.74
1594.1
-015
33.08 A.
-016
31.27 A.
-013
51.48 A.
-020
3.00 AC
-019
3.50 AC
-017
2.73 A.
-018
12.32 A.
-001
22.45 A.
-009
25.00 A.
-002
24.22 A.
-003
.72 A.
Pt.-010