7466

-087
7.80 A.

OK

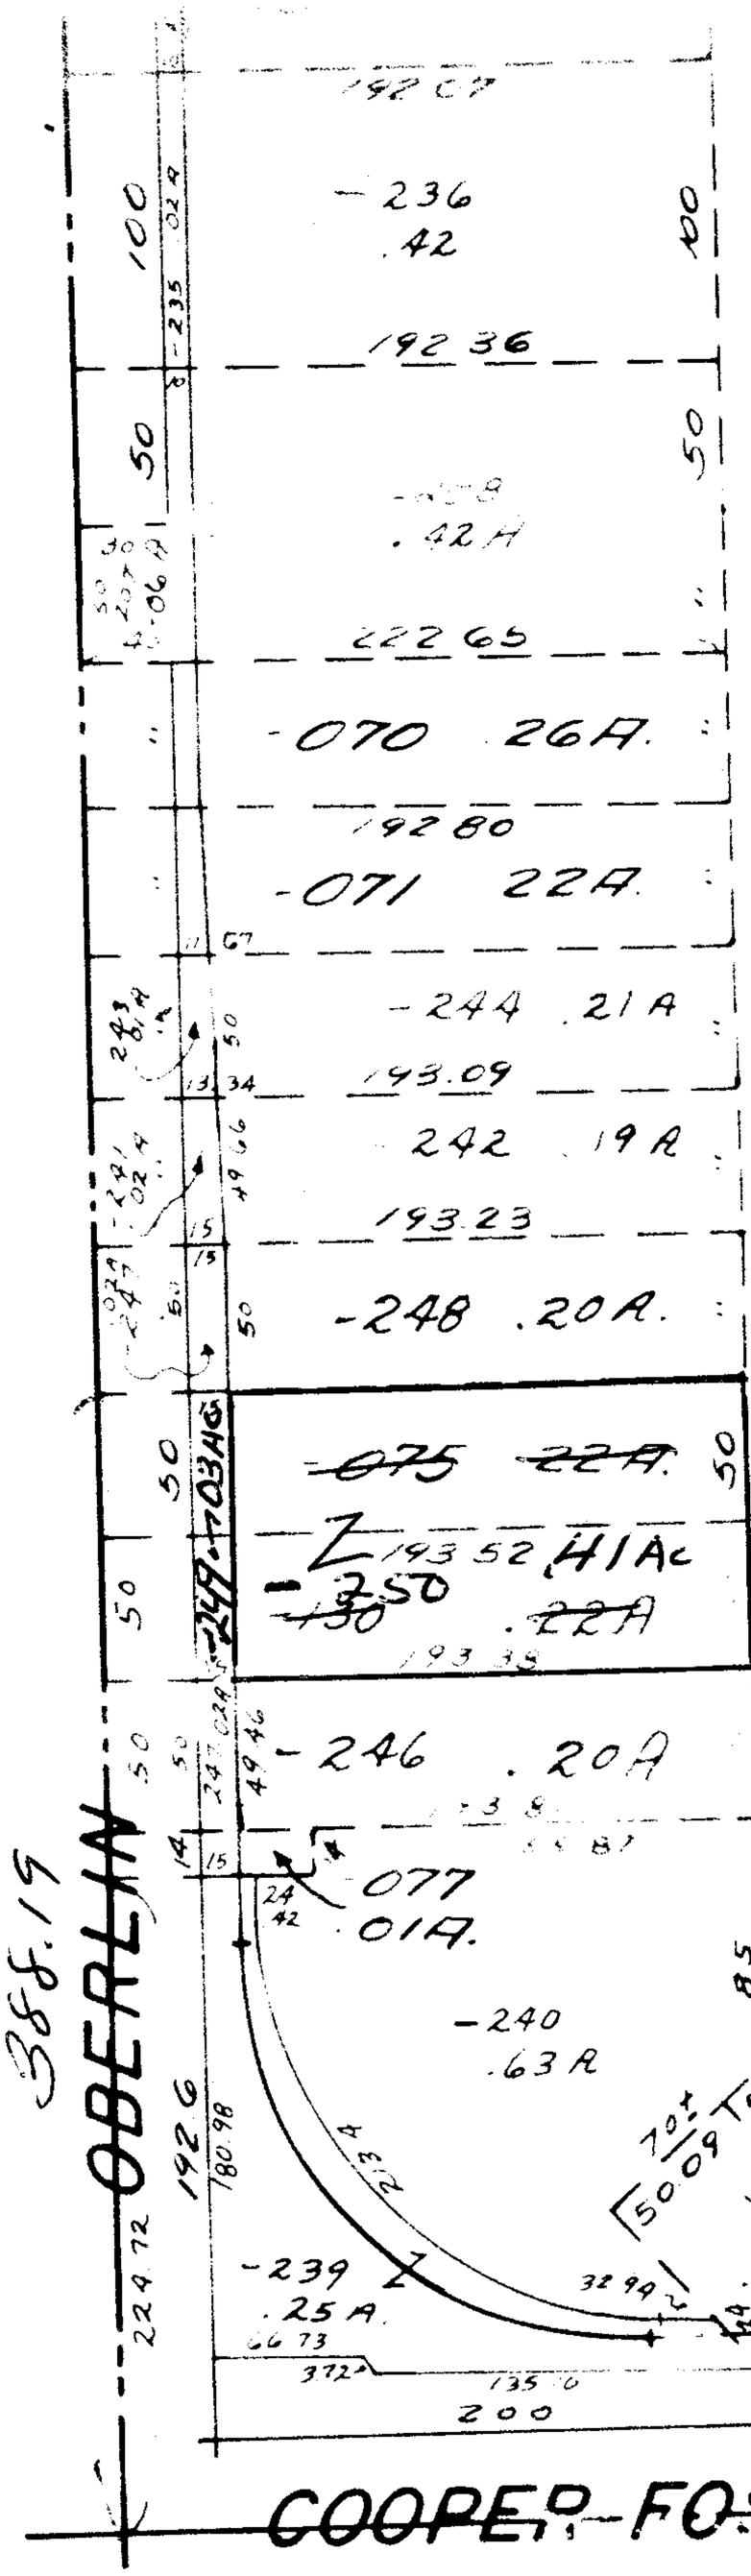

BLACK RIVER TW

SCALE: 1" = 100'