


7467
SECTION

LANE

118
119
120
121
122
123
124
125
126
127

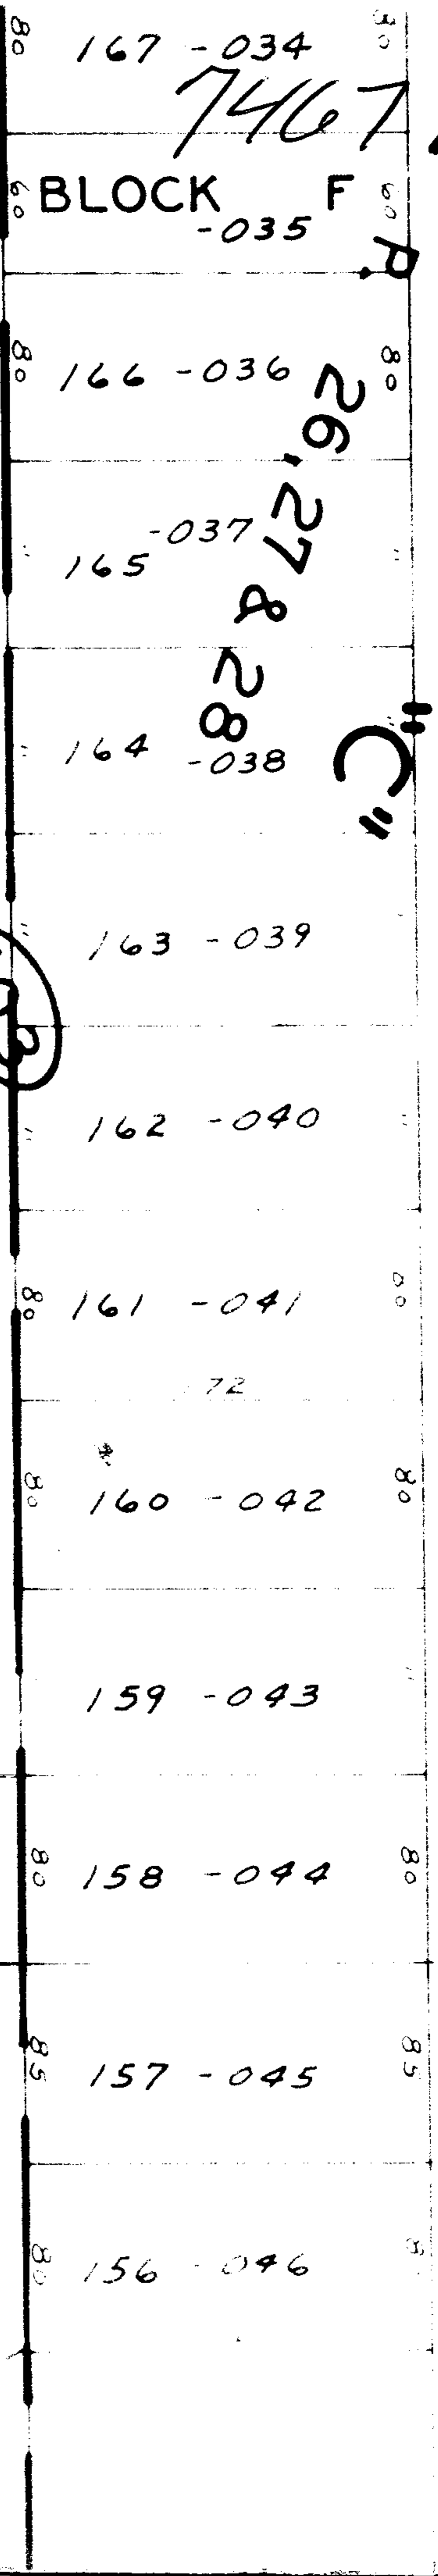

See Also
Sheet
7-00-005A

PT. 07-00-005-~~101~~115
103-~~067~~069
PT. ~~100~~1 A. 9.73 A.

PT. -065
PT. 5.56 A

[Handwritten scribbles]

OK

PT. -066
14.54 A.

7467

APPROVED LORAIN CO. MAP DEPT.
DATE 10-16-73
PAGE 7-00-005C & 7-00-005A
BY L.W. Hall
VOID AFTER

210.19

7-00-005C

100