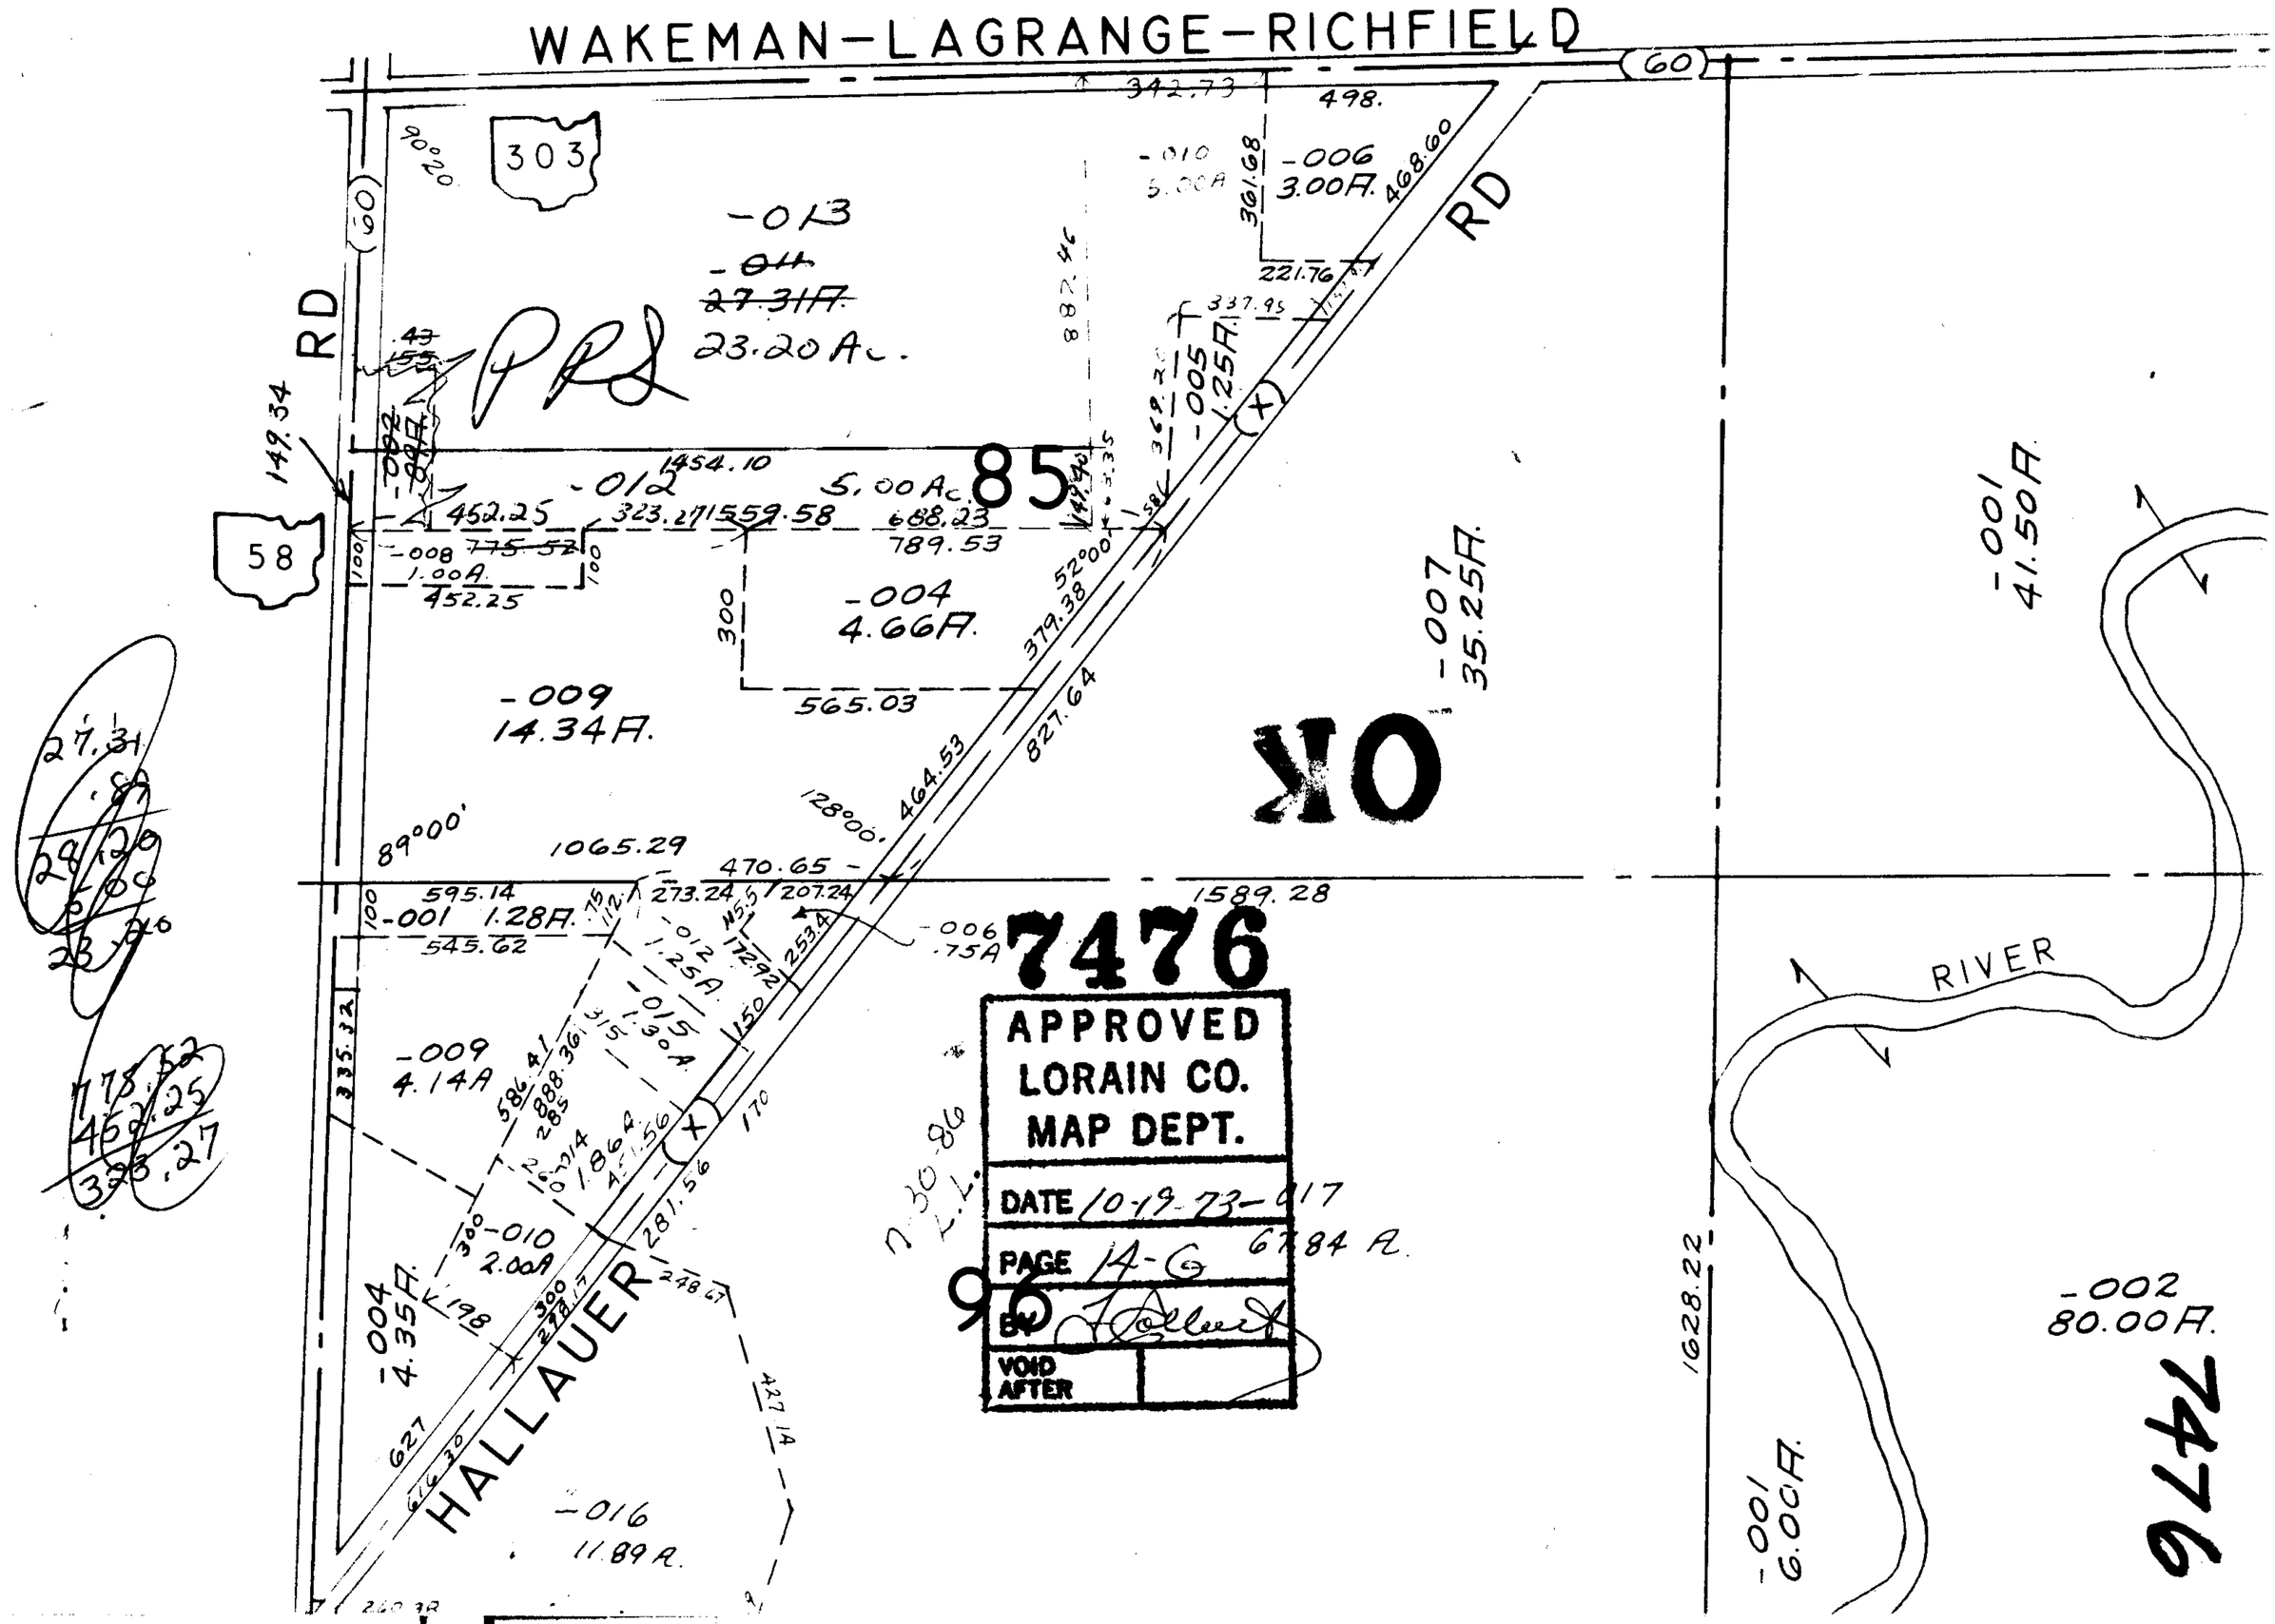
WAKEMAN-LAGRANGE-RICHFIELD
60
303
58
RD
-013
~~-011~~
~~27.31A.~~
23.20 Ac.
PRJ
-012
5.00 Ac.
85
-004
4.66A.
-009
14.34A.
-006
3.00A.
-005
1.25A.
-007
35.25A.
-001
41.50A.
-002
80.00A.
-001
6.00A.
-004
4.35A.
-010
2.00A
-009
4.14A
-001
1.28A.
-016
11.89A.
HALLAUER
RIVER
OK
7476
APPROVED
LORAIN CO.
MAP DEPT.
DATE 10-19-73-017
PAGE 14-G
BY
VOID AFTER
96
7476