


7492

-030
64.00A

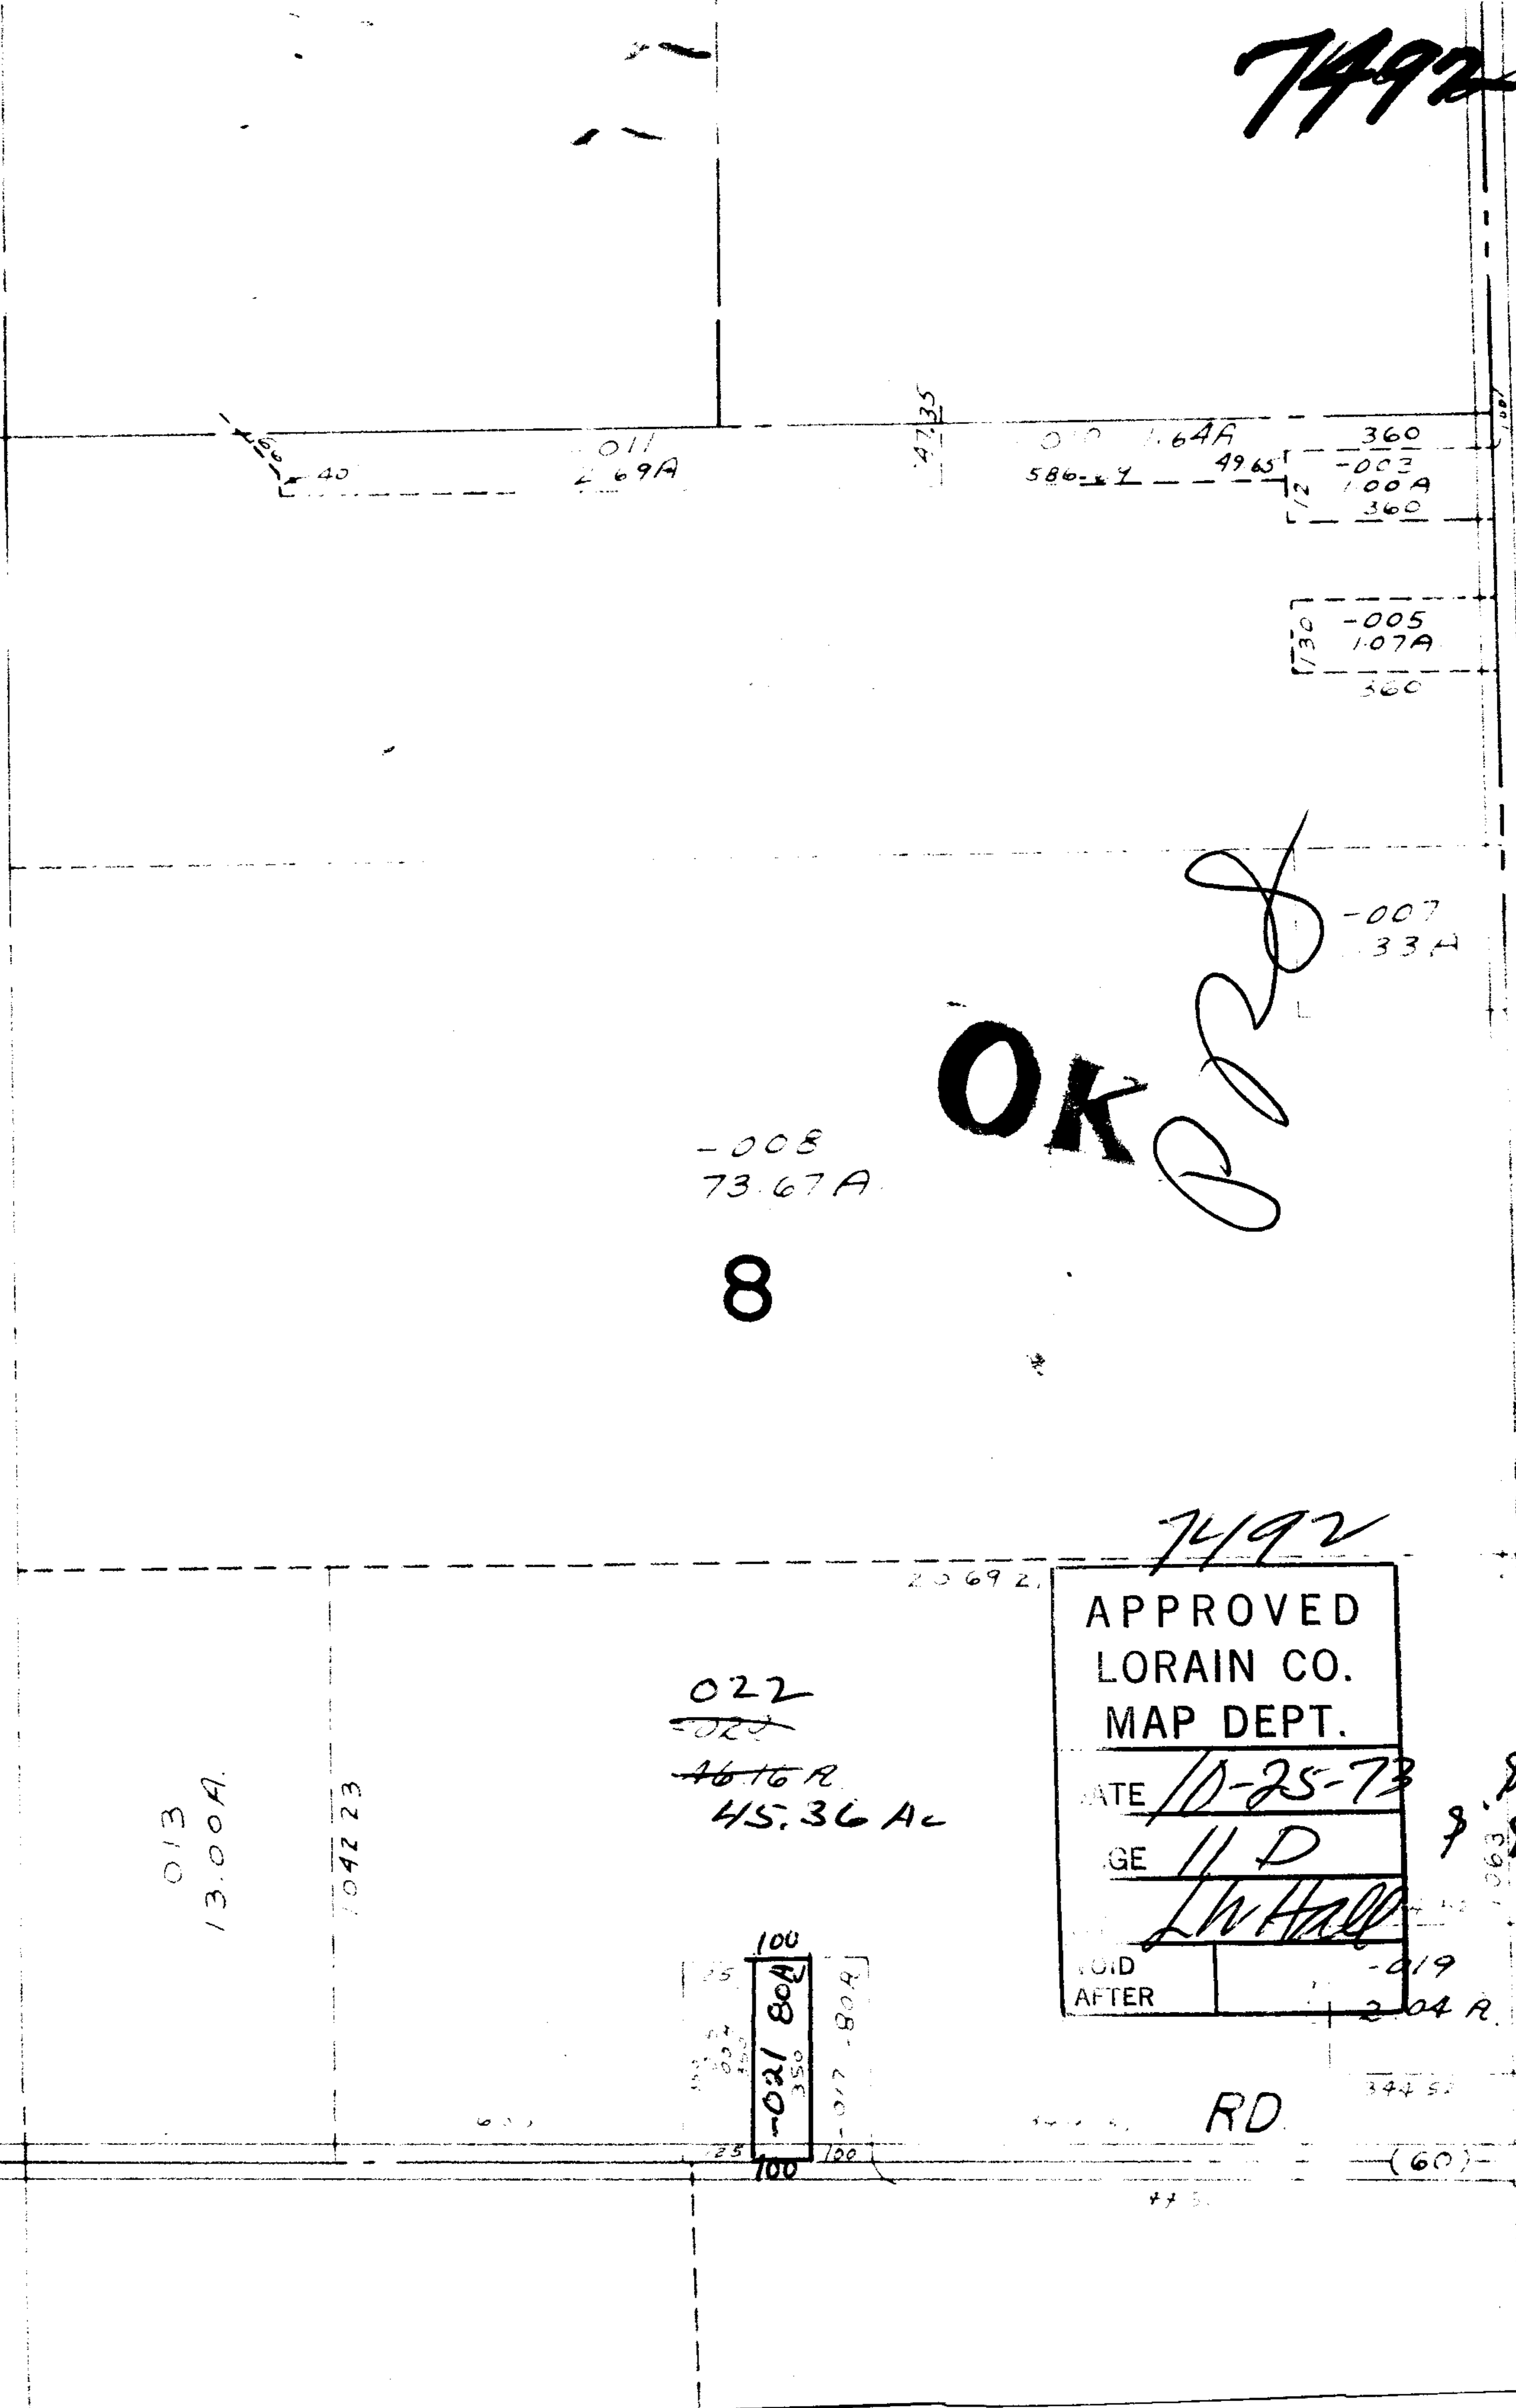

011
269A

010 1.64A
586-24 4965
360
-003
100A
360

130
-005
107A
360

-007
33A

-008
73.67A

8

OK

P. P. P.

7492

APPROVED LORAIN CO. MAP DEPT.	
DATE	10-25-73
ENGINEER	L. W. Hall
VOID AFTER	-019 204R

022
~~022~~
46.16R
45.36Ac

013
13.00A
104223

100
-021 80A
350
-017 -80A
100

RD.

8-8-5-86

34452

(60)