
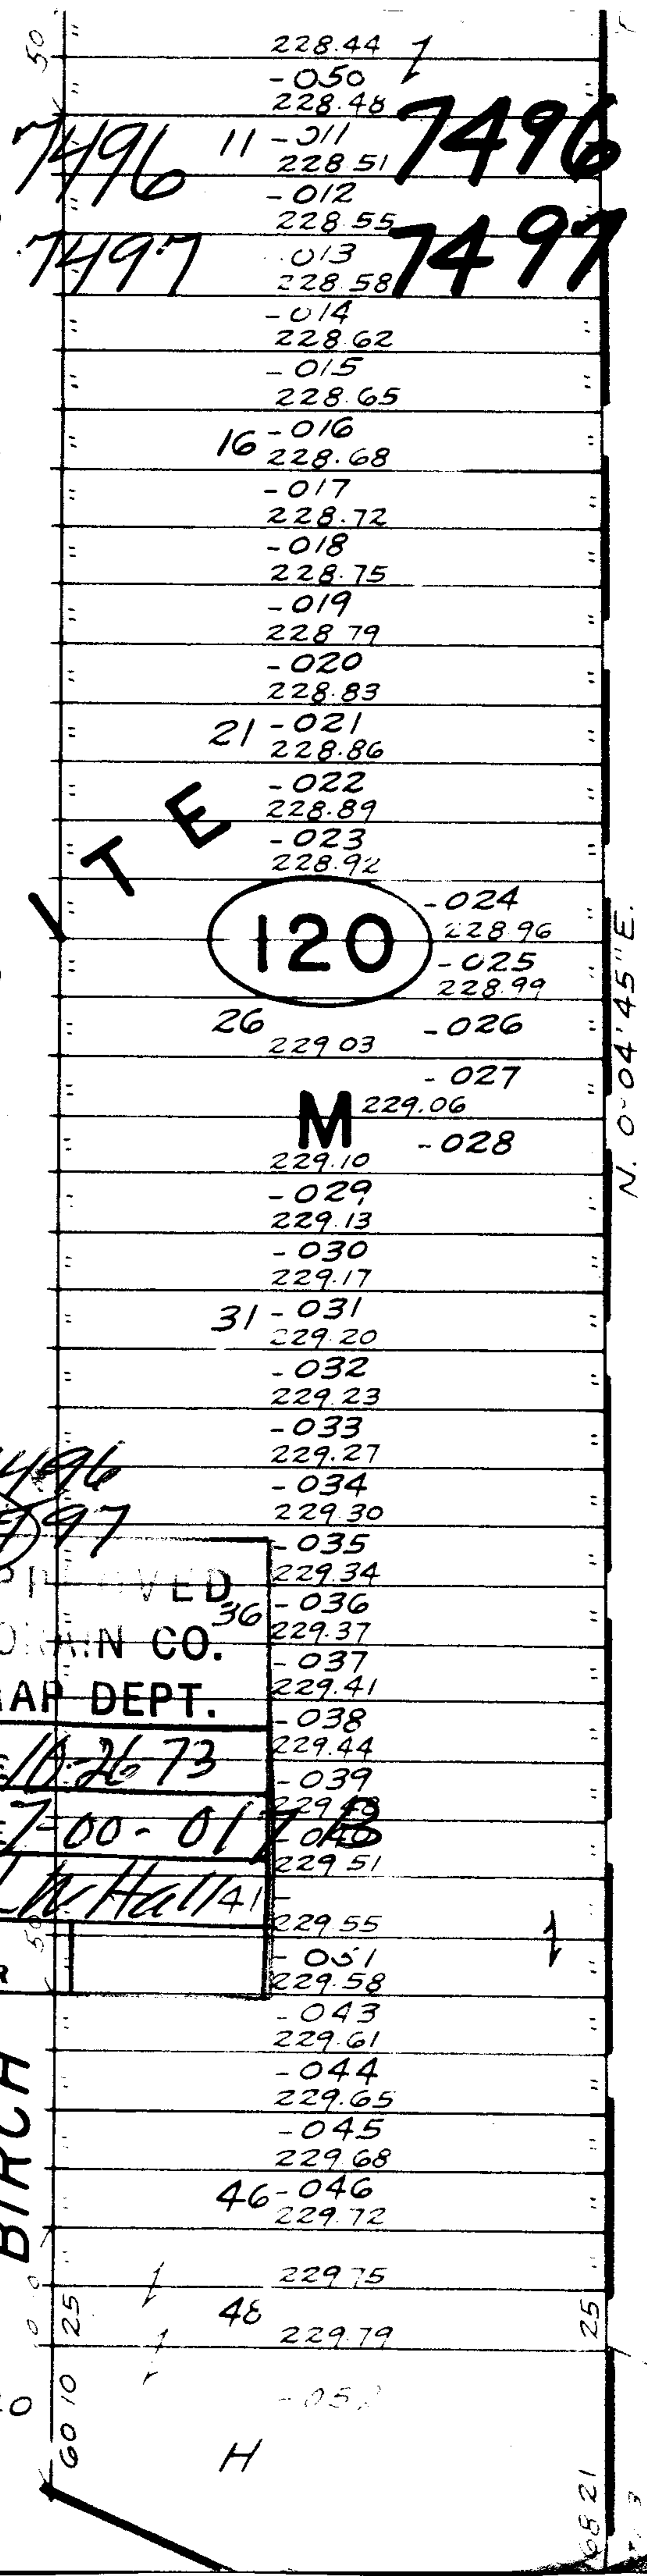
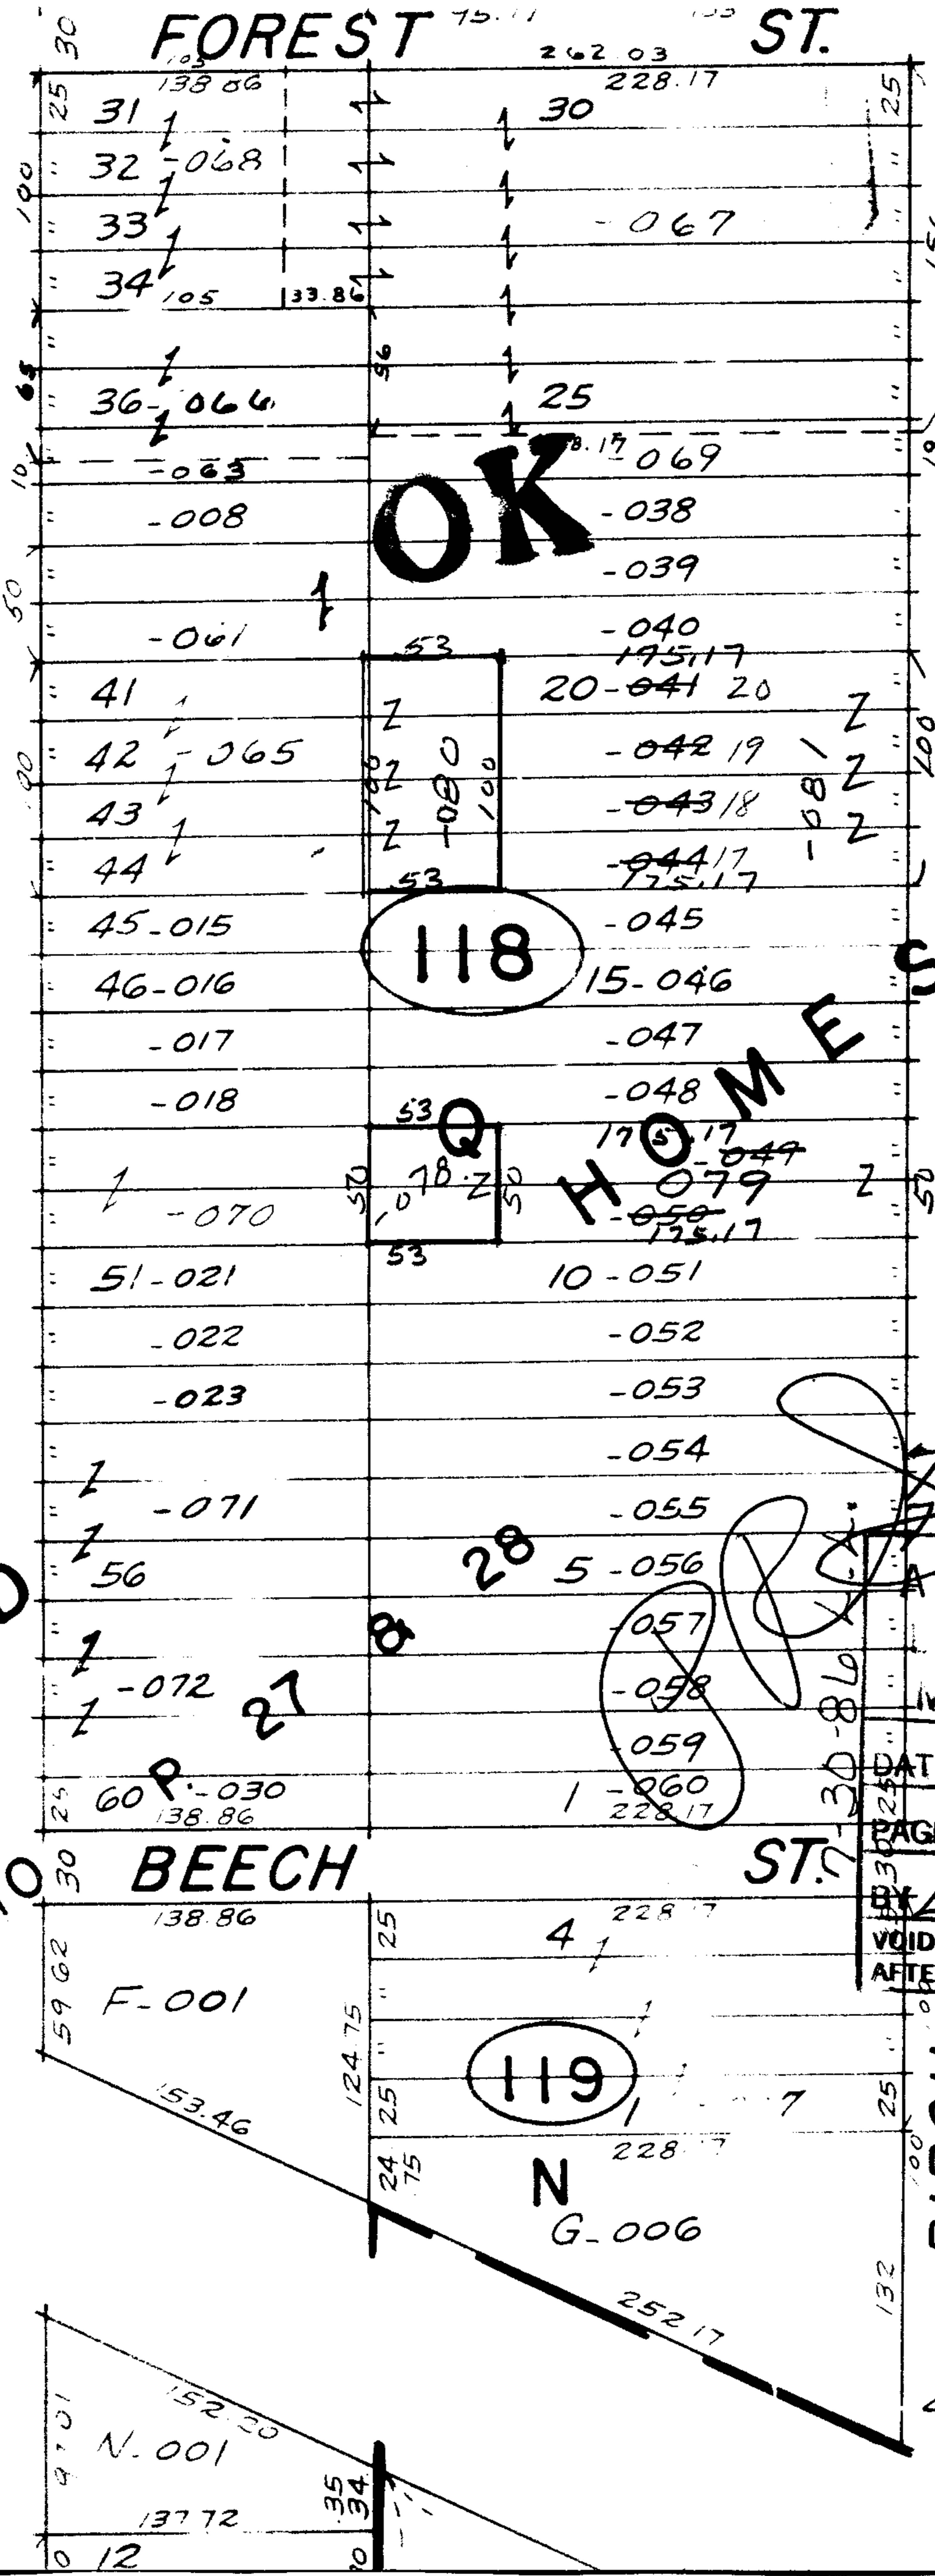


FOREST ST.

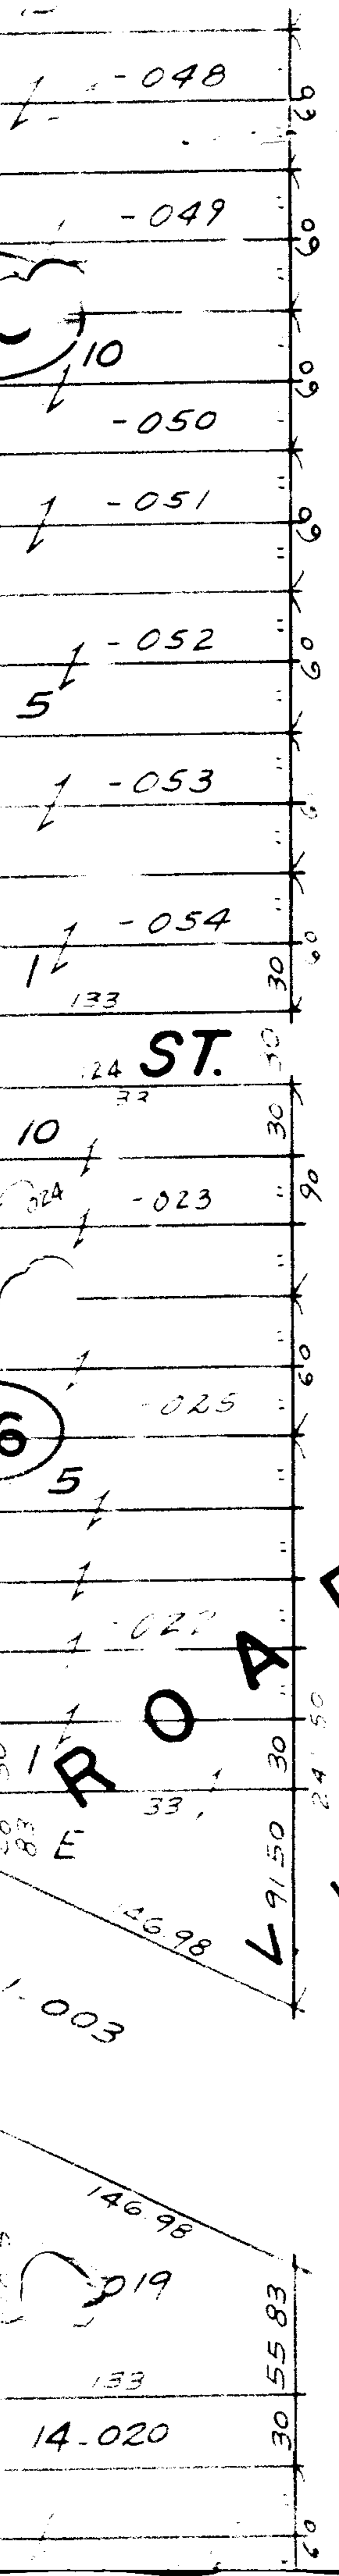

OK

118

120

HOME SITE

APPROVED
LORAIN CO.
MAP DEPT.
DATE 10-26-73
PAGE 7-00-01
BY L. W. Hall

BEECH

BIRCH

N. 0-04' 45" E.