


7509

WAKEMAN-LAGRANGE-RICHFIELD

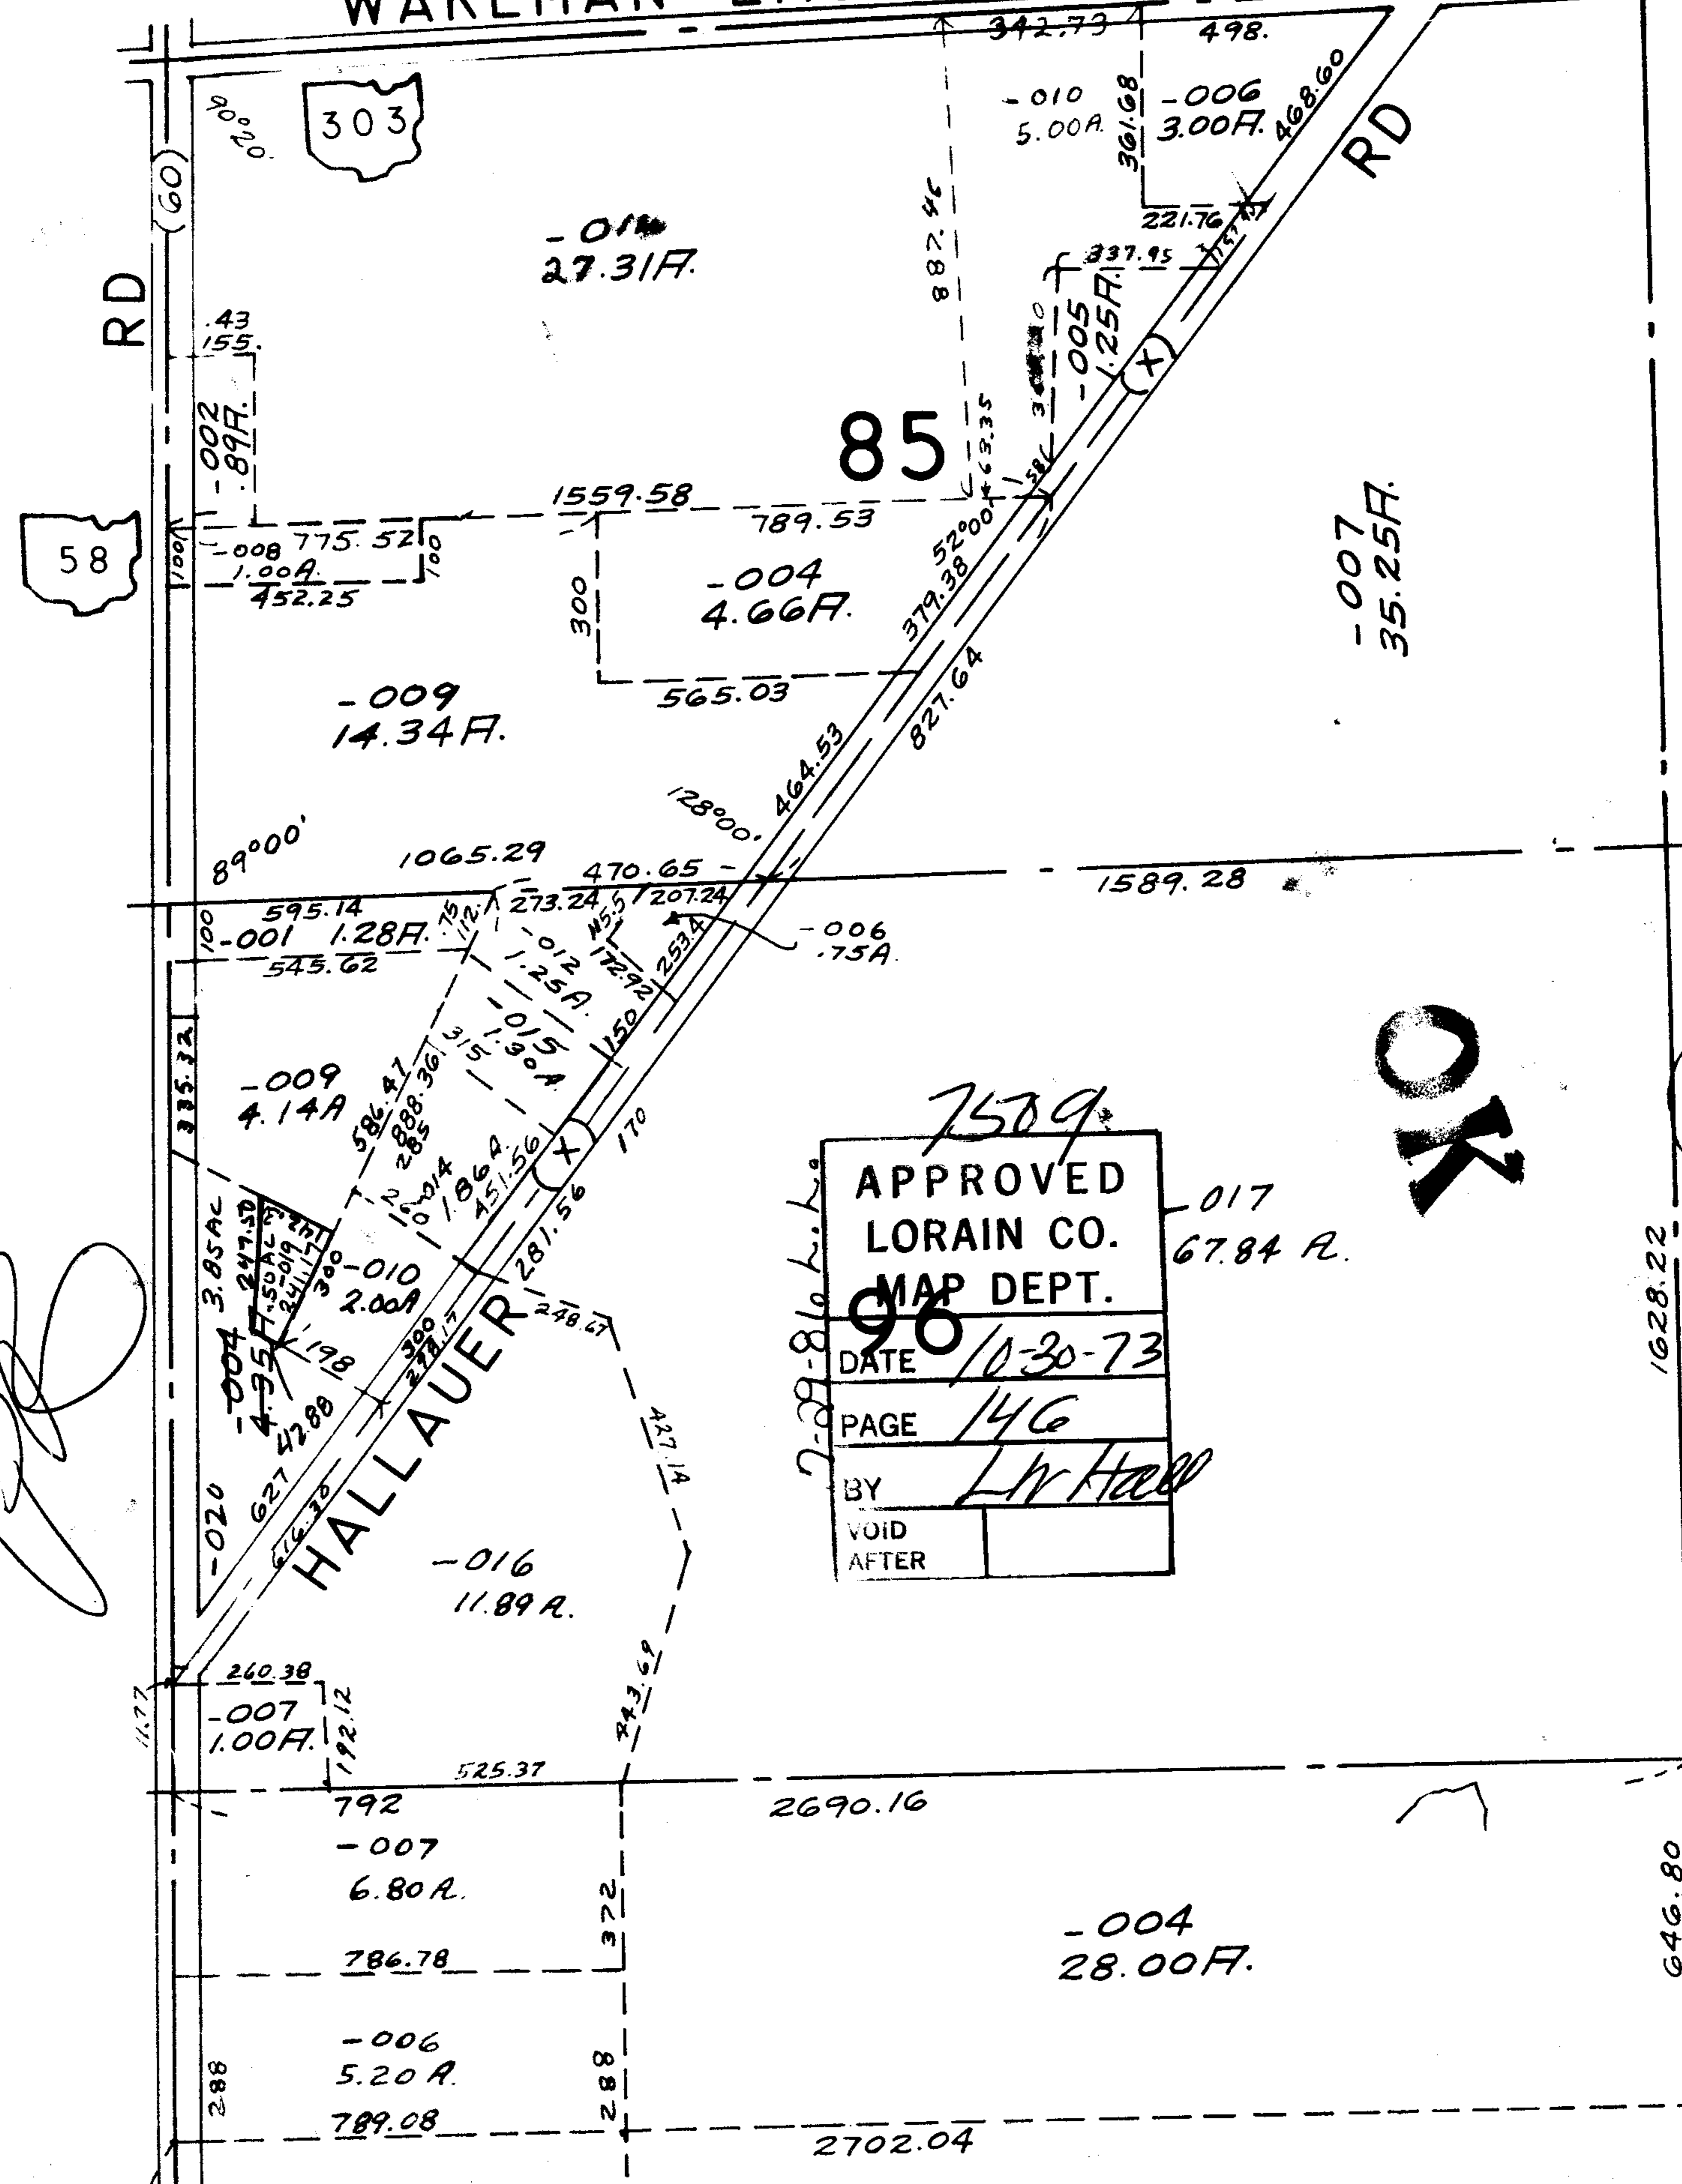

7509

APPROVED	
LORAIN CO.	
MAP DEPT.	
DATE	10-30-73
PAGE	146
BY	L. H. Hall
VOID	
AFTER	

OK

