


OK

7532

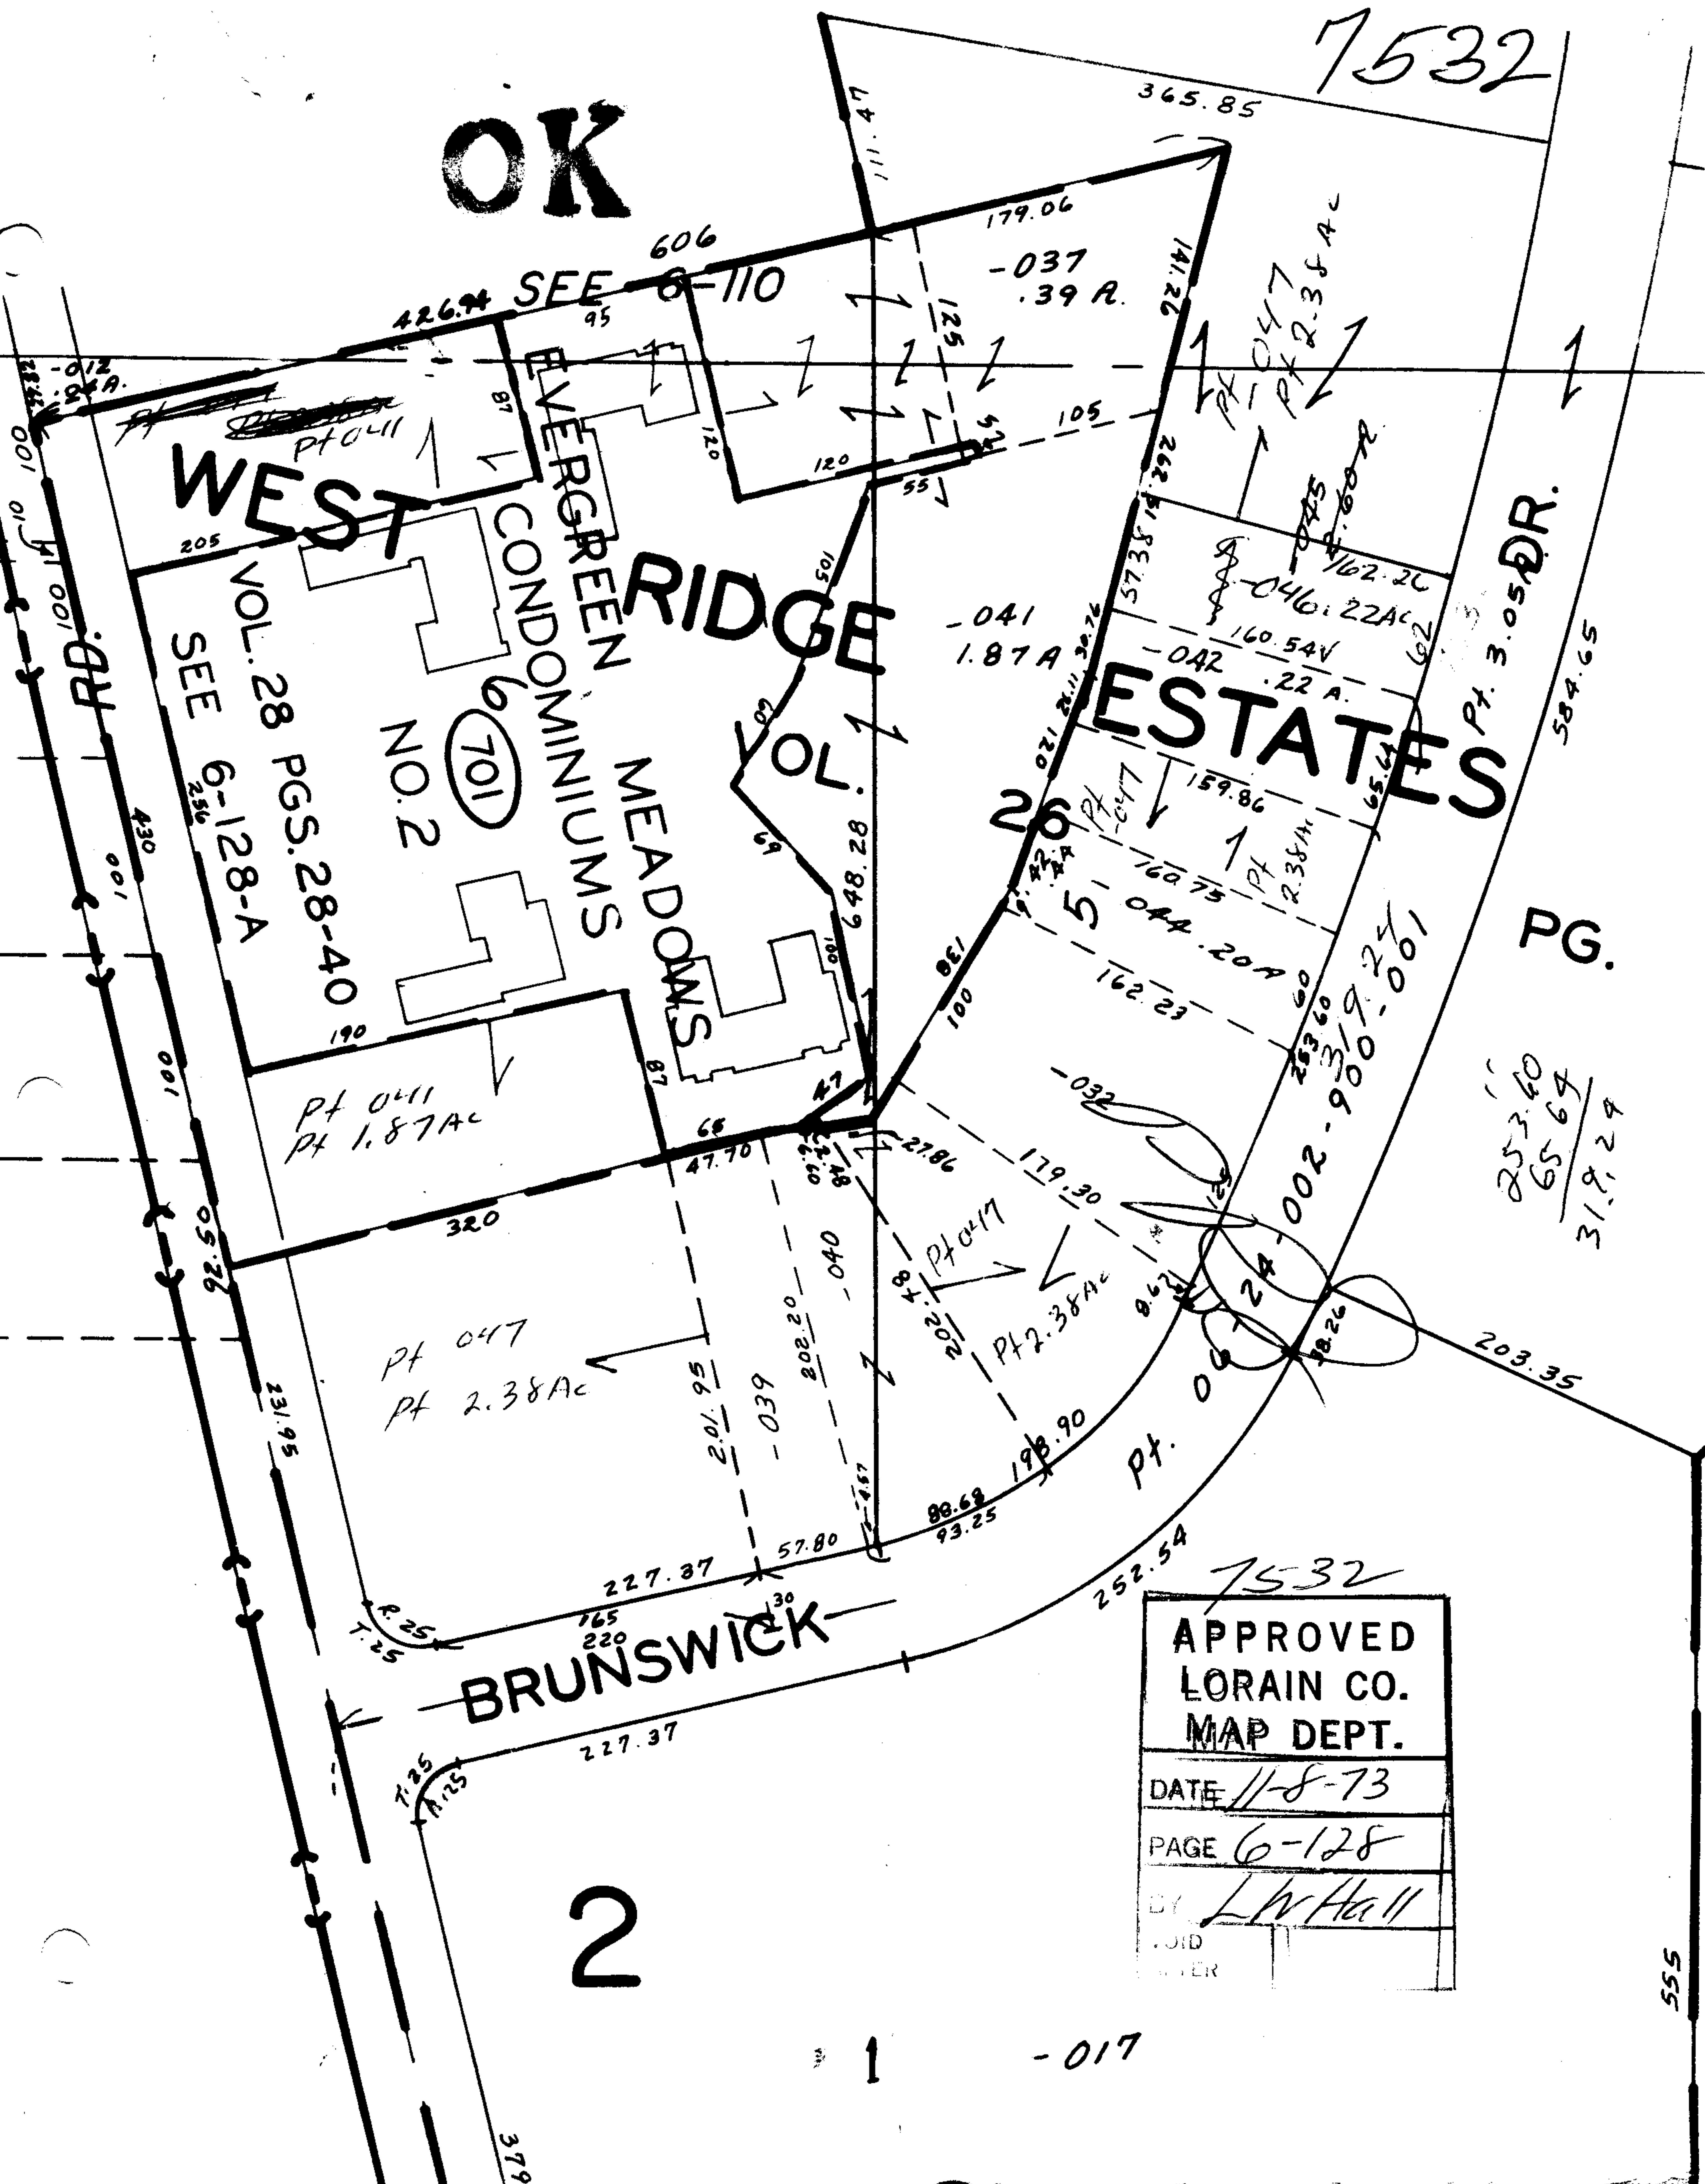

WEST

RIDGE

ESTATES

BRUNSWICK

2

APPROVED
LORAIN CO.
MAP DEPT.
DATE 11-8-73
PAGE 6-128
BY L.W. Hall
VOID
IF


7532

-017

555