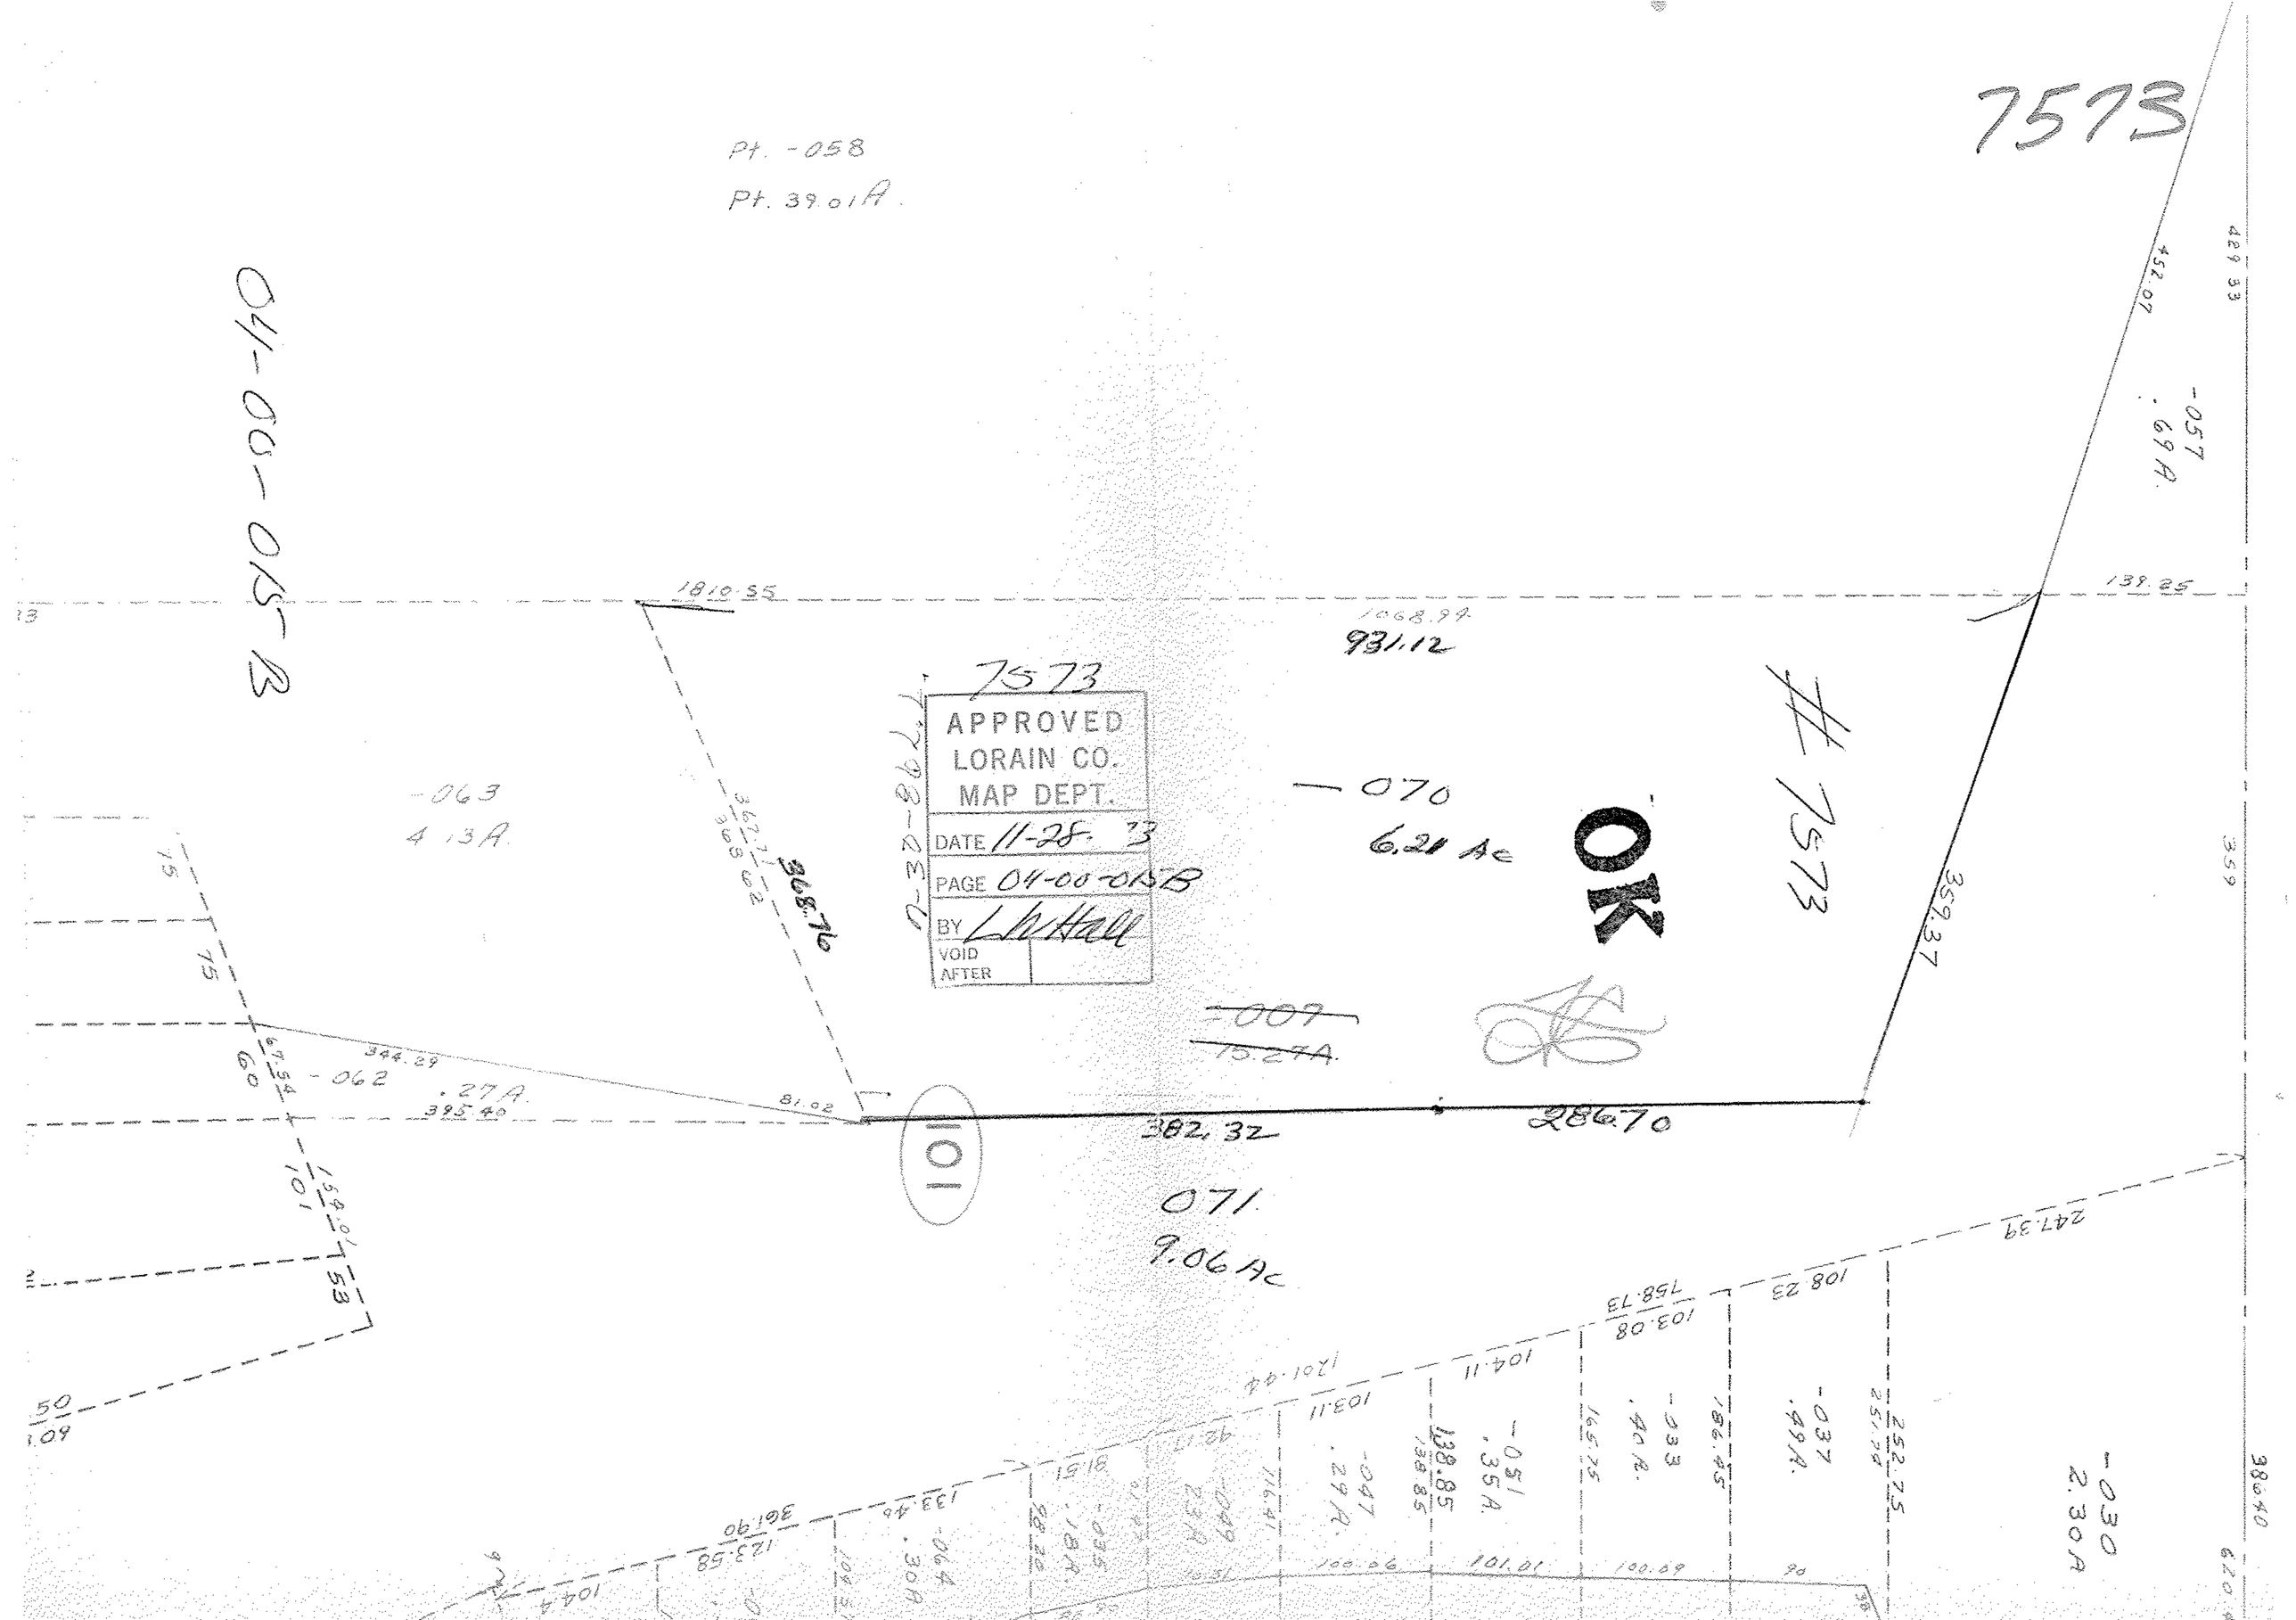
7573
Pt. -058
Pt. 39.01A
04-00-015 B
1810.55
1068.94
931.12
7573
APPROVED
LORAIN CO.
MAP DEPT.
DATE 11-28-73
PAGE 04-00-015B
BY L.W. Hall
VOID AFTER
-070
6.21 Ac
OK
7573
-063
4.13A
368.76
-007
15.27A
-062
.27A
344.29
395.40
81.02
382.32
286.70
101
071
9.06 Ac
-057
.69A
452.07
429.33
139.25
359.37
359
247.39
108.23
758.73
103.08
104.11
103.11
-030
2.30A
-037
.49A
-033
.40A
-051
.35A
-047
.29A
-064
.30A
123.58
361.90
133.46
104.4
100.06
101.01
100.09
90
386.40
620.